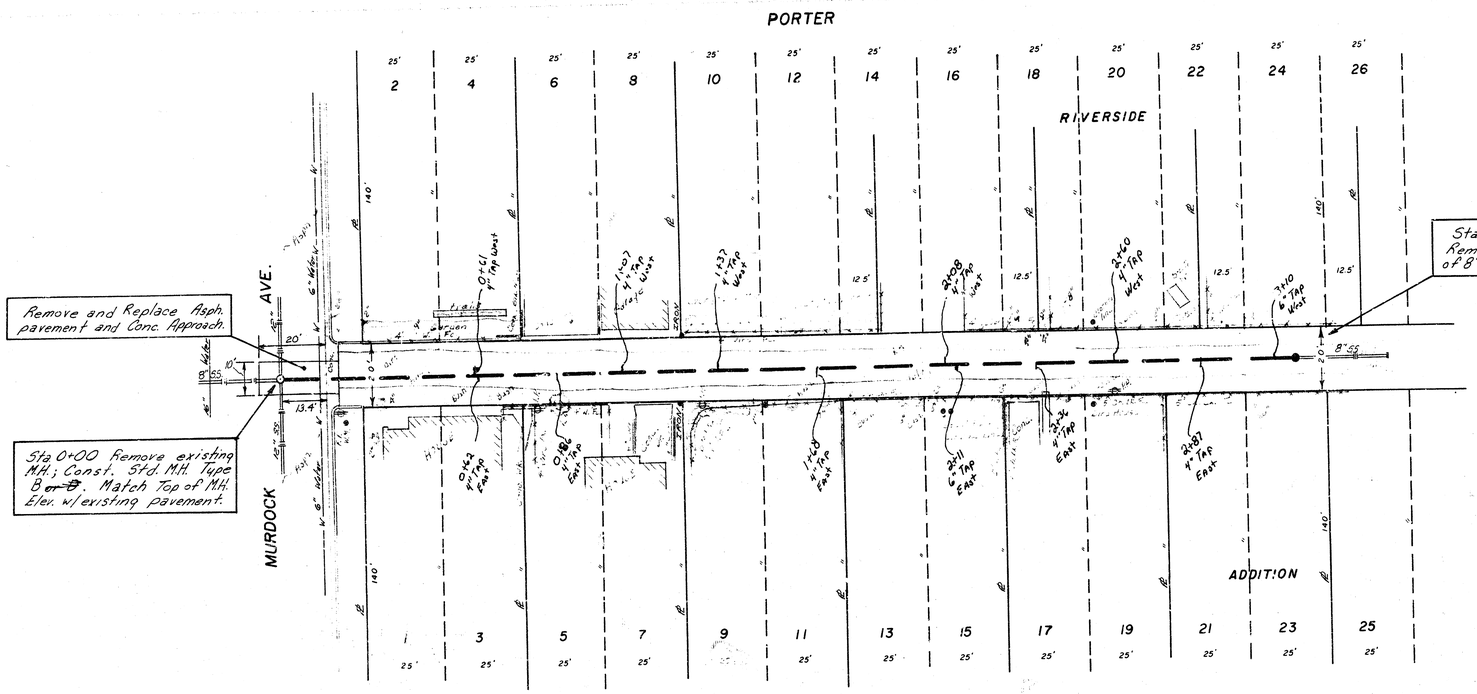


Notify Central Inspection (268-4341) for Service Connection Permits

Stationing for Service Connections As Booked (B-218)

0+36	West
0+38.5	East
0+60	West
0+62.5	East
0+86.5	East
1+07	West
1+36.5	East
1+60.5	East
2+06	West
2+28.5	East
2+60	West
2+87.5	East

Note: Notify Property Owners 48 hrs before construction begins.

N

SCALE 1" = 20' Plan
Horz 1" = 20' Profile
Vert 1" = 5'

Bench Marks - 115.61 Brass Rod in conc. post, 27' W. and 22.5' N. of ℄ Buffum and Franklin
120.19 RR. Spk., W. Fc. PP., E. Side of Alley between Porter and Lichfield, 4th PP N. Side Murdock
117.03 RR. Spk., W. Fc. PP., E. Side Alley between Porter and Lichfield, 1st PP N. Side Murdock

As Built
J.L.L.
5/82

DONALD E. SCHNEIDER — LICENSED — 6311 — KANSAS — PROFESSIONAL ENGINEER

RECONSTUCTION OF A PORTION OF S.S. NO. 15, BETWEEN PORTER & LITCHFIELD ON N.S. OF MURDOCK.

CITY OF WICHITA, KANSAS
R. W. BRUGGEMAN
DIRECTOR OF ENGINEERING / CITY ENGINEER
PROJ. NO. 468-76-245-81167-000-000-001
DATE _____ SHEET 1 OF 1