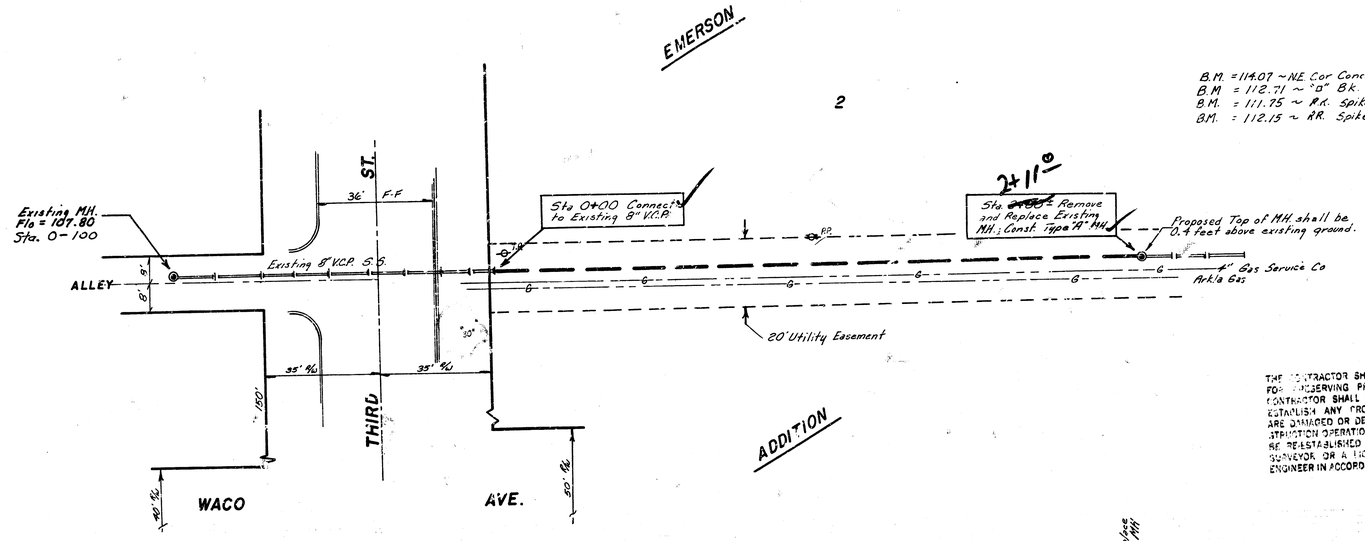

N

Scale: 1"=20' Plan.
Horz. 1"=20' Profile
Vert. 1"= 5'

B.M. = 114.07 ~ NE Cor Conc. Base RR Signal Box, SW. Cor. 3rd & Wichita.
B.M. = 112.71 ~ "O" Bk. Wk. N.L. 3rd St., 5' E. of E.L. Main.
B.M. = 111.75 ~ RR. Spike in PP. N. Side, S.E. Cor. Waco & 3rd.
B.M. = 112.15 ~ RR. Spike, N. Fc. PP., S.W. Cor. 3rd & Riverview

Note: Contact Gas Companies" 24 hr. Notice for location of Gas lines and service connections before starting construction.

THE CONTRACTOR SHALL BE RESPONSIBLE FOR PRESERVING PROPERTY IRONS. THE CONTRACTOR SHALL BE REQUIRED TO RE-ESTABLISH ANY PROPERTY IRONS WHICH ARE DAMAGED OR DESTROYED BY HIS CONSTRUCTION OPERATIONS. SUCH IRONS SHALL BE RE-ESTABLISHED BY A LICENSED LAND SURVEYOR OR A LICENSED PROFESSIONAL ENGINEER IN ACCORDANCE WITH STATE LAWS.

CAUTION
UNDERGROUND UTILITIES
Please check with K G & E or Southwestern Bell Telephone Co. for Location

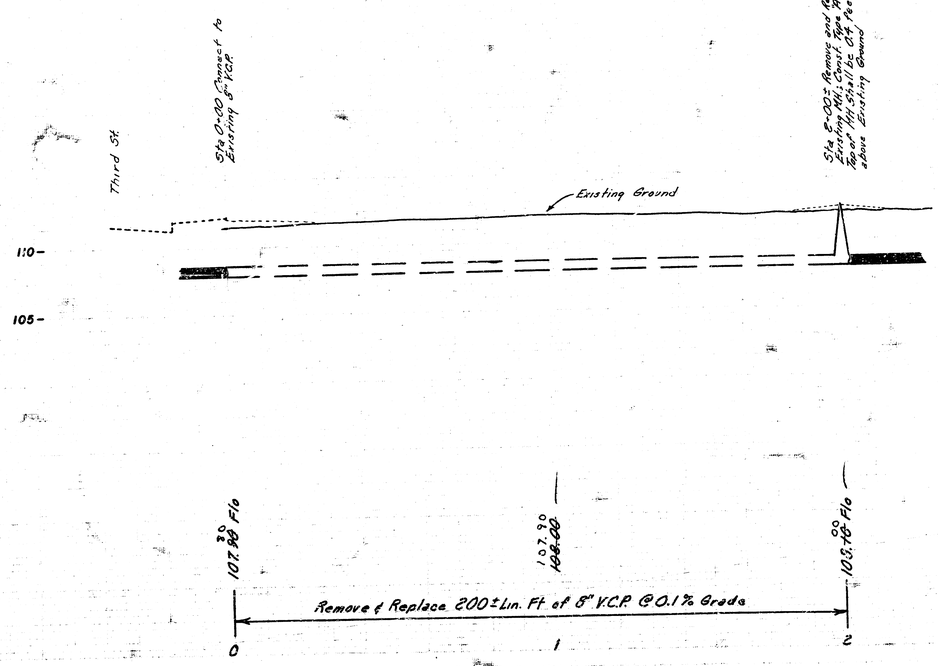

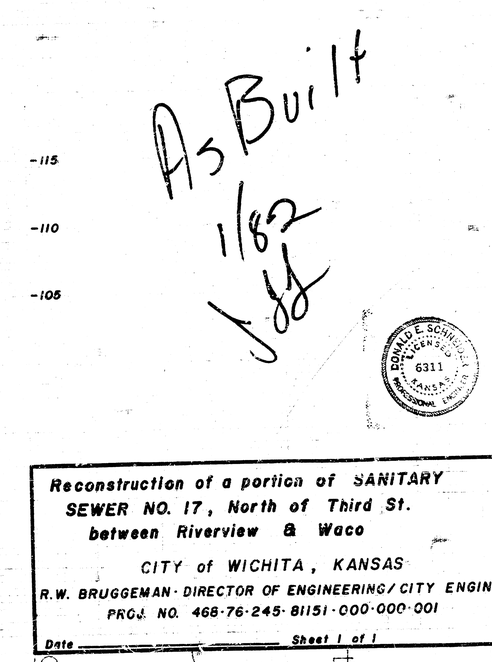

As Built
1/82
JSB

DONALD E. SCHNEIDER
LICENSED
6311
KANSAS
PROFESSIONAL ENGINEER

Reconstruction of a portion of SANITARY SEWER NO. 17, North of Third St. between Riverview & Waco

CITY of WICHITA, KANSAS
R.W. BRUGGEMAN · DIRECTOR OF ENGINEERING / CITY ENGINEER
PROJ. NO. 468-76-245-81151-000-000-001
Date _____ Sheet 1 of 1

FILMED FROM THE BEST AVAILABLE COPY.....