

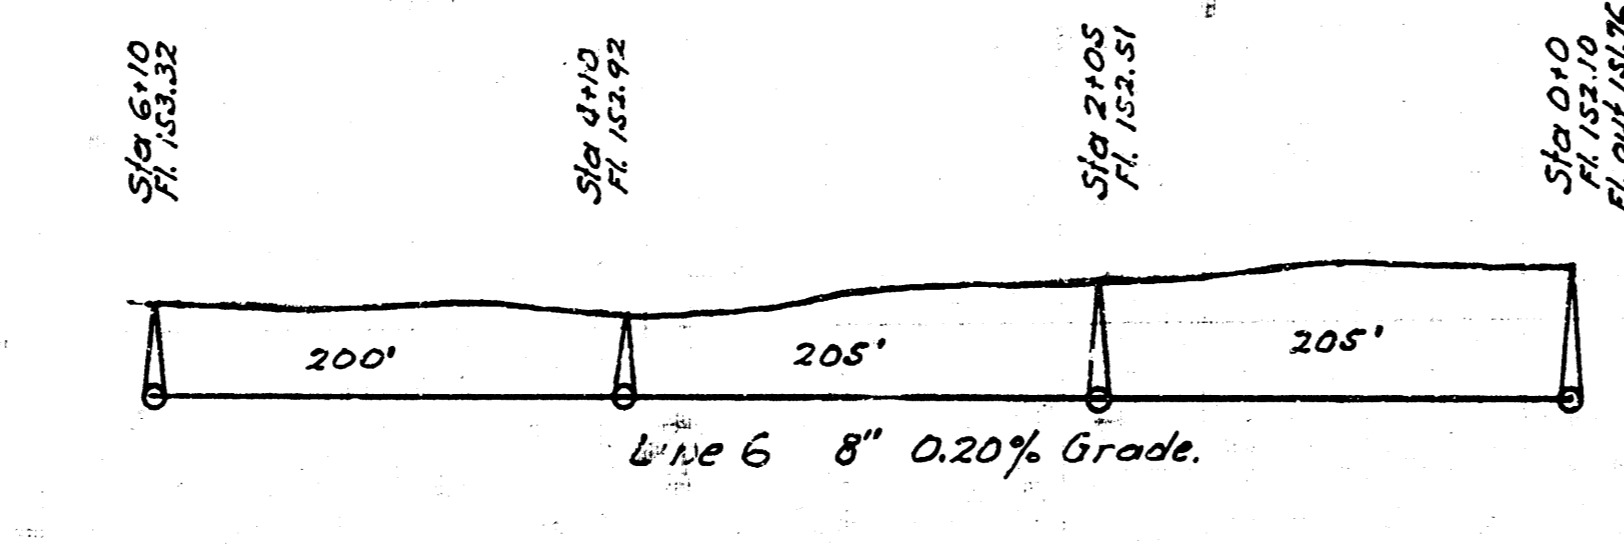
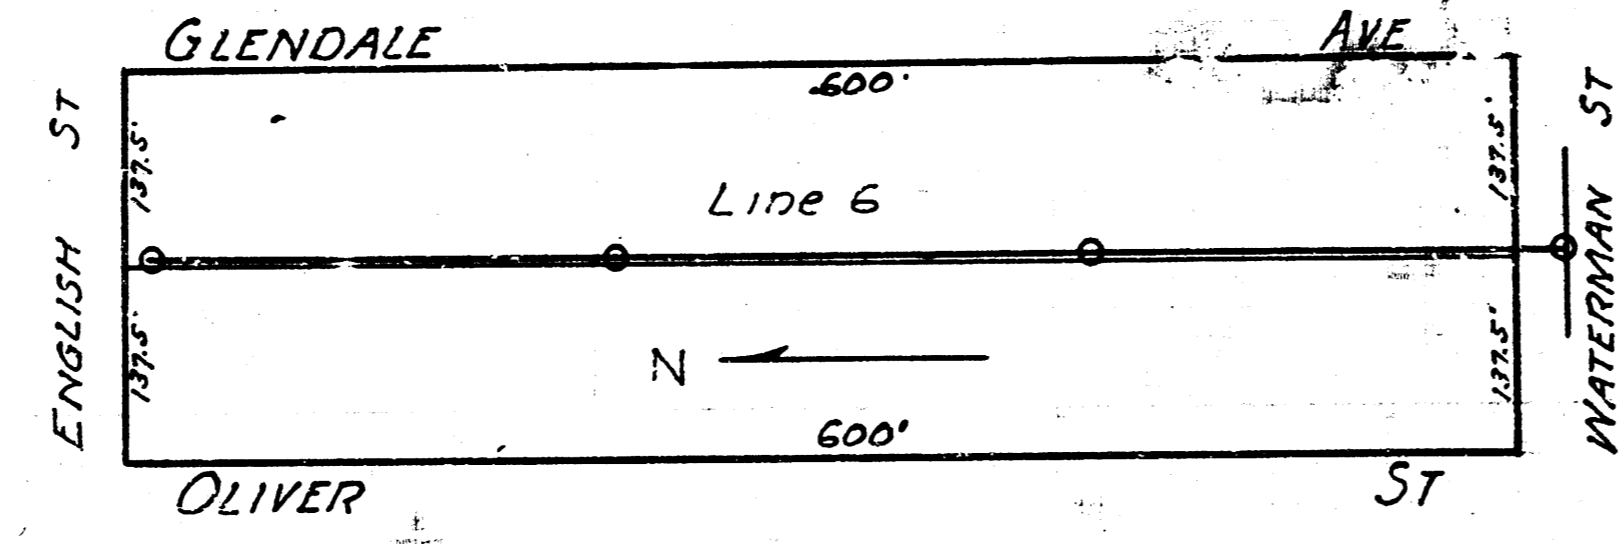
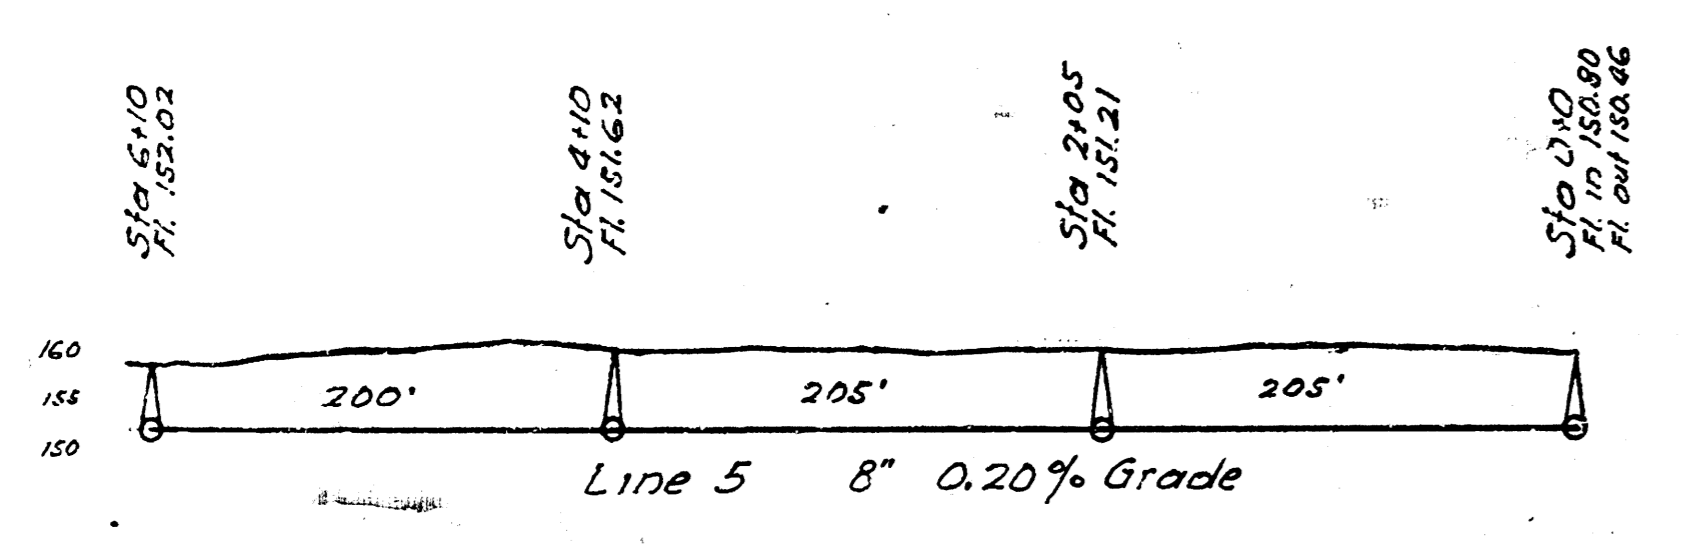
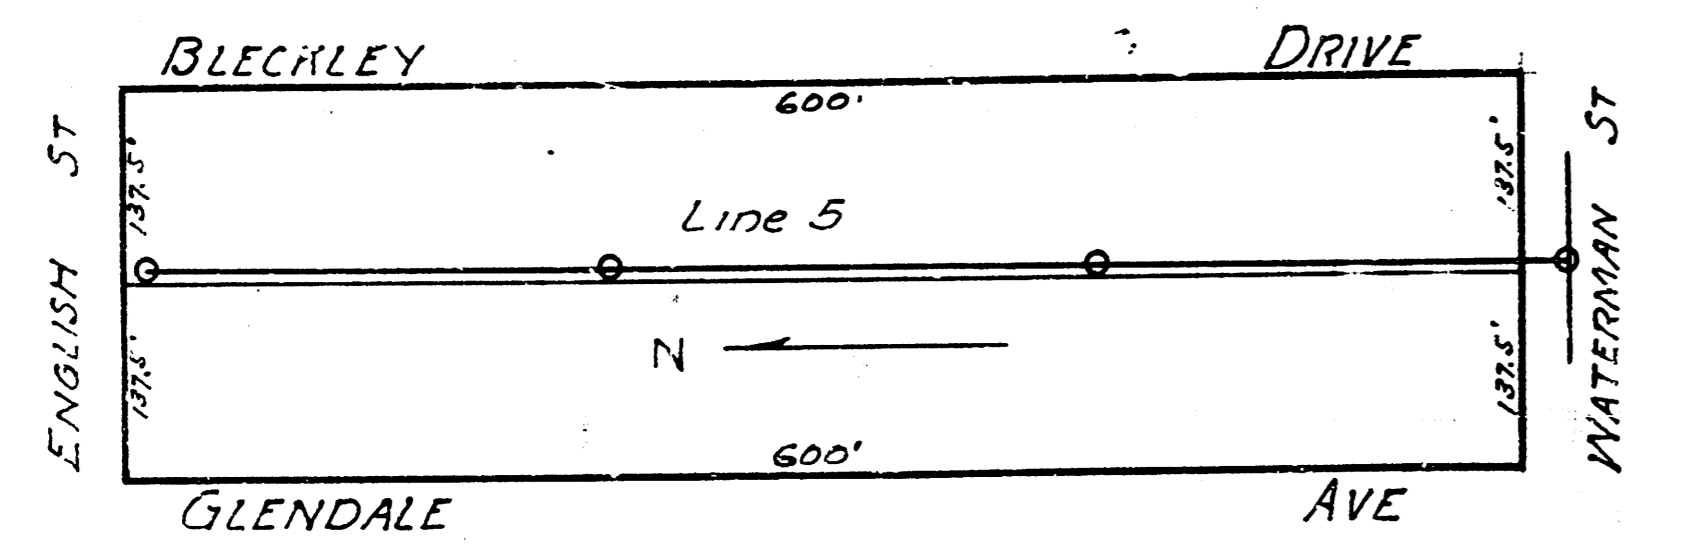
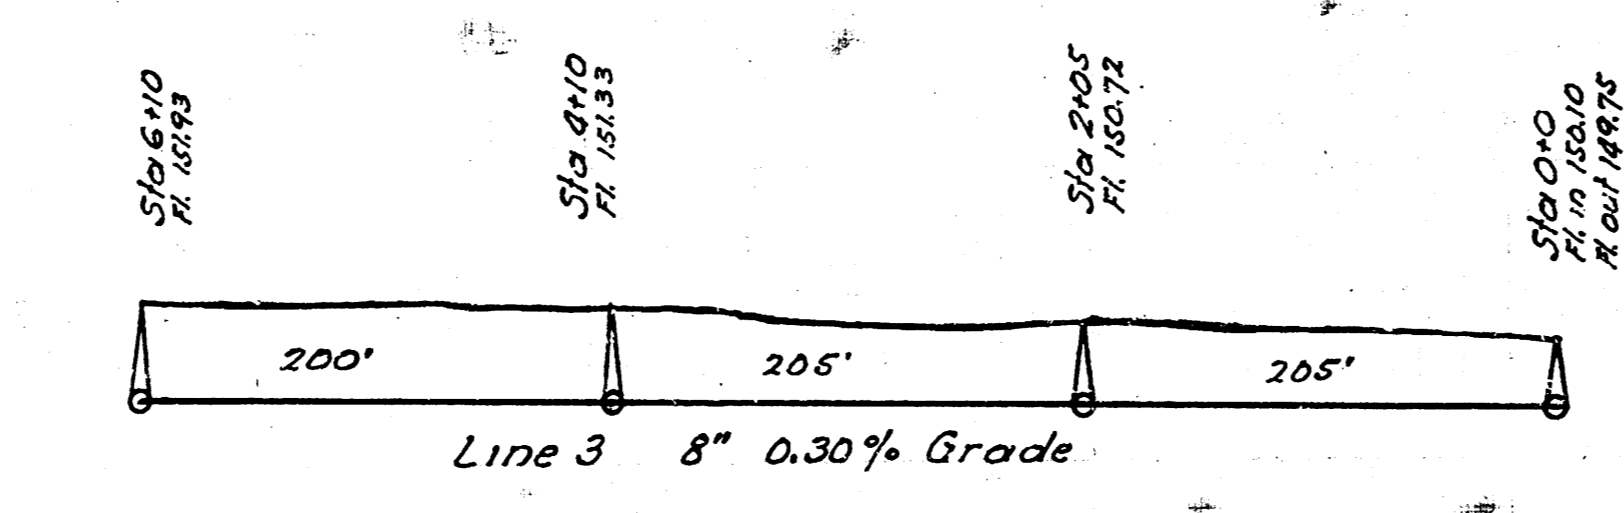
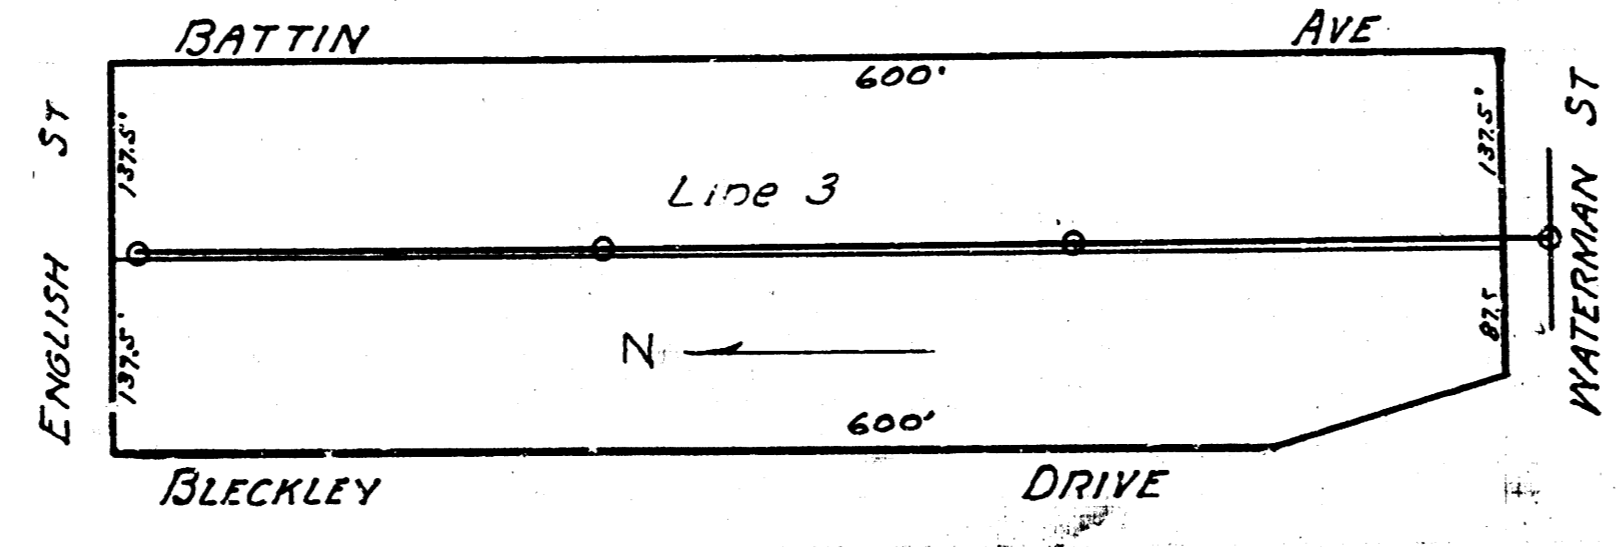
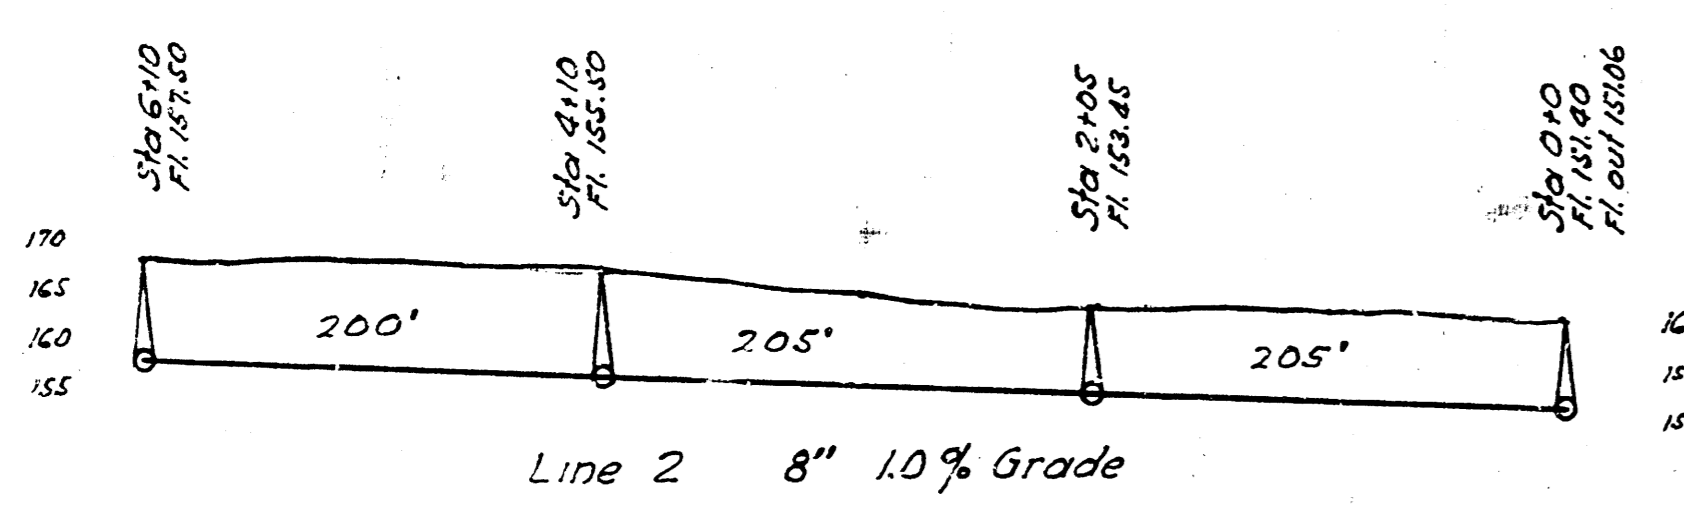
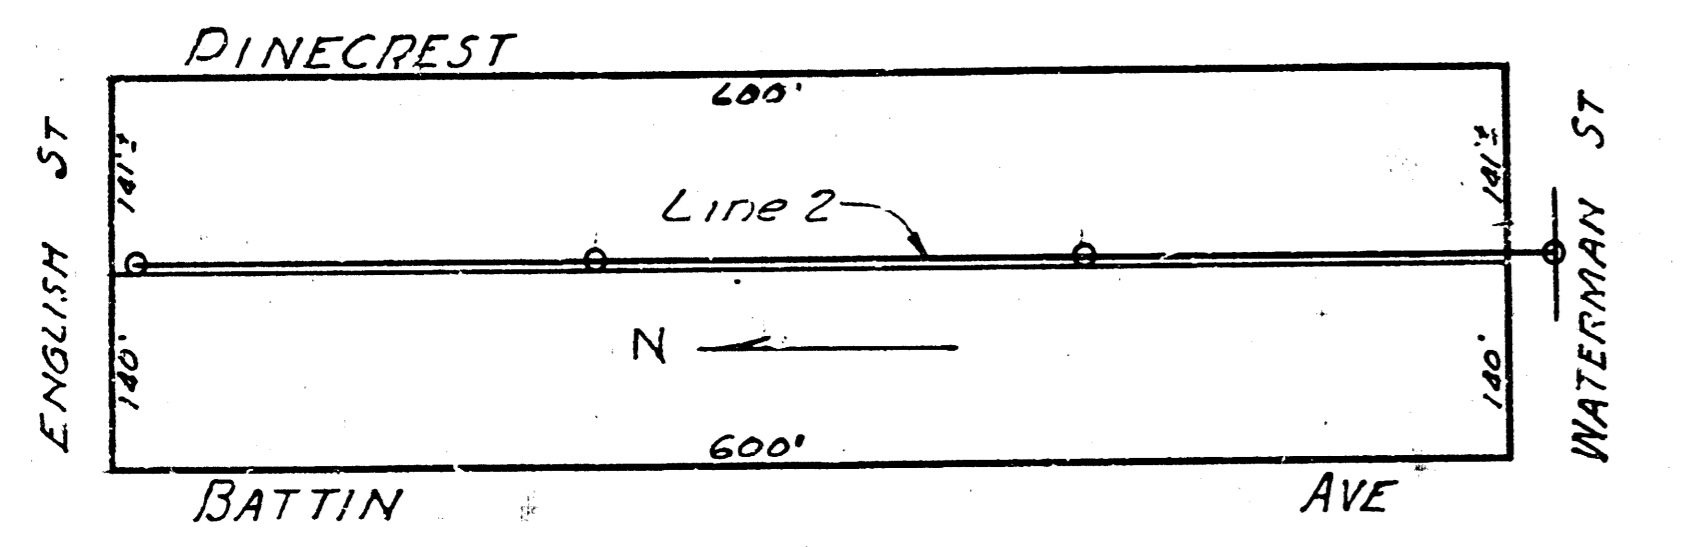


**LAT. M
DIST. # 6
S.S. # 12**

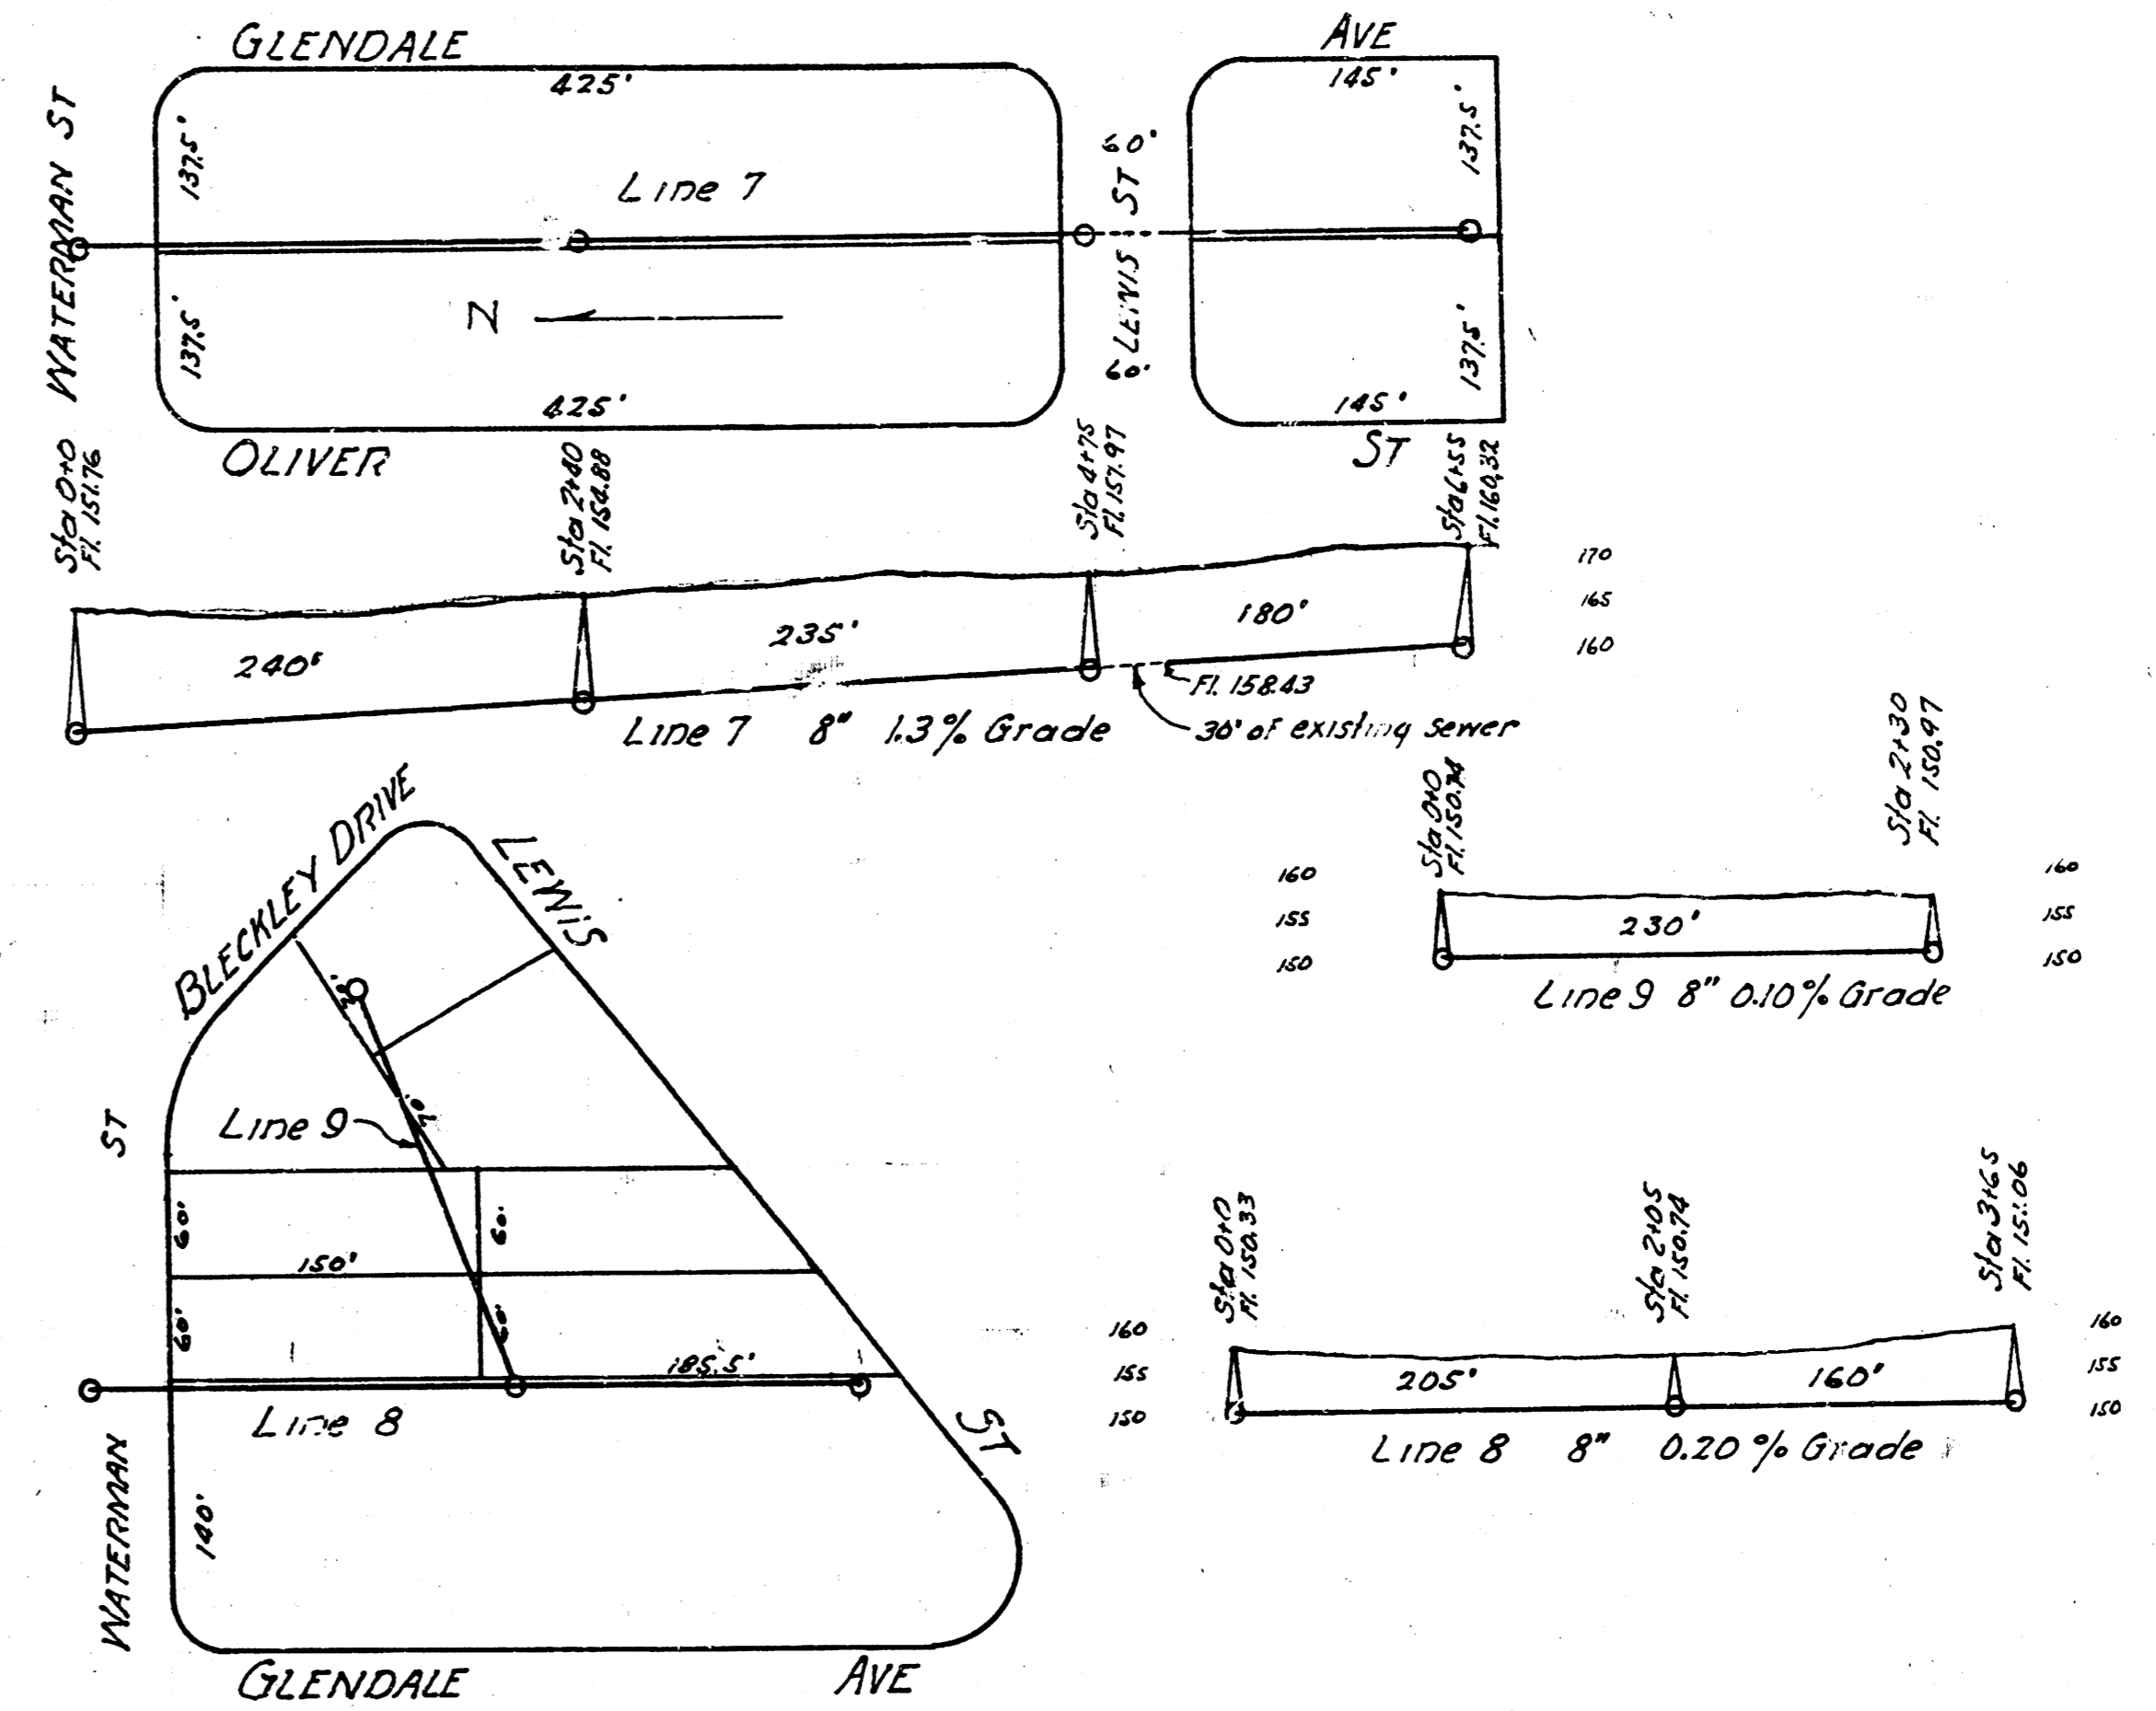

B.M. Elev. 156.07 Top of Man N.W. Cor. Waterman & Bleckley Drive.
162.67 Iron end of radius W. S.W. Glendale & Waterman

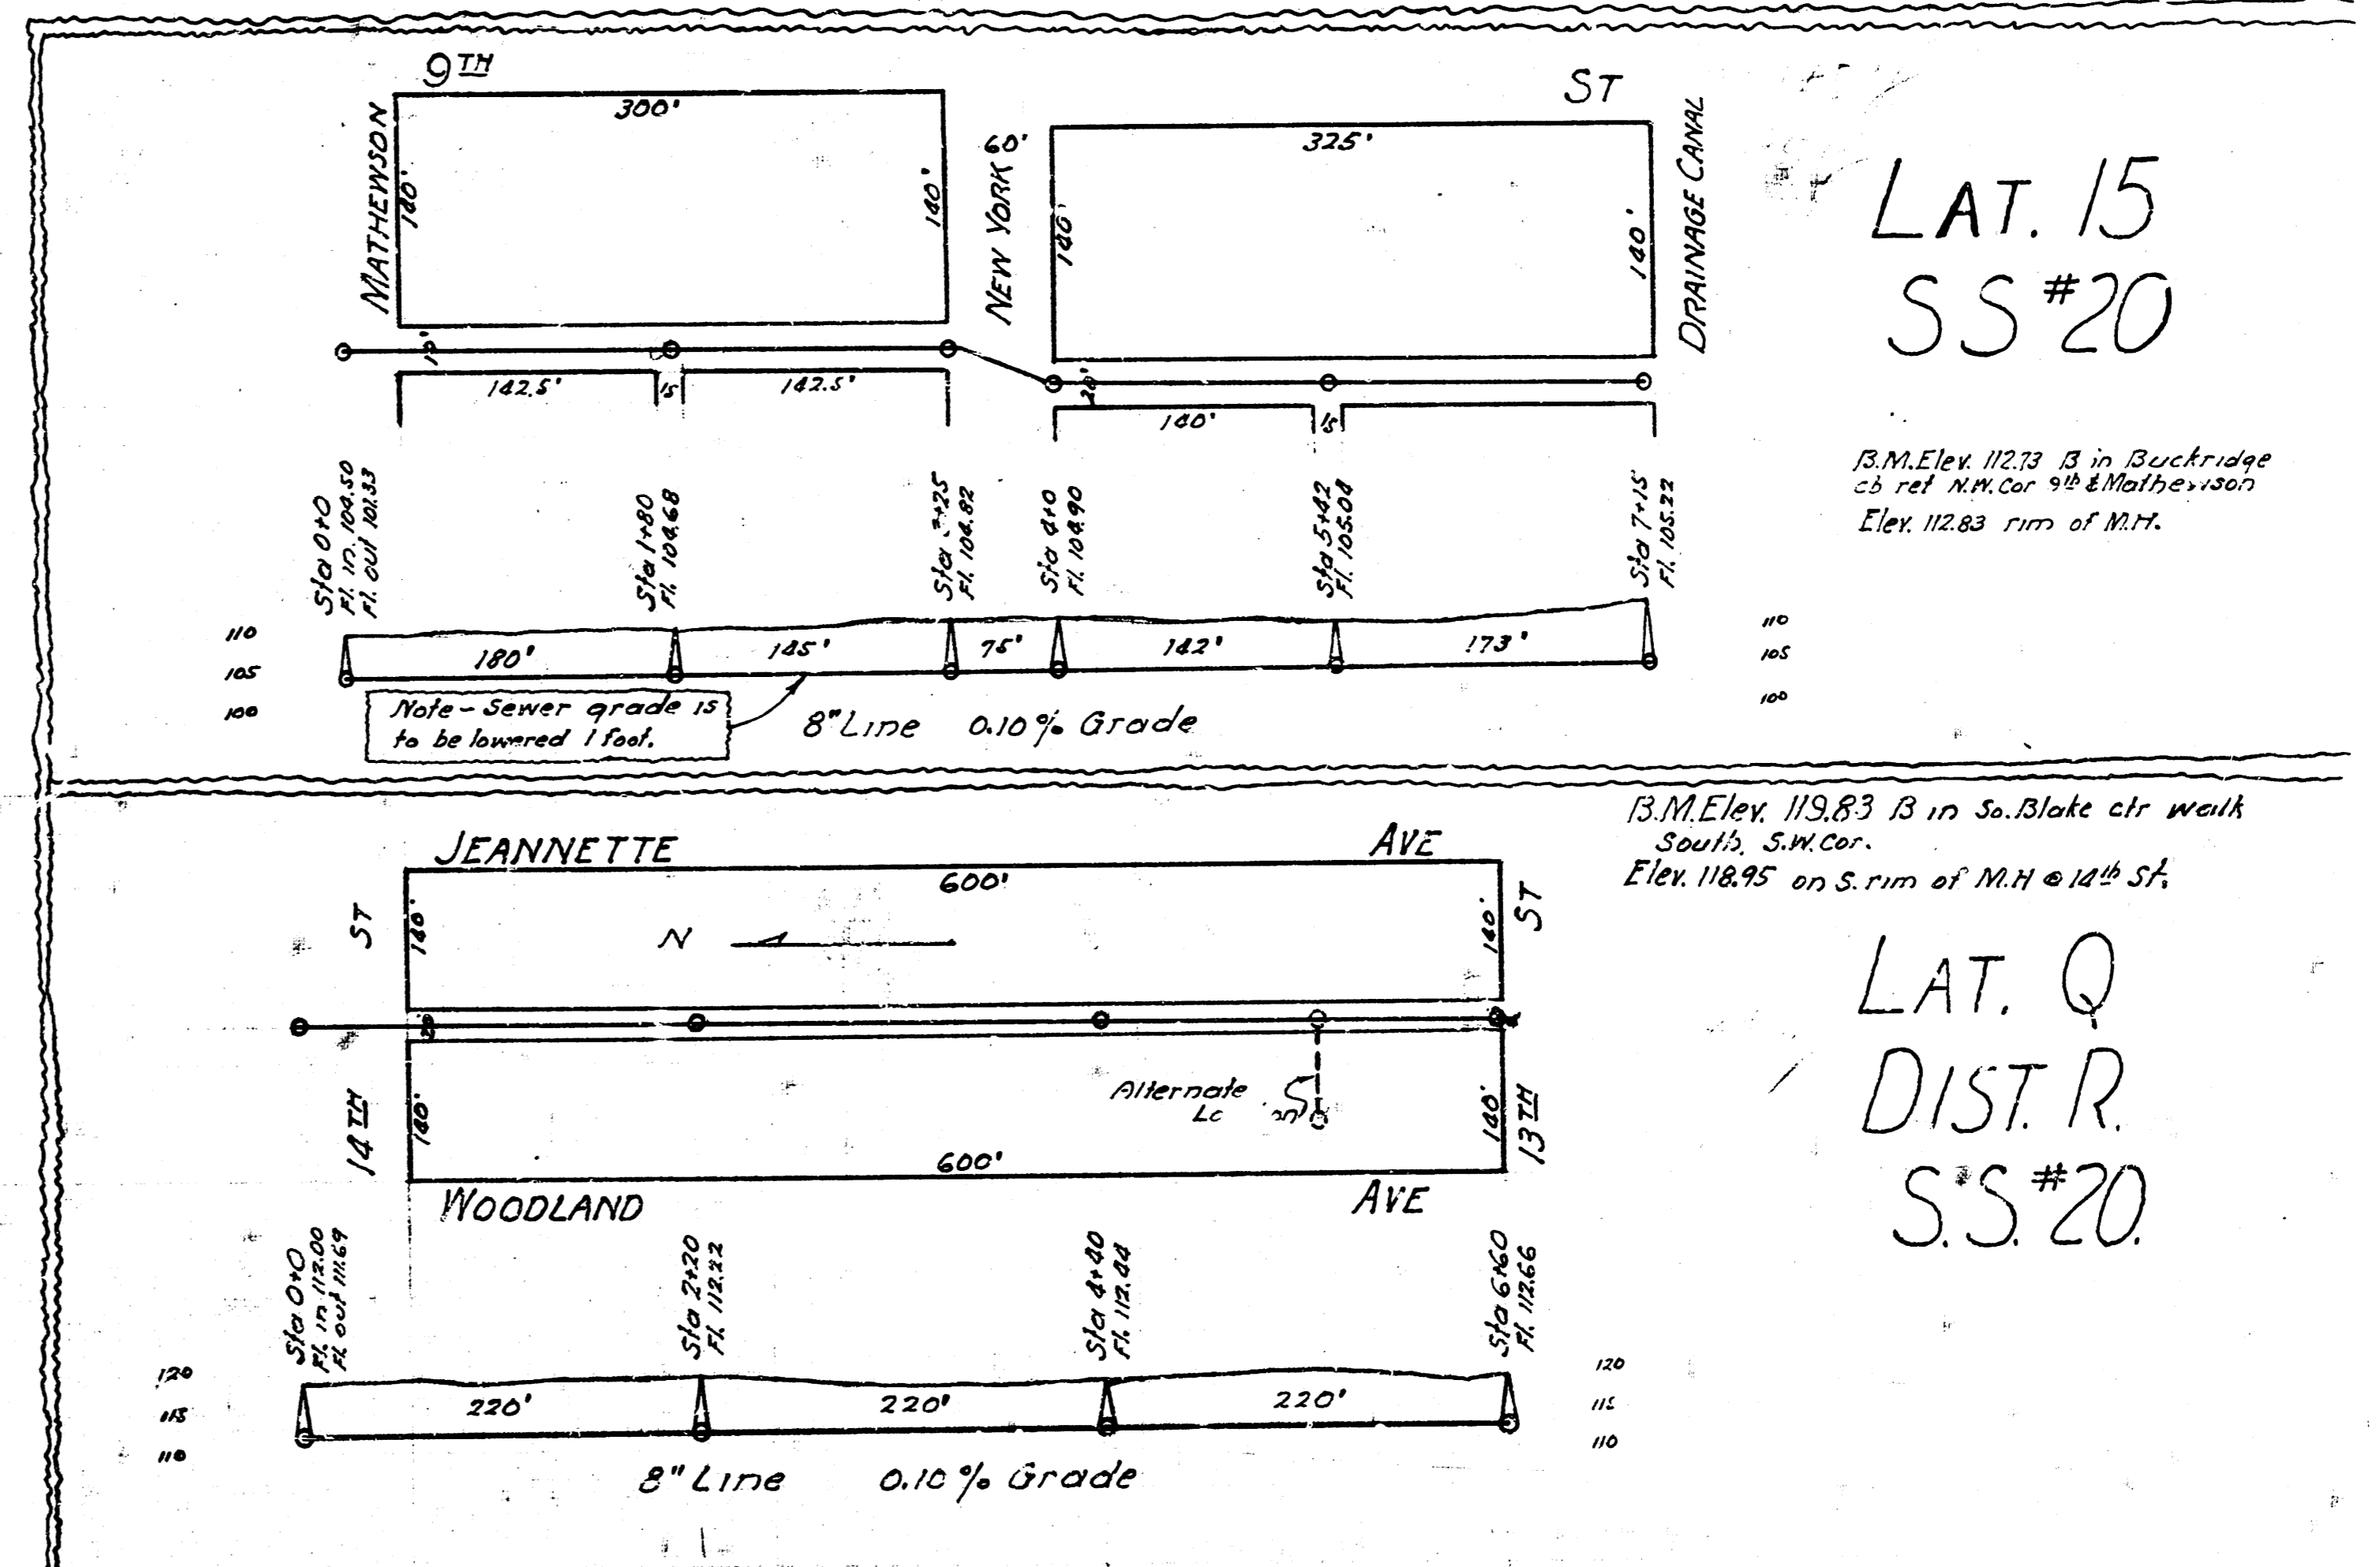

**LAT. 15
S.S. # 20**

B.M. Elev. 112.73 B in Buckridge
Elev. 112.83 rim of M.H.

B.M. Elev. 119.83 B in So. Blake ctr walk

**LAT. Q
DIST. R.
S.S. # 20**