

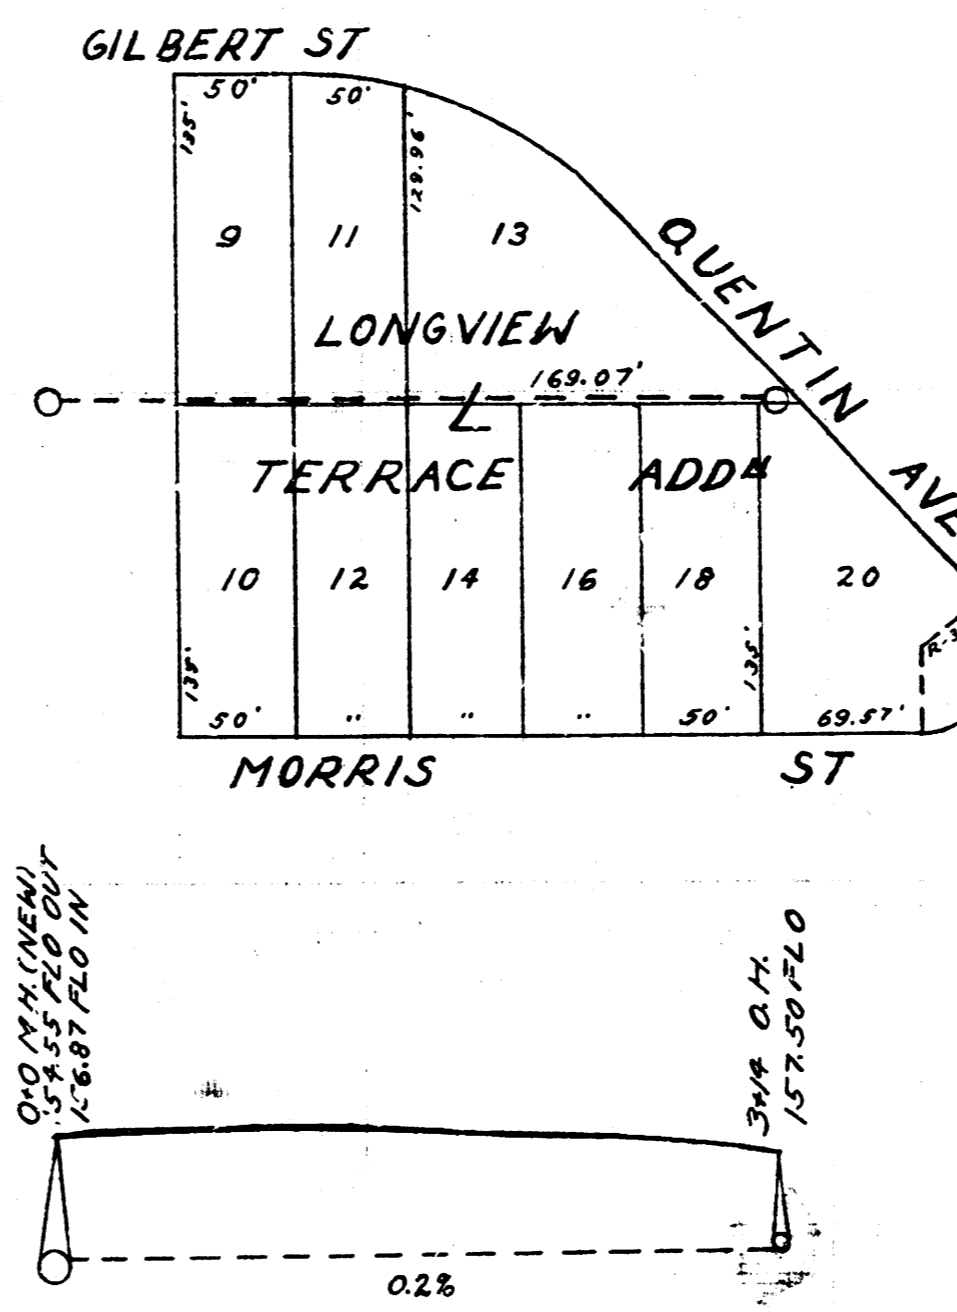


LAT 23 S.S. #20

LAT 5 DIST 6 S.S. #12

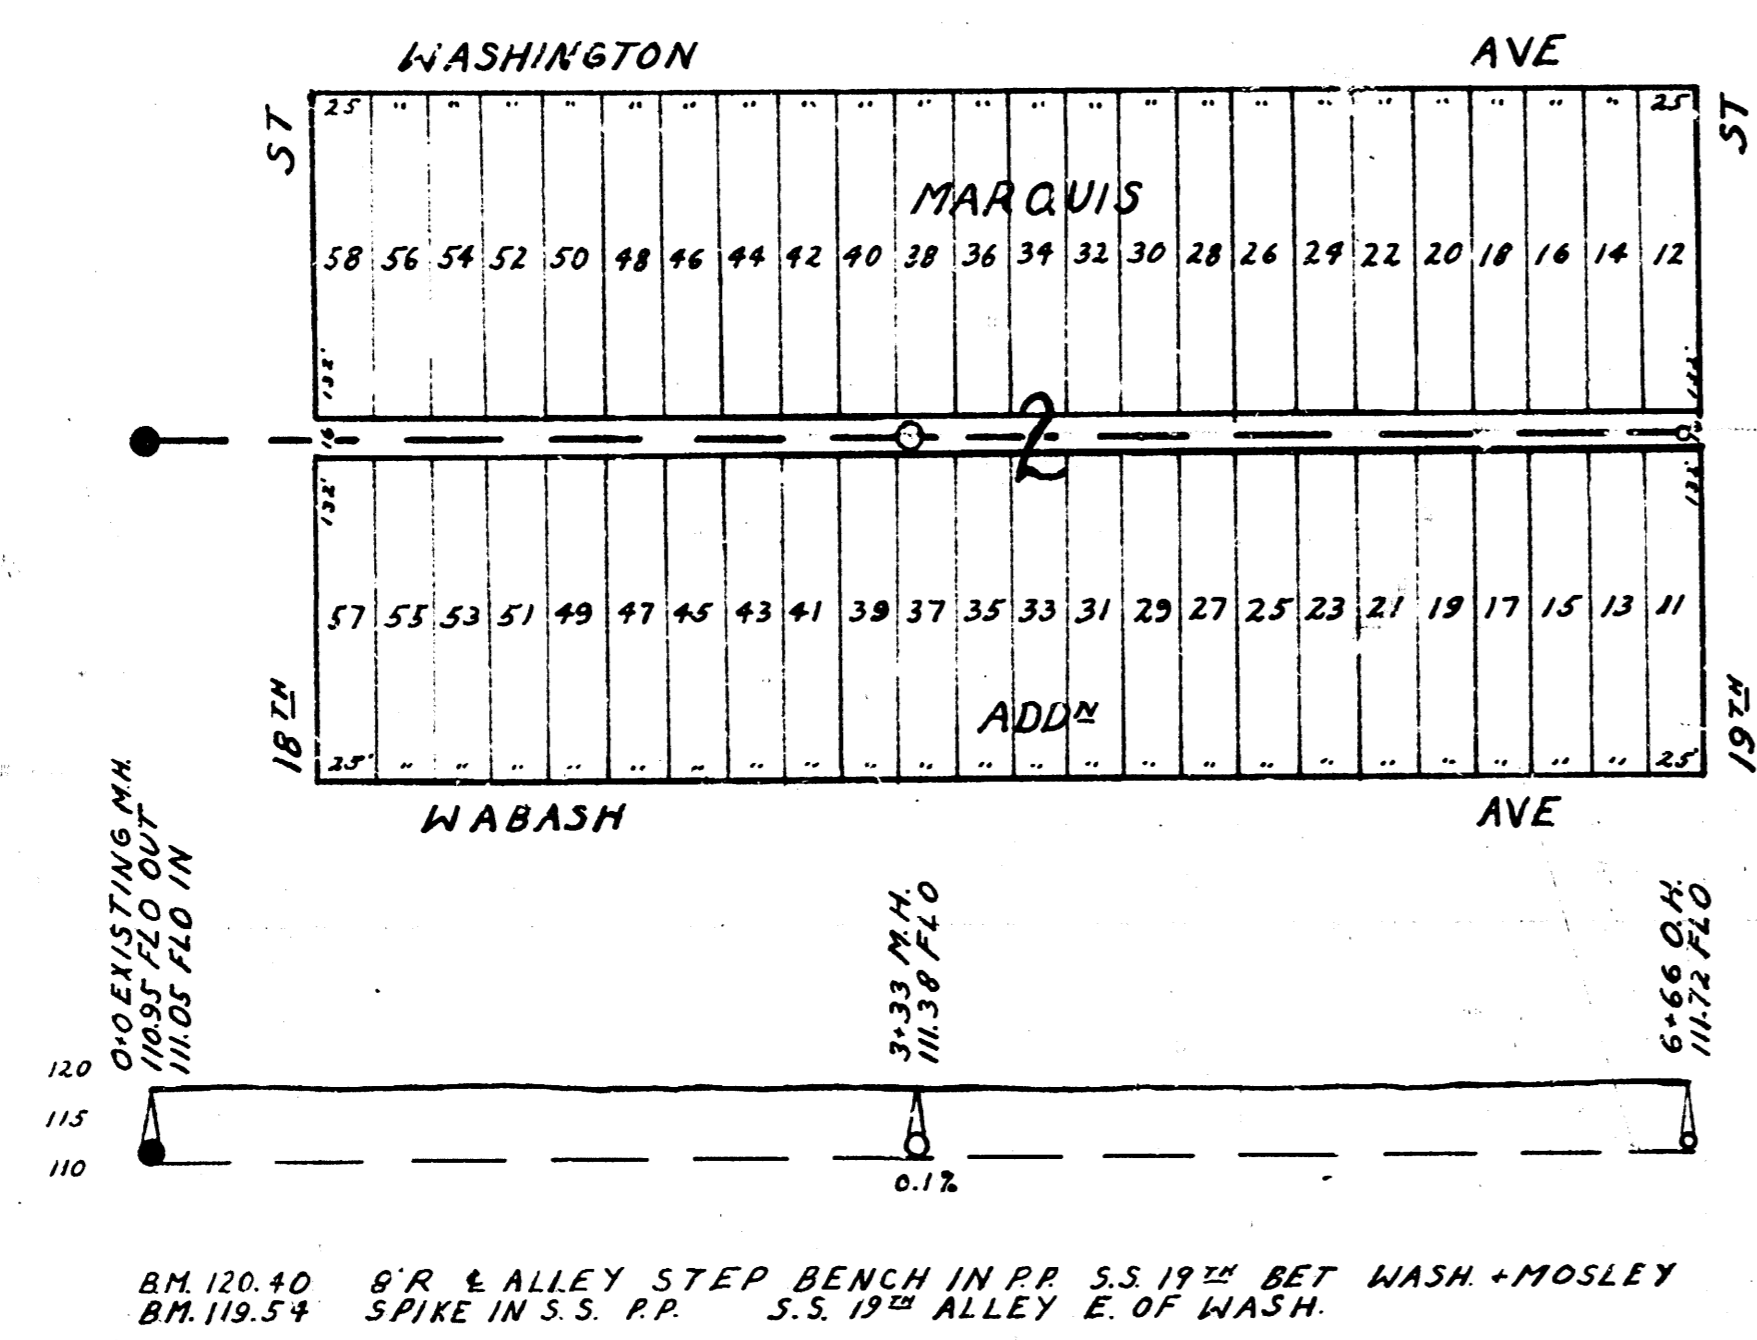

LAT 21 DIST A S.S. #21

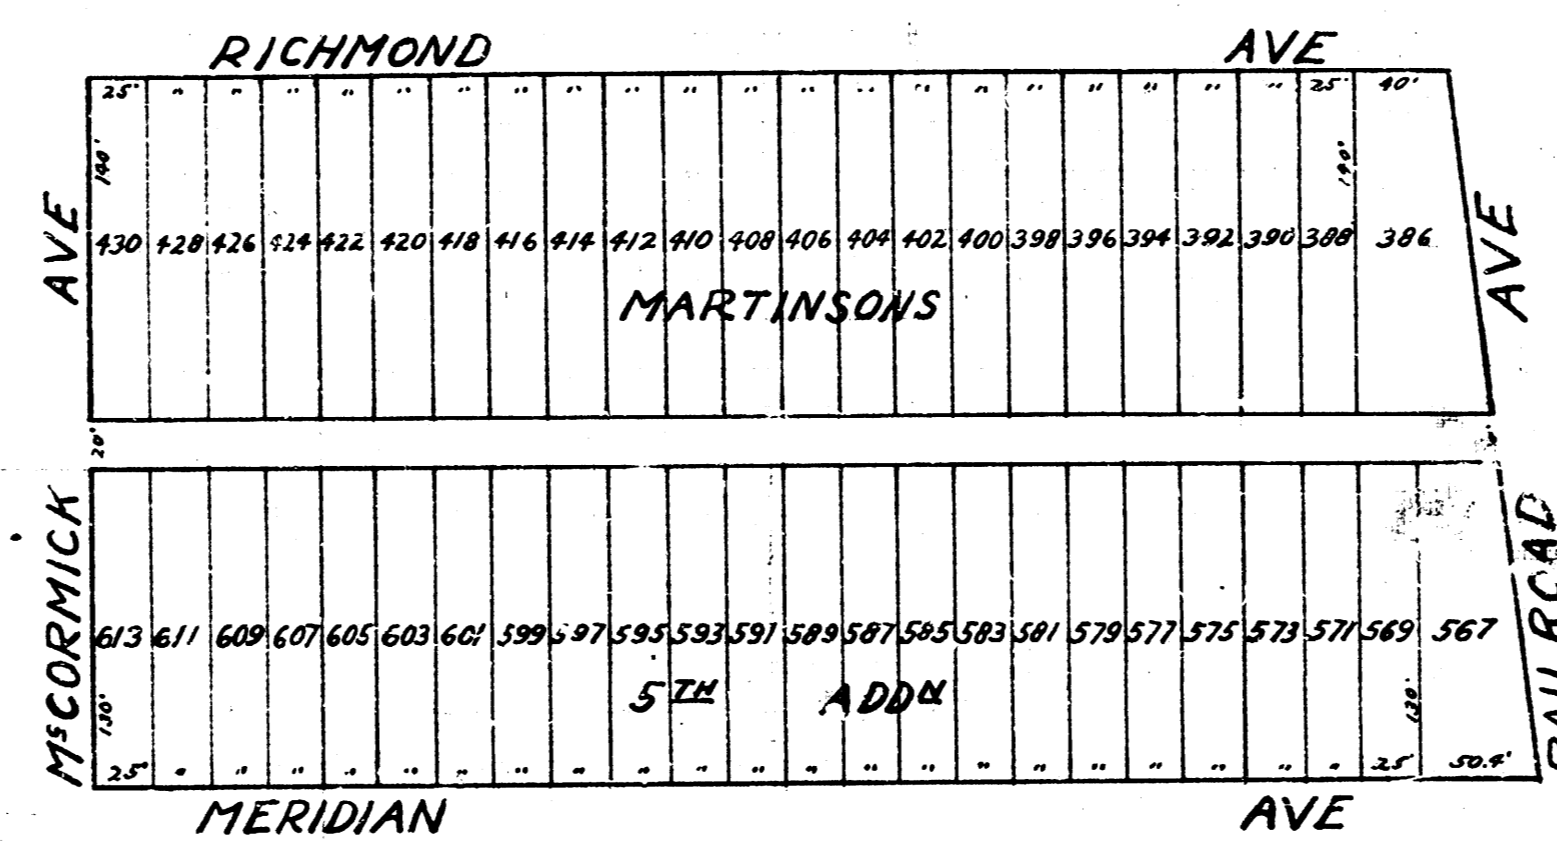

CITY OF WICHITA, KANSAS  
PUBLIC SERVICE DEPARTMENT  
ENGINEERING DIVISION  
L.K. WHITE, CITY ENGINEER  
DRAWN BY L.K. SUHM NOV. 1945