



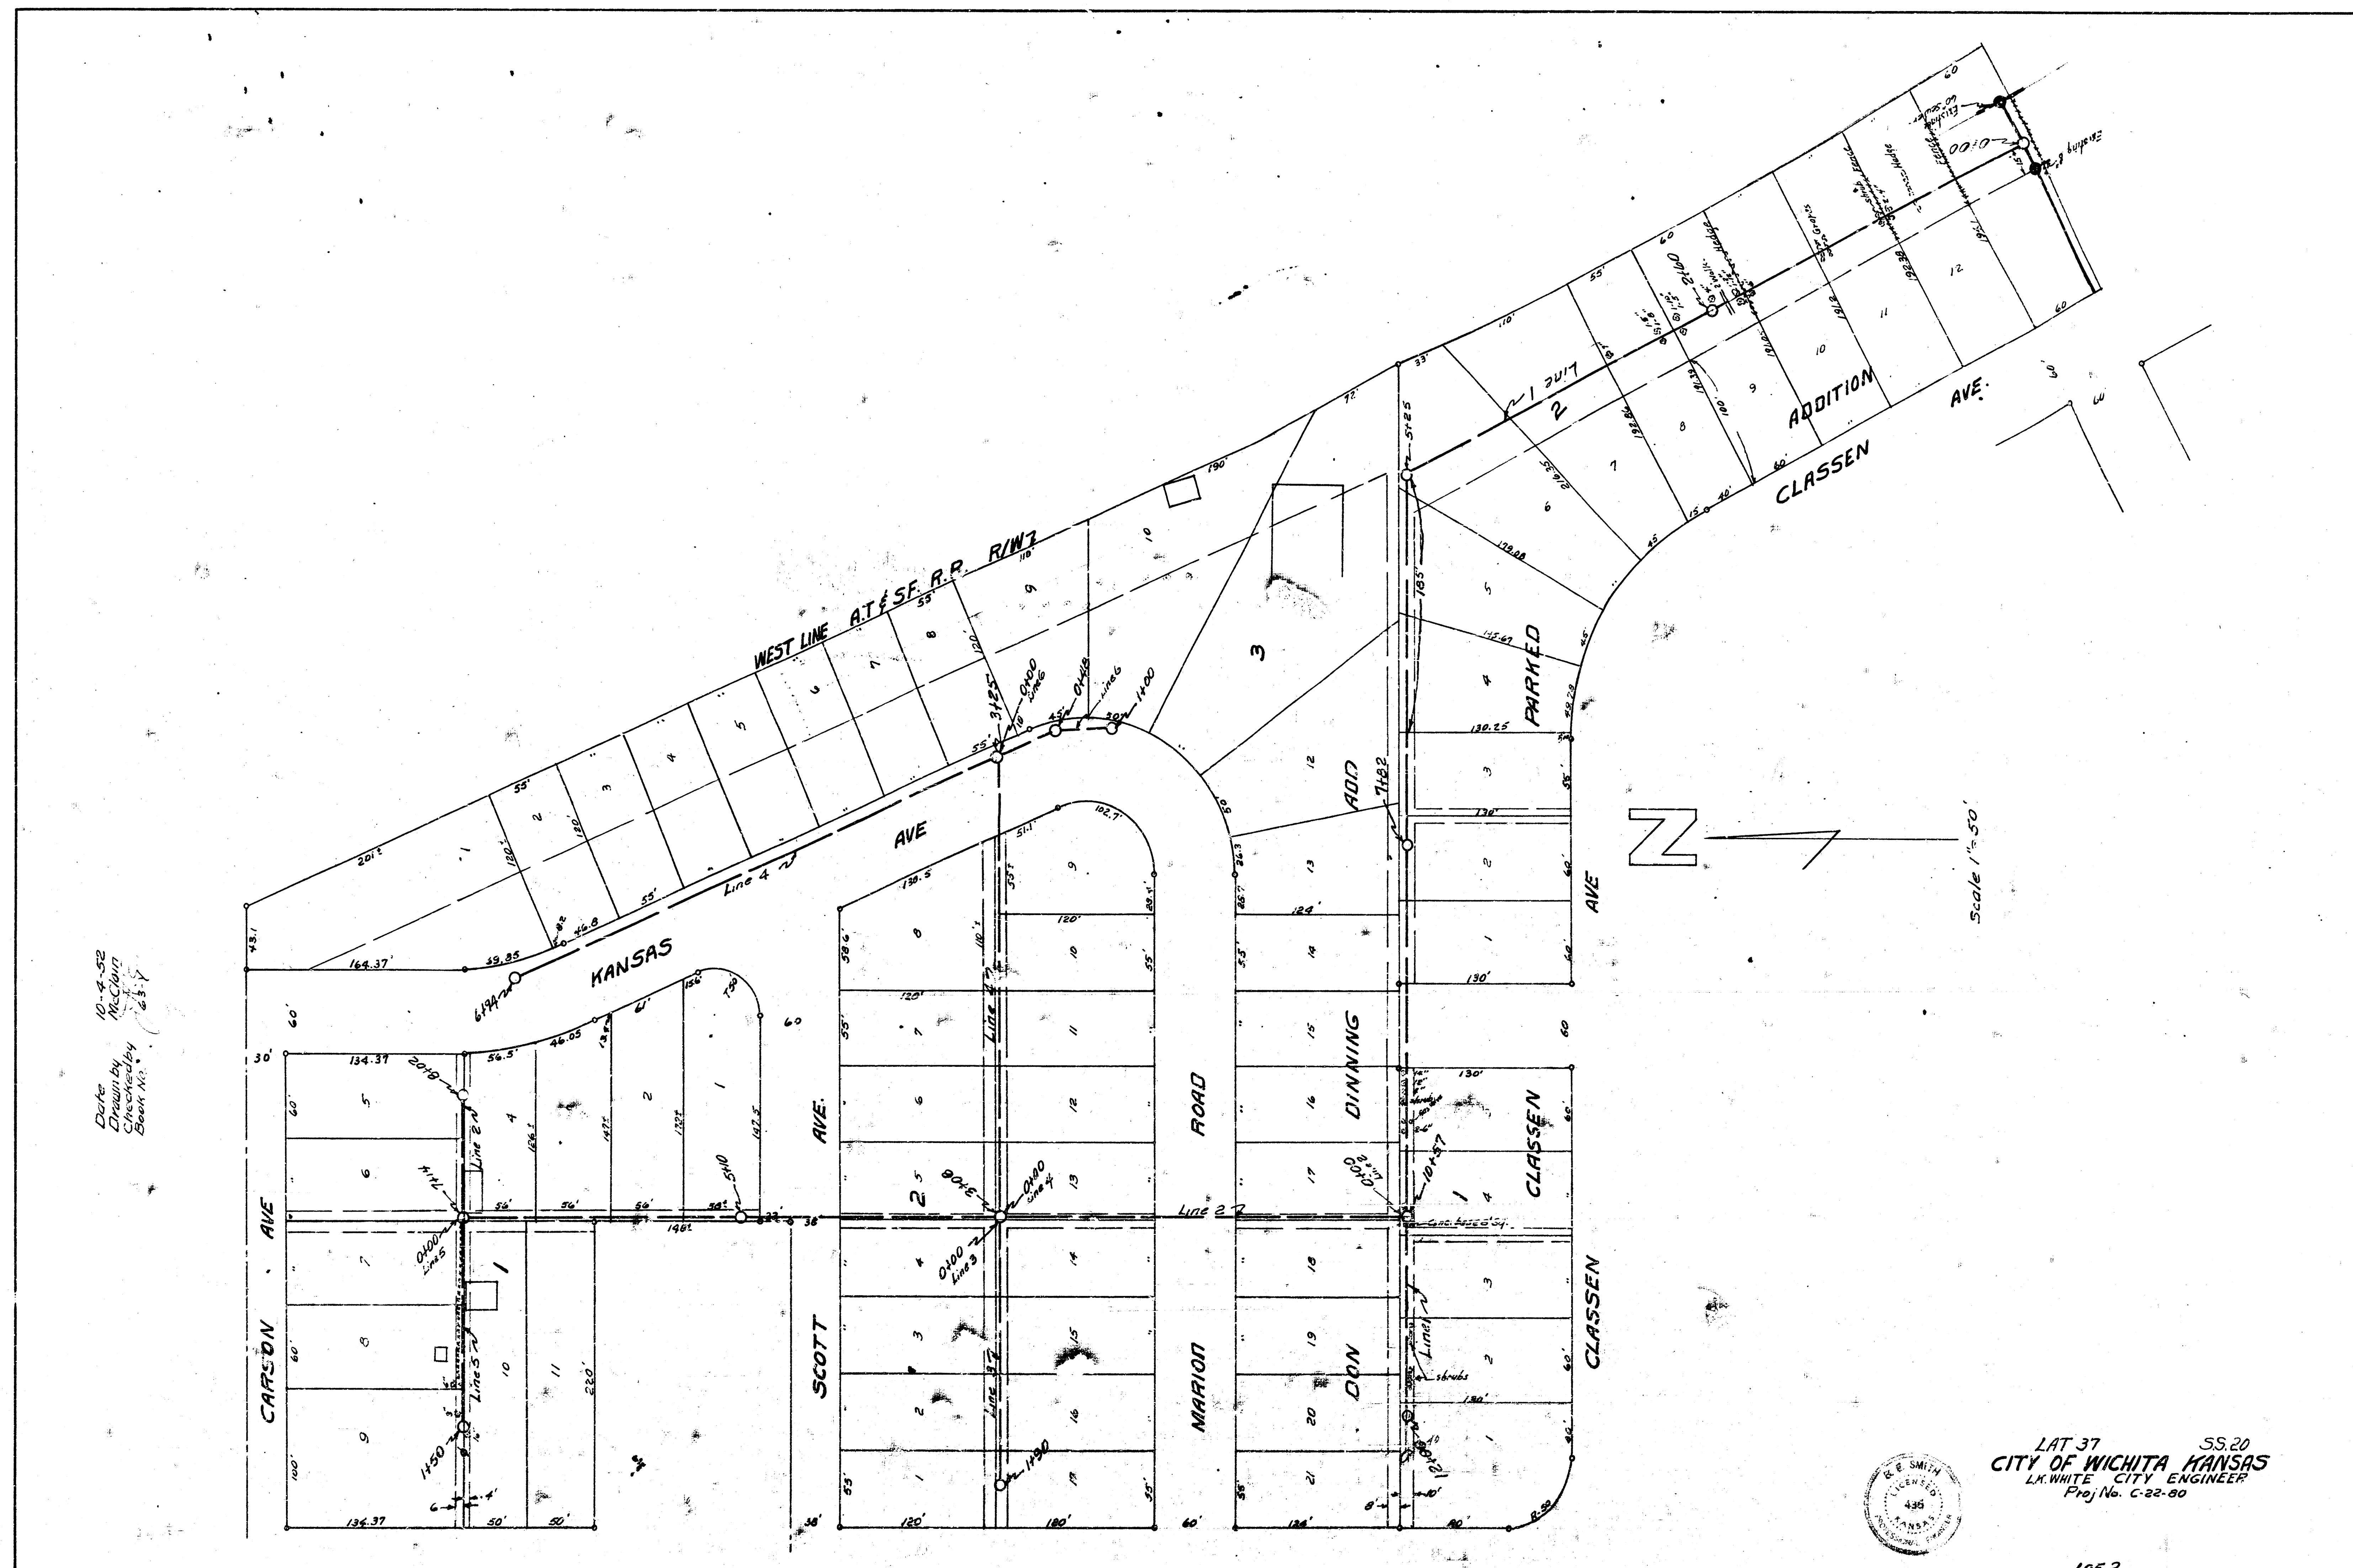


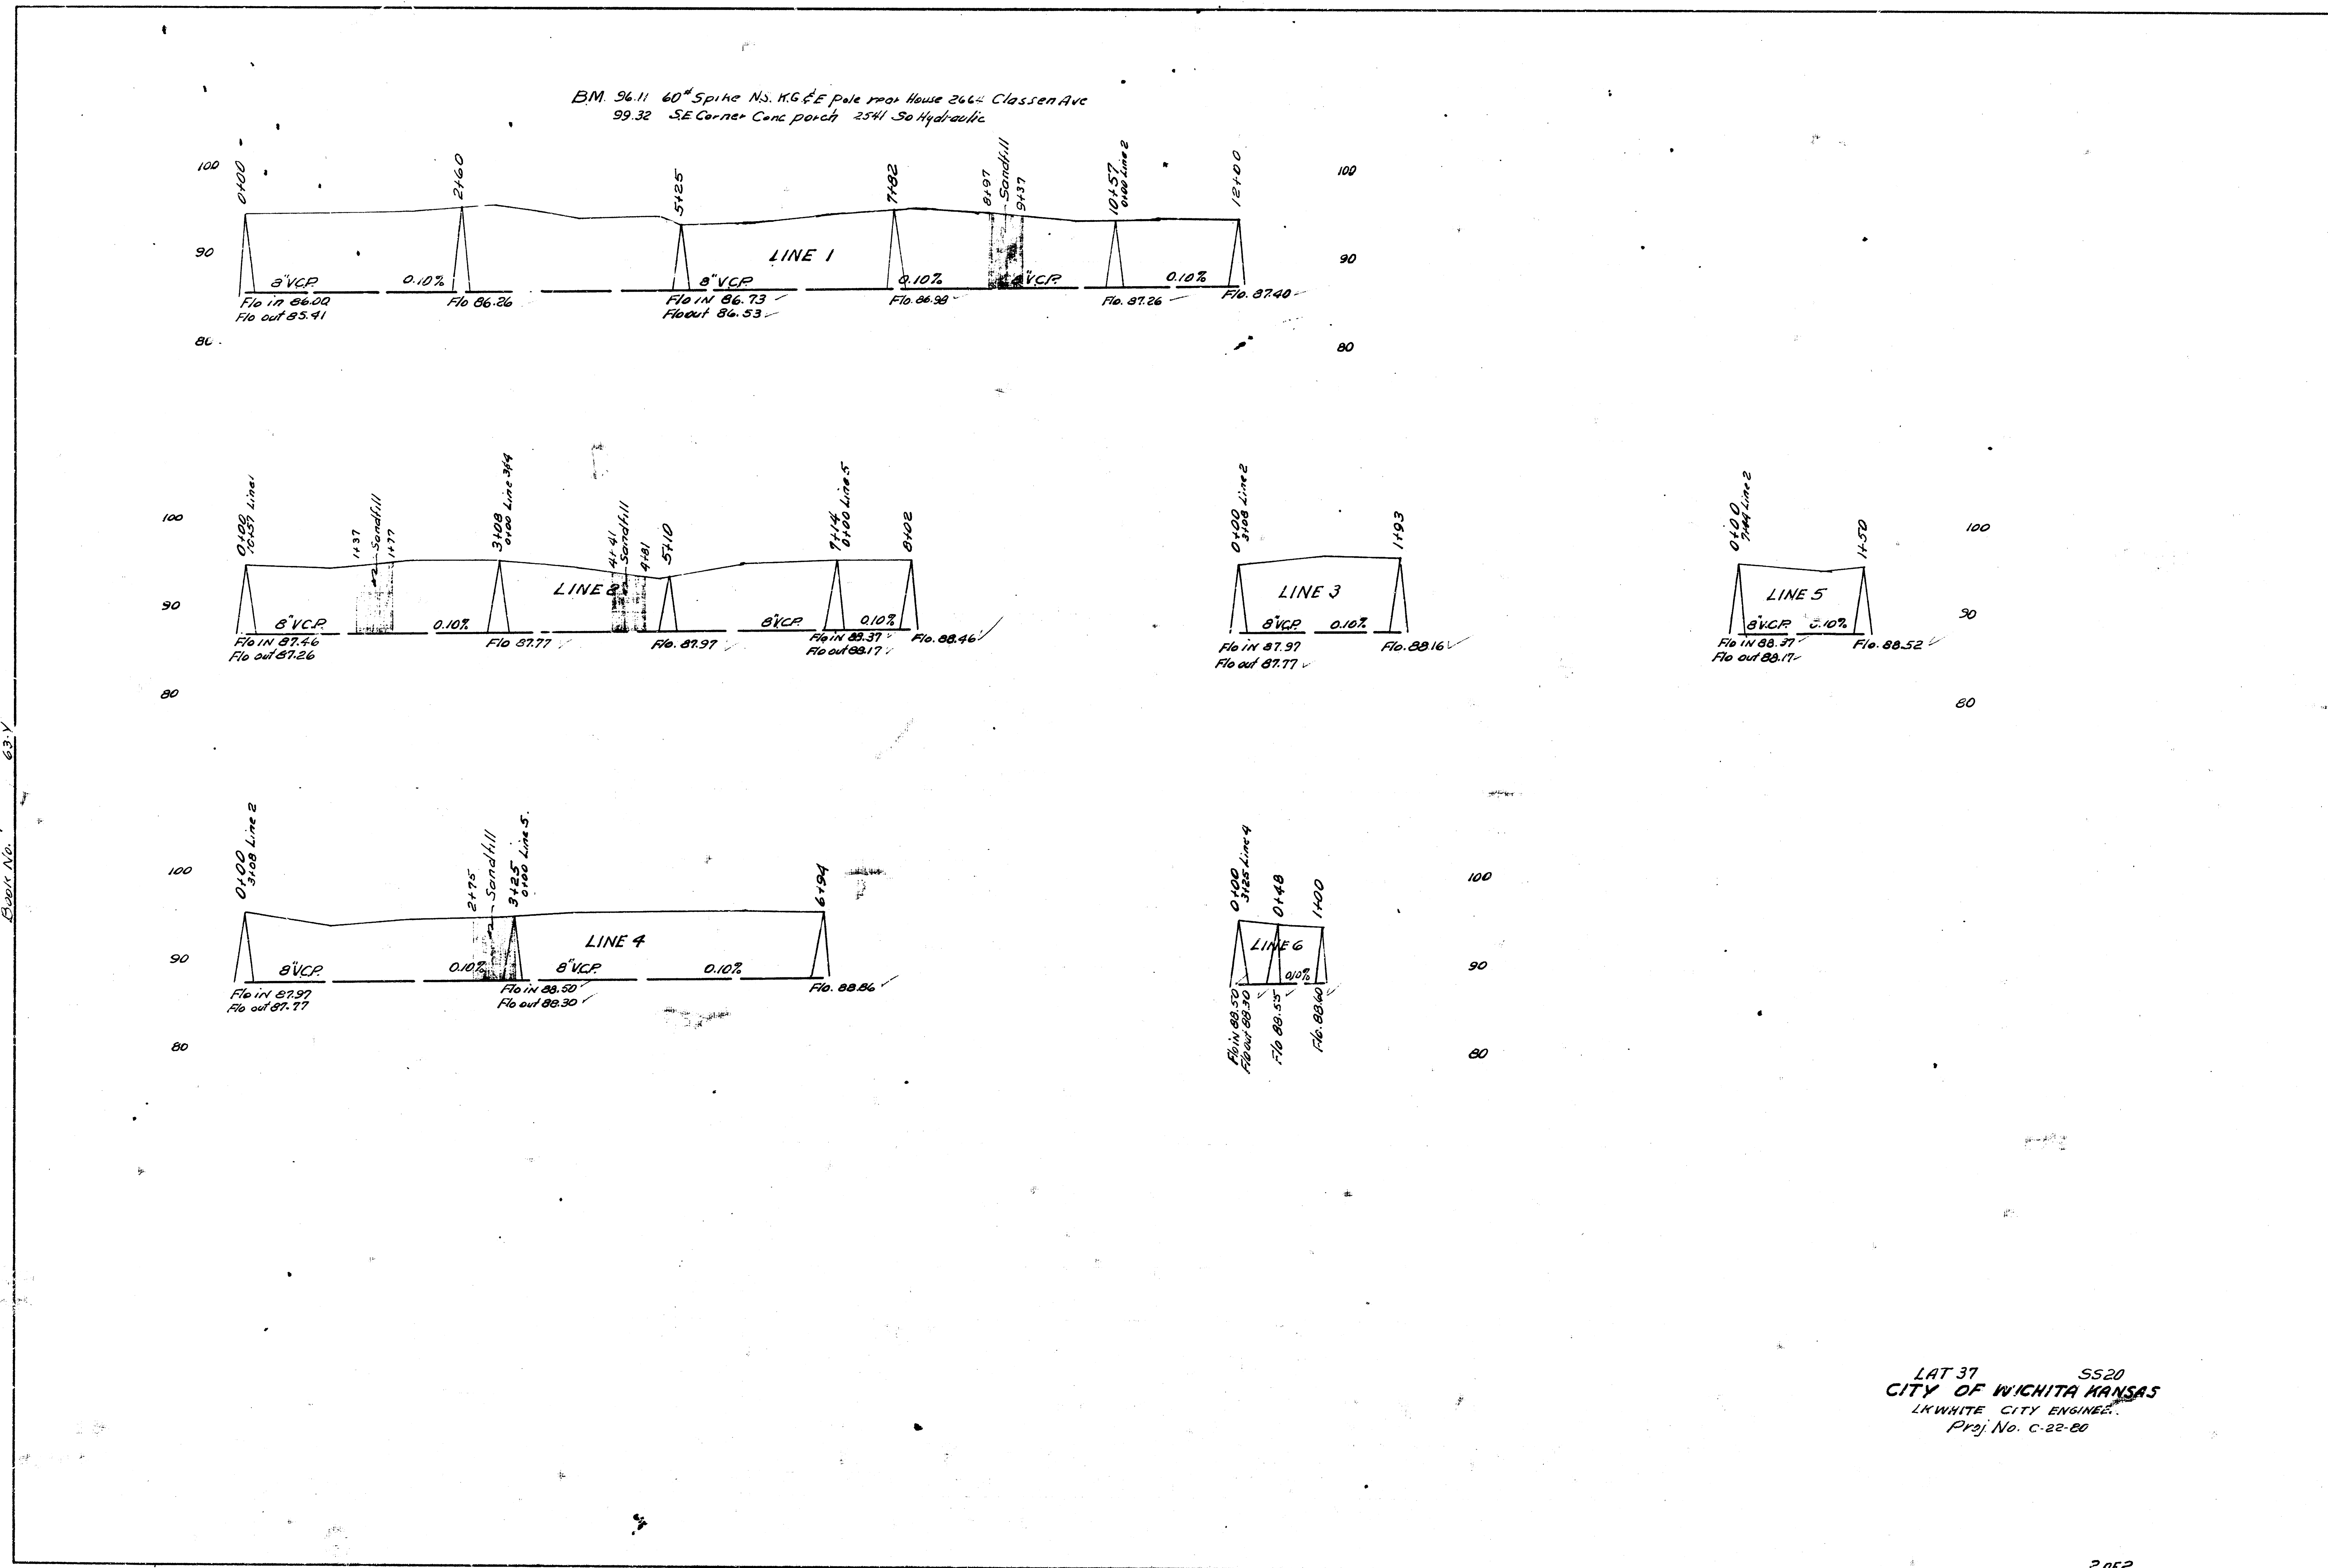

LAT 37 SS20
 CITY OF WICHITA KANSAS
 LKWHITE CITY ENGINEERS
 Proj No. C-22-80