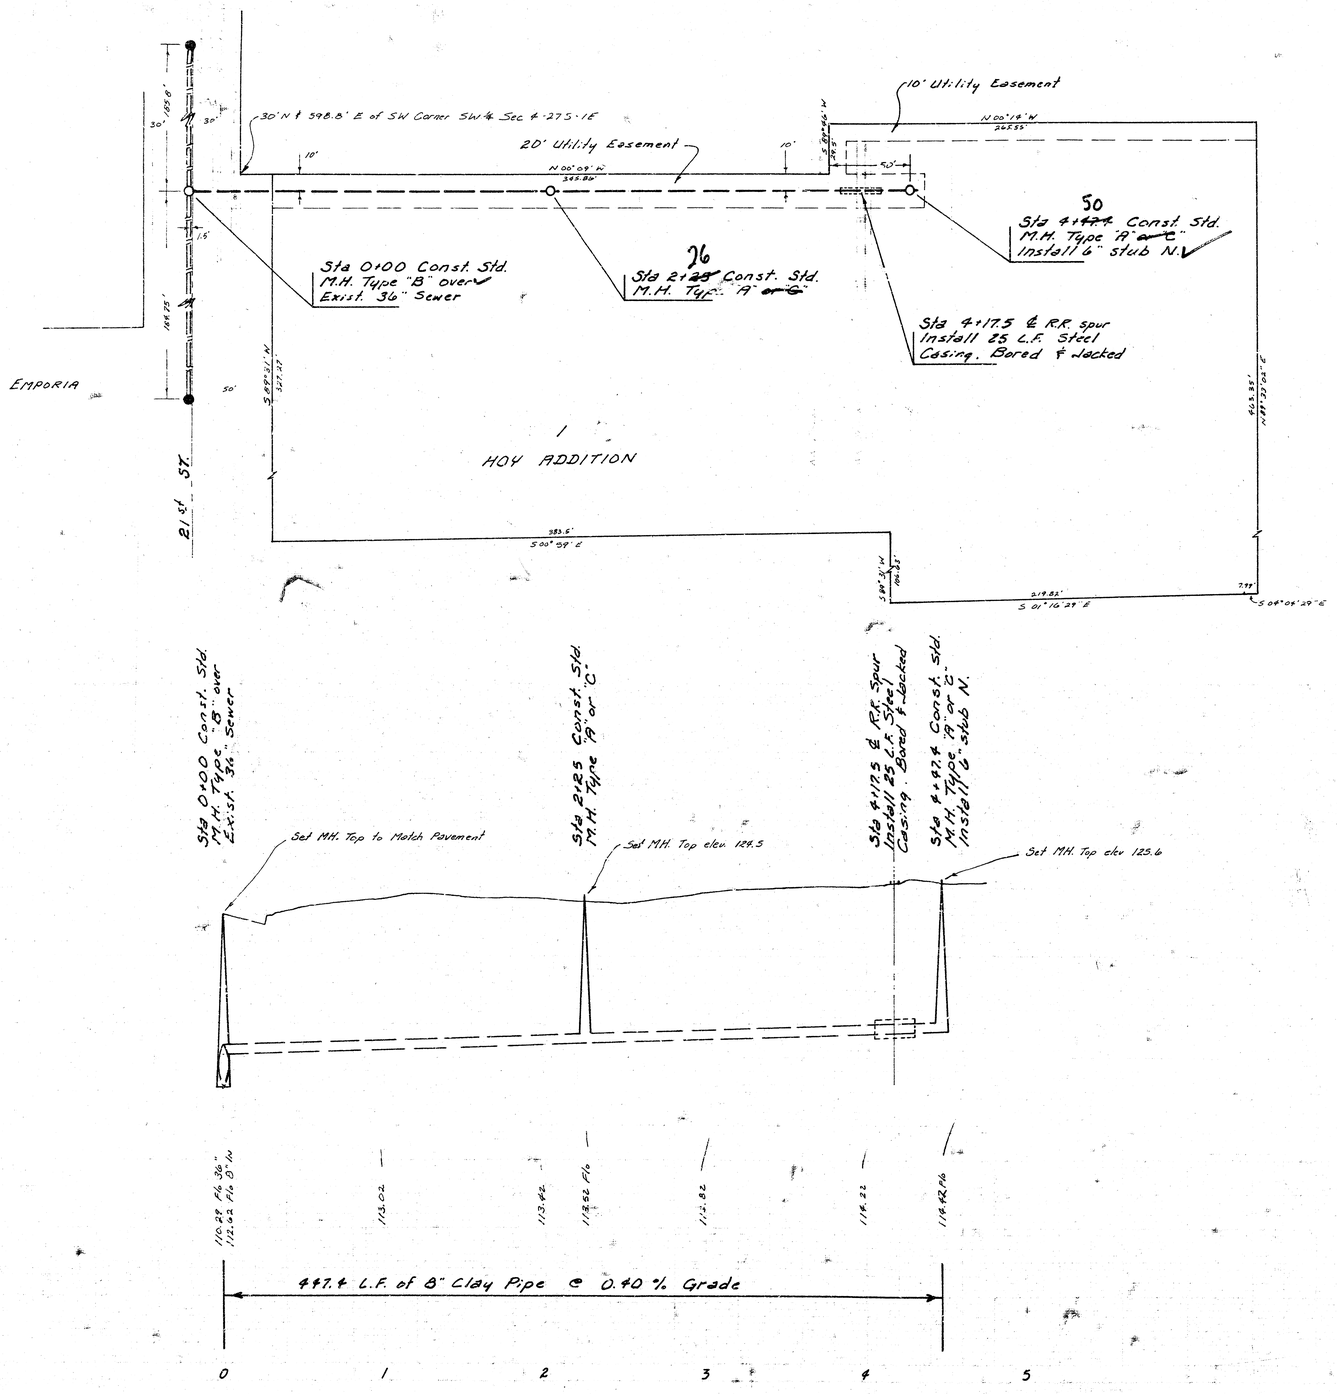


N

Scale Plan 1" = 40'
Profile 1" = 40' Horz.
1" = 5' Vert.

As Built
11/81

LAT 44 , SAN. SEWER NO. 20
CITY OF WICHITA , KANSAS
R.W. BRUGGEMAN
DIRECTOR OF ENGINEERING CITY ENGINEER
PROJ. NO. 468-76-245-81072-000-000-001

FILMED FROM THE BEST AVAILABLE COPY