SANITARY SEWER PLANS
LAT. 46, S.S. NO. 20
PROJECT NO
468-76-245-81497-000-000-001

CITY OF WICHITA KANSAS

MICHAEL E. LINDEBAK, CITY ENGINEER

DEC. 1985

INDEX TO DRAWINGS

SHEET NO.	DESCIPTION
1	TITLE & LOCATION
2	PLAN & PROFILE

GENERAL NOTES

1. CONTRACTOR SHALL AVOID UNCOVERING EXISTING WATER LINES UNLESS ABSOLUTELY NECESSARY. UNCOVERING SHALL BE DONE ONLY IN THE PRESENCE OF A WATER DEPARTMENT ENGINEER.
2. THE CONTRACTOR SHALL BE RESPONSIBLE FOR PRESERVING PROPERTY IRONS. THE CONTRACTOR SHALL BE REQUIRED TO RE-ESTABLISH ANY PROPERTY IRONS WHICH ARE DAMAGED OR DESTROYED BY HIS CONSTRUCTION OPERATIONS. SUCH IRONS SHALL BE RE-ESTABLISHED BY A LICENSED LAND SURVEYOR OR A LICENSED PROFESSIONAL ENGINEER IN ACCORDANCE WITH STATE LAWS.
3. CONTRACTOR SHALL NOTIFY THE UTILITY COMPANIES OF CONSTRUCTION SCHEDULING.
4. EXISTING UTILITIES AND THEIR LOCATIONS, AS SHOWN ON THE PLANS, REPRESENT THE BEST INFORMATION OBTAINABLE FOR DESIGN. LOCATION INFORMATION HAS BEEN OBTAINED FROM THE VARIOUS UTILITY COMPANIES AND IS EITHER FROM COMPANY RECORD DRAWINGS OR COMPANY PROVIDED FIELD LOCATIONS. THE PLAN LOCATIONS SHOWN ARE NOT GUARANTEED. ADDITIONAL EXISTING UTILITIES MAY ALSO BE ENCOUNTERED.
5. COST OF SEEDING AND MULCHING SHALL BE SUBSIDIARY TO PROJECT.

NOTE: NOTIFY THE FOLLOWING COMPANIES PRIOR TO ANY EXCAVATION:

BELL TELEPHONE COMPANY	268-2256
CABLEVISION	262-0641
GAS SERVICE COMPANY	263-7511
KANSAS GAS & ELECTRIC	261-6248
KANSAS ONE-CALL	1-800-344-7233

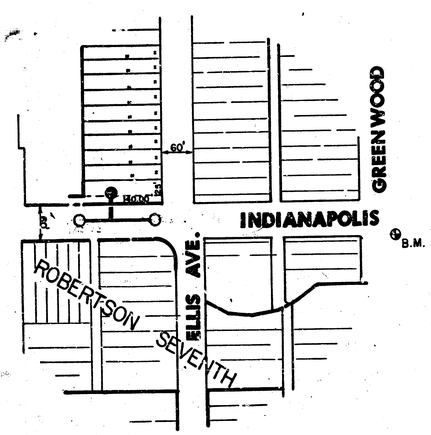

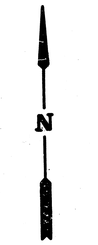

SCALE: 1"=120'

BENCH MARKS

B.M. 103.44 "G" IN GLOBE ON [illegible] ROCK IN SIDEWALK
EL GREENWOOD – SS. INDIANAPOLIS

BENEFIT DISTRICT:

The east 70 feet of Lot 63 and the east 70 feet of the north 10.33 feet of Lot 65 on Ellis Avenue in New York 2nd Addition.

AS BUILT
3-18-86
RDC

MICHAEL D. [illegible] LICENSED 8399 KANSAS PROFESSIONAL ENGINEER

MKEC

SANITARY SEWER EXTENSION
LAT. 46 S.S. NO 20

Design
Drawn by
Checked by
Date
Job no.

MID-KANSAS ENGINEERING CONSULTANTS PA
3500 NORTH ROCK ROAD
BUILDING #800
WICHITA, KANSAS 67226
682-6561

Sheet 1 of 2

1/2

FILMED FROM THE BEST AVAILABLE COPY

LAT 46 SAN SEW. NO. 20

PROJ NO. 468-76-245-81497-000-000-001

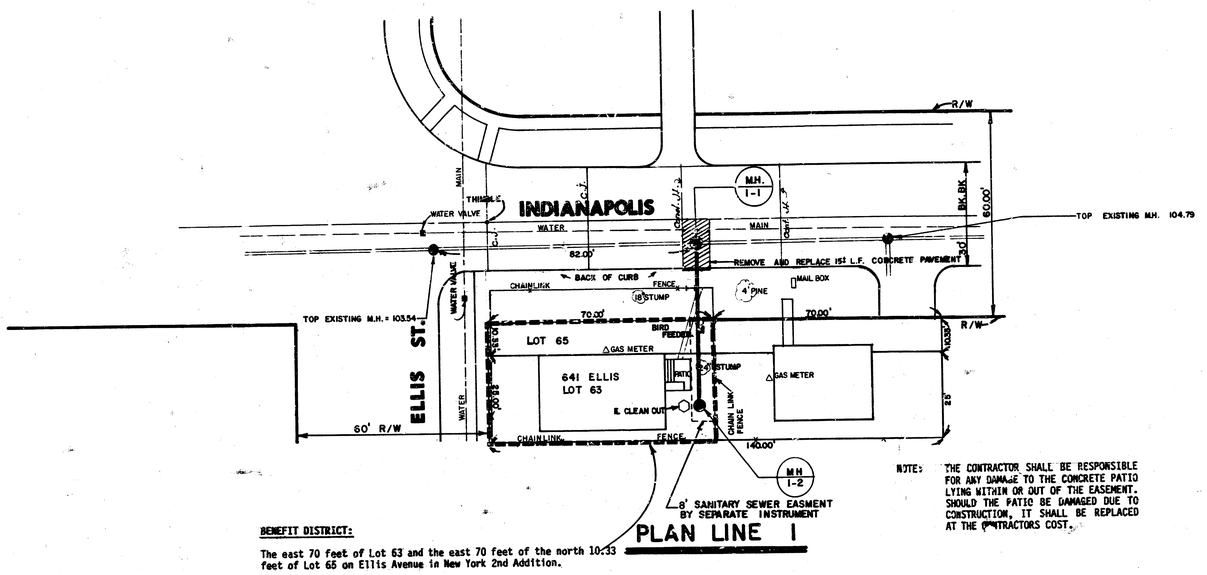

BENEFIT DISTRICT:

The east 70 feet of Lot 63 and the east 70 feet of the north 10.33 feet of Lot 65 on Ellis Avenue in New York 2nd Addition.

NOTE: THE CONTRACTOR SHALL BE RESPONSIBLE FOR ANY DAMAGE TO THE CONCRETE PATIO LYING WITHIN OR OUT OF THE EASEMENT. SHOULD THE PATIO BE DAMAGED DUE TO CONSTRUCTION, IT SHALL BE REPLACED AT THE CONTRACTORS COST.

N

SCALE: 1"=20'

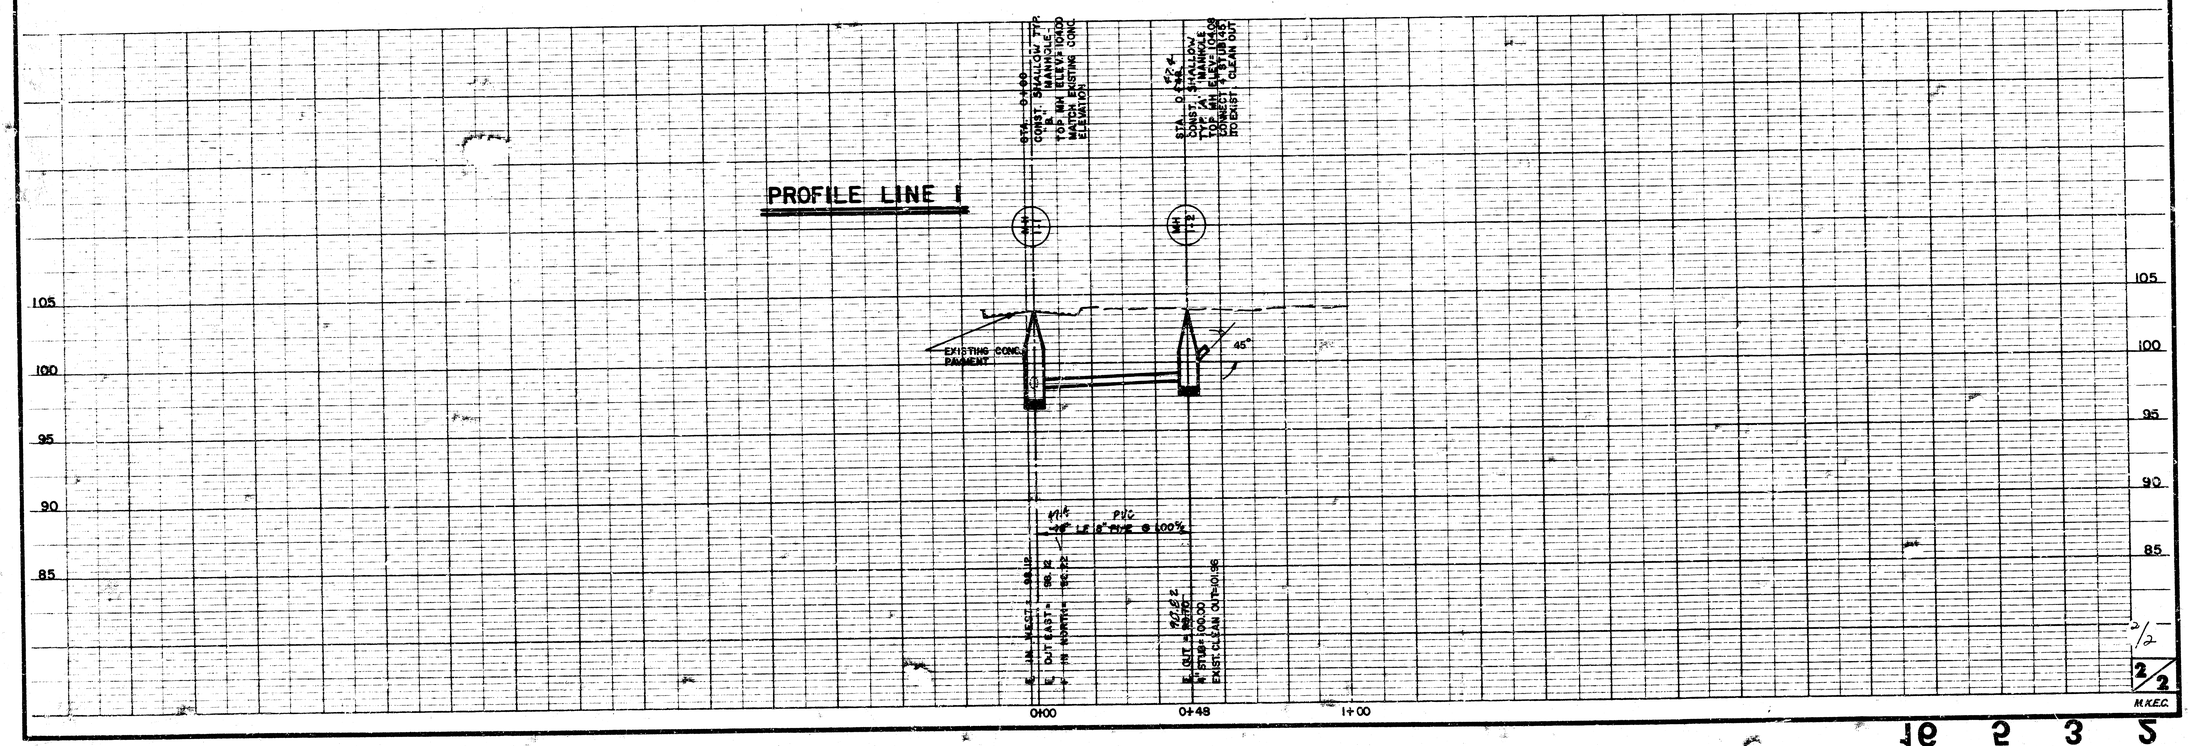

2/2

M.K.E.G.

FILMED FROM THE BEST AVAILABLE COPY