

B.M. 123.16 M. in Mfg. Co. on hydrant S.E. cor. Grove and 14TH.

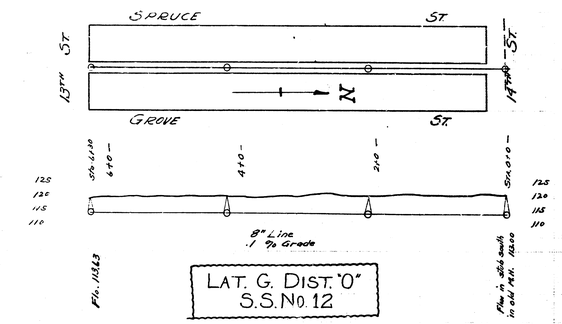

LAT. G. DIST. "O"
S.S. No. 12


B.M. — Same as above.

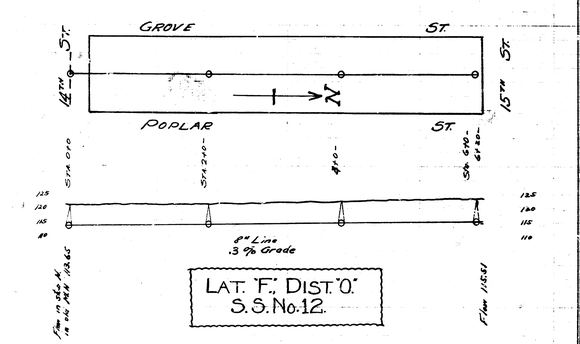


LAT. "F." DIST. "O."
S. S. No. 12.

B.M. 154.44 M. in Mayers, back of wk. N. of curb S.W. cor. Pine and Alton.

LAT. "M", DIST. "D"
S.S. No. 12.

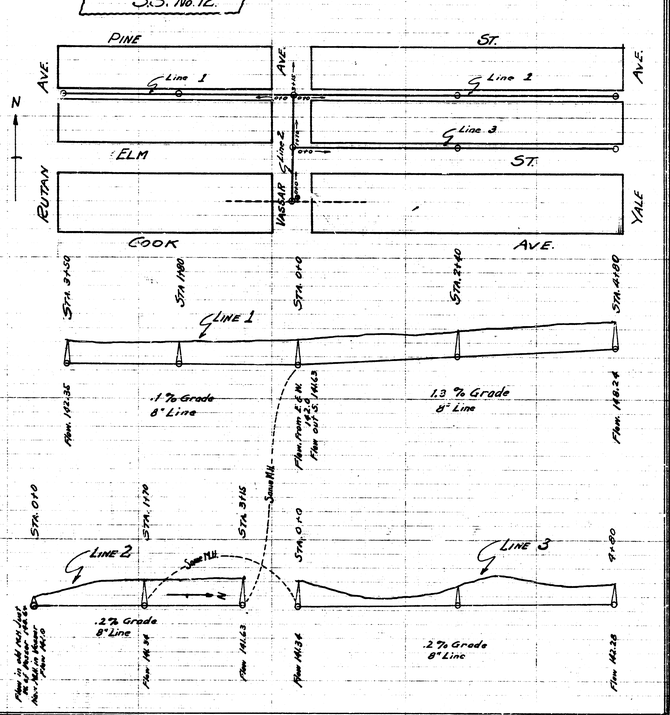


B.M. 121.82. X on back of walk N.W. corner Estelle & Canal

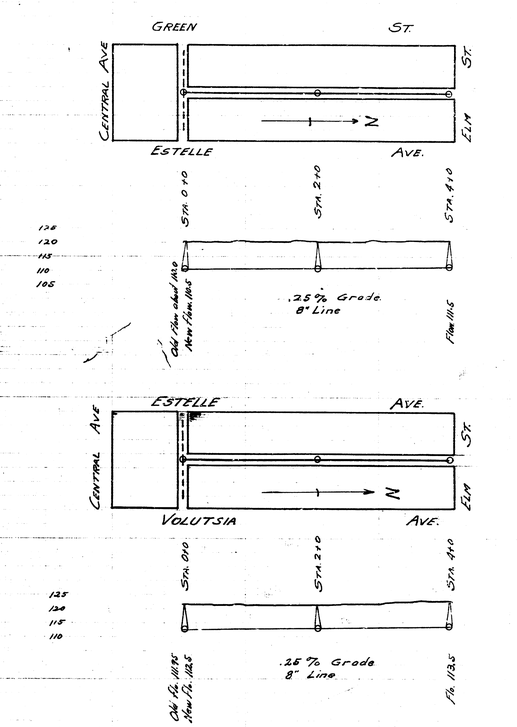


LAT. "N" DIST. "D"
S.S. No. 12.

B.M. 195.37 Iron in thimble Center of East and Central.

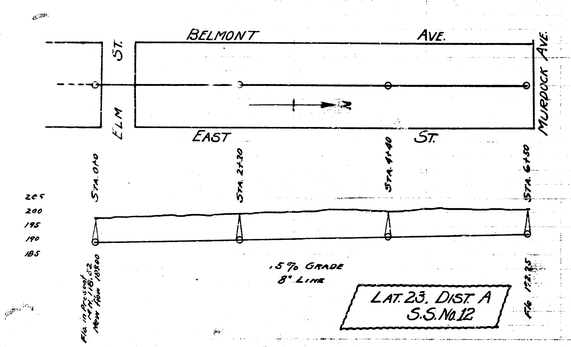


LAT. 23. DIST. A
S.S. No. 12

B.M. 118.92 "B" in Blake, back of walk west. S.W. corner of 17TH & Mosley.

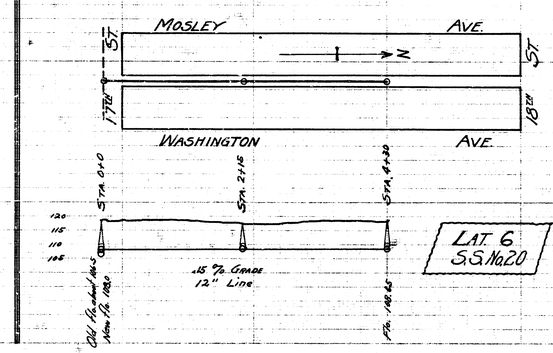

LAT 6
S.S. No. 20

B.M. 102.77 K. in Kensler - 10' E. of Inter. Sq. S.E. corner Vine and Dayton

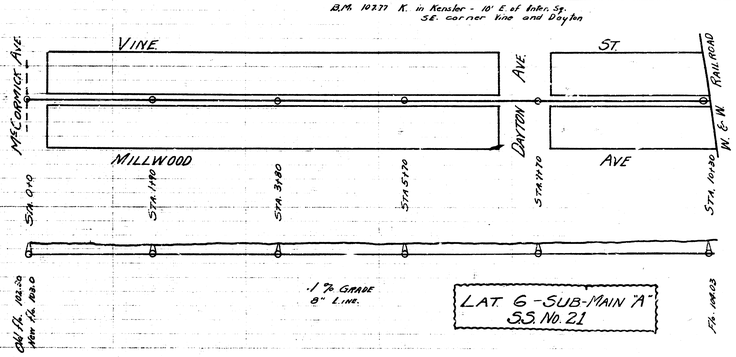

LAT 6 - SUB-MAIN "A"
S.S. No. 21