
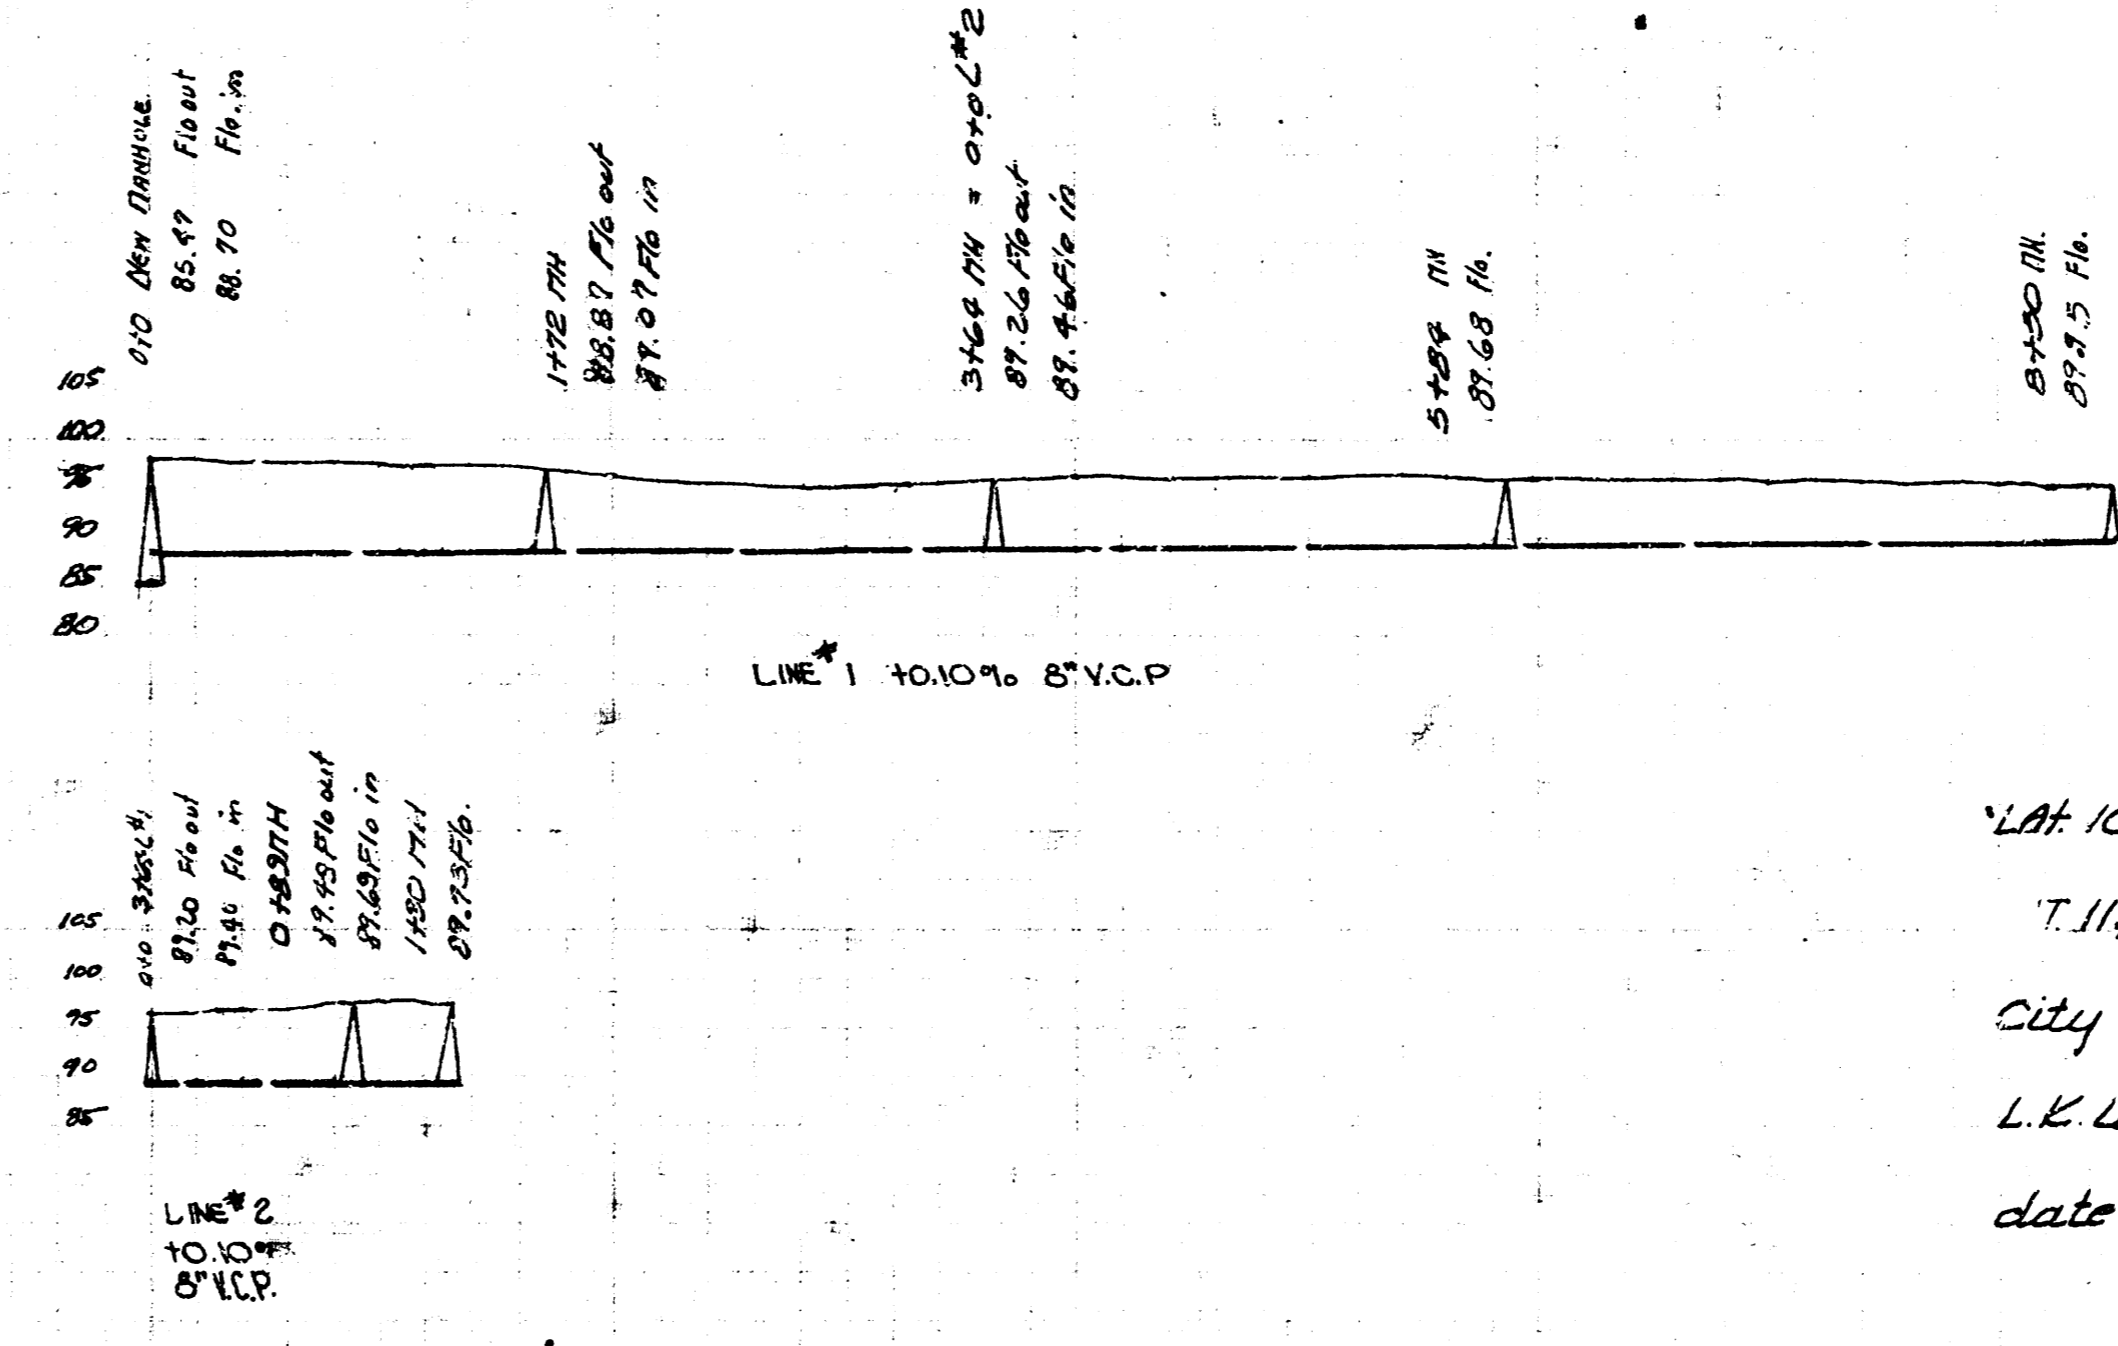


871.123.48 NE. Cor. of house Walk NE. Cor. of house S.W. Cor. 8th & Green.

871.91.62 STANDARD NE. COR. PANNEE & WASHINGTON

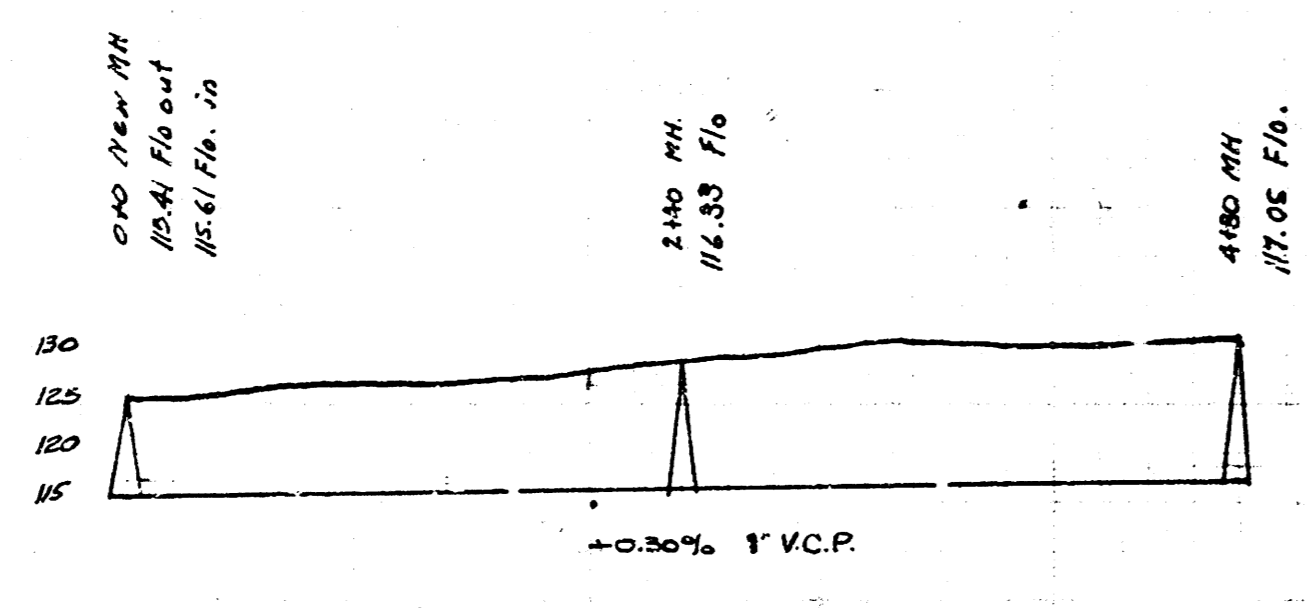

LA 10, DIST. E, SS # 12
T. 11, DIST. F, S.S. # 20
City of Wichita, Kansas
L.K. White City Engineer
date 8-8-49 Proj. No. C27-12