
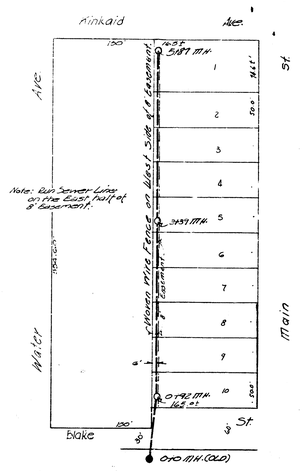
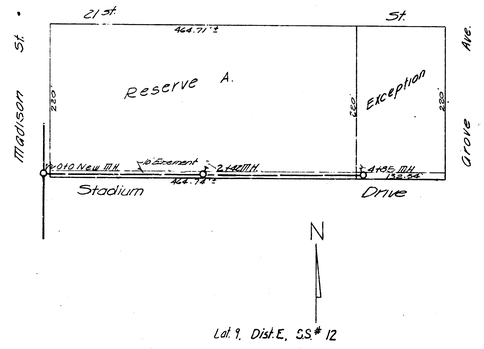


Lot 12, Dist. A, SS# 20

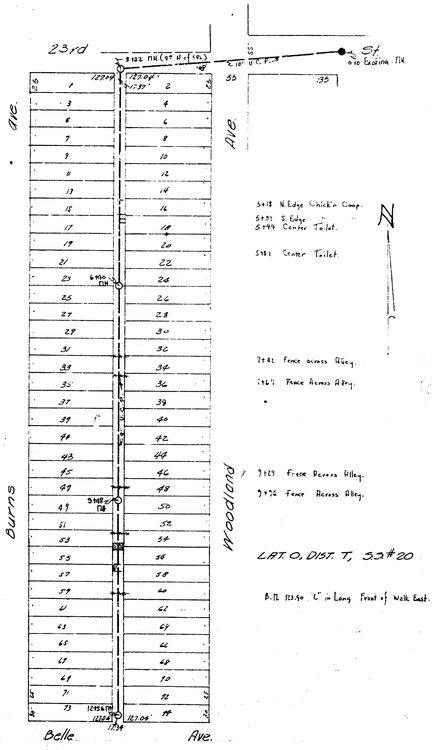

Lot 9, Dist. E, SS# 12


23rd St.
8102 MH. (ST W of Ln.)
St.
010 Existing MH.
Burns Ave.
Woodland Ave.
122.94'
122.94'
122.94'