

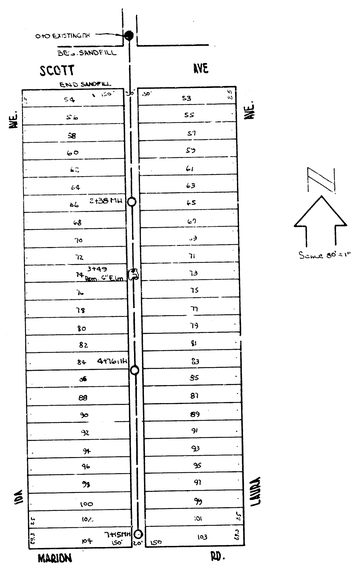


LAT. 14, DIST. A, SS# 20

BM. 36.38 E. Side P. Pole So. Side Scott (Spike in Base of Pole)

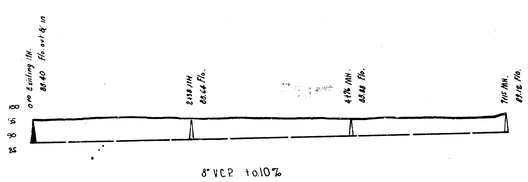


LAT. 14, DIST. A, SS# 20

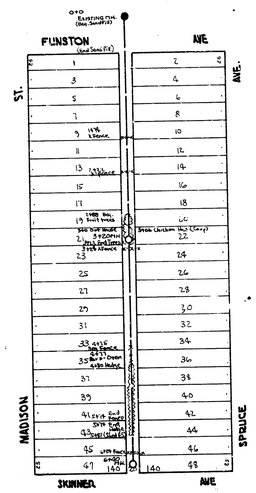


LAT. 10, DIST. A5, SS# 12

BM. 99.38 "G" in Globe So. End. W. Cb. Spruce & Flinston

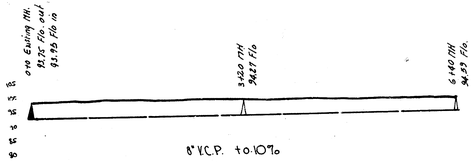


LAT. 10, DIST. A5, SS# 12

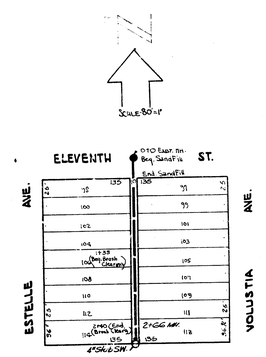


LAT. 12, DIST. E, SS# 12

BM. 123.11 No. Rim MH. in Eleventh Street.

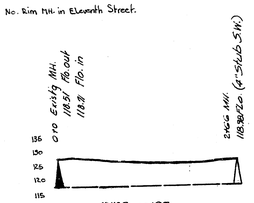


LAT. 12, DIST. E, SS# 12

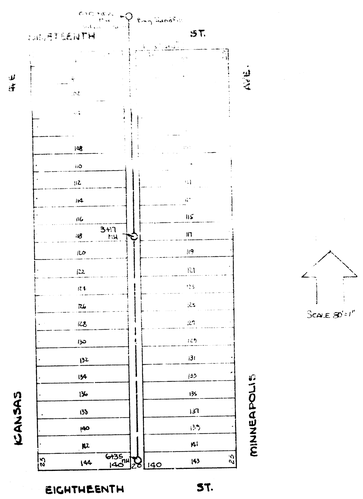

LAT. 17, DIST. T, SS# 12

BM. 120.23 No. Rim of So. Spindle 194 ft Hydraulic

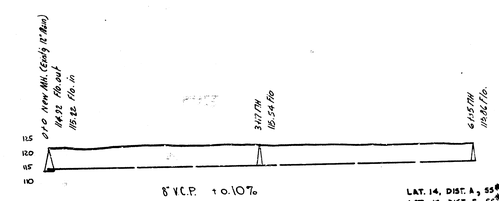

LAT. 17, DIST. T, SS# 12

LAT. 14, DIST. A, SS# 20 — LAT. 10, DIST. A5, SS# 12
LAT. 12, DIST. E, SS# 12 — LAT. 17, DIST. T, SS# 12

CITY OF WICHITA, KANSAS
L.K. WHITE - CITY ENGINEER
1949