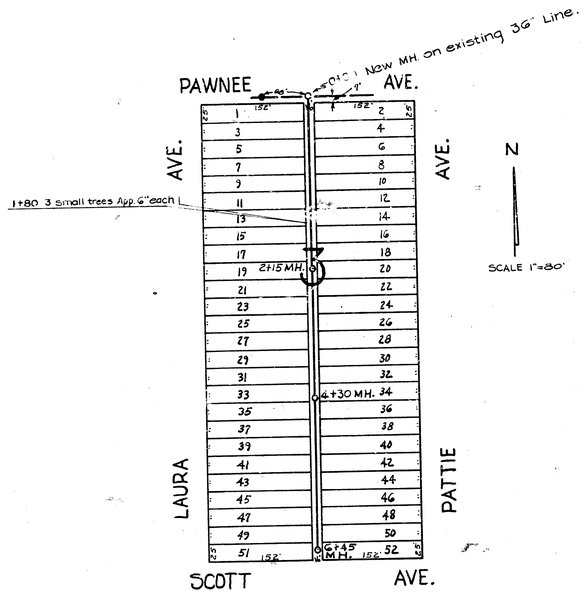

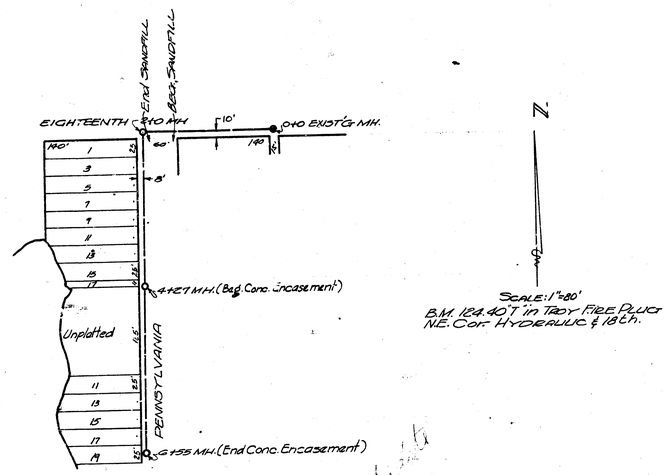

B.M. 98.31 Prop. Iron N.E. Cor. Pattie & Pawnee.

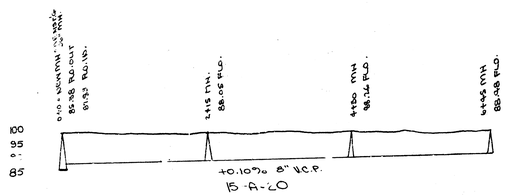

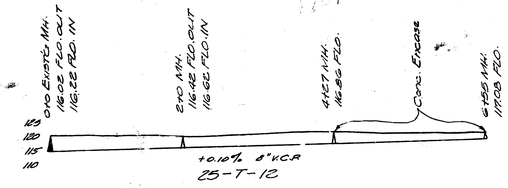

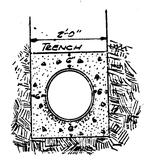

CONCRETE ENCASEMENT DETAIL
NO SCALE

LAT. 15, DIST. A, SS#20
LAT. 25, DIST. T, SS#12
CITY OF WICHITA, KANSAS
L.H. WHITE — City Engineer
Date 4-28-50