



Date 2-9-54
 Drawn by McClain
 Checked by M.C.
 Book No. 98-1

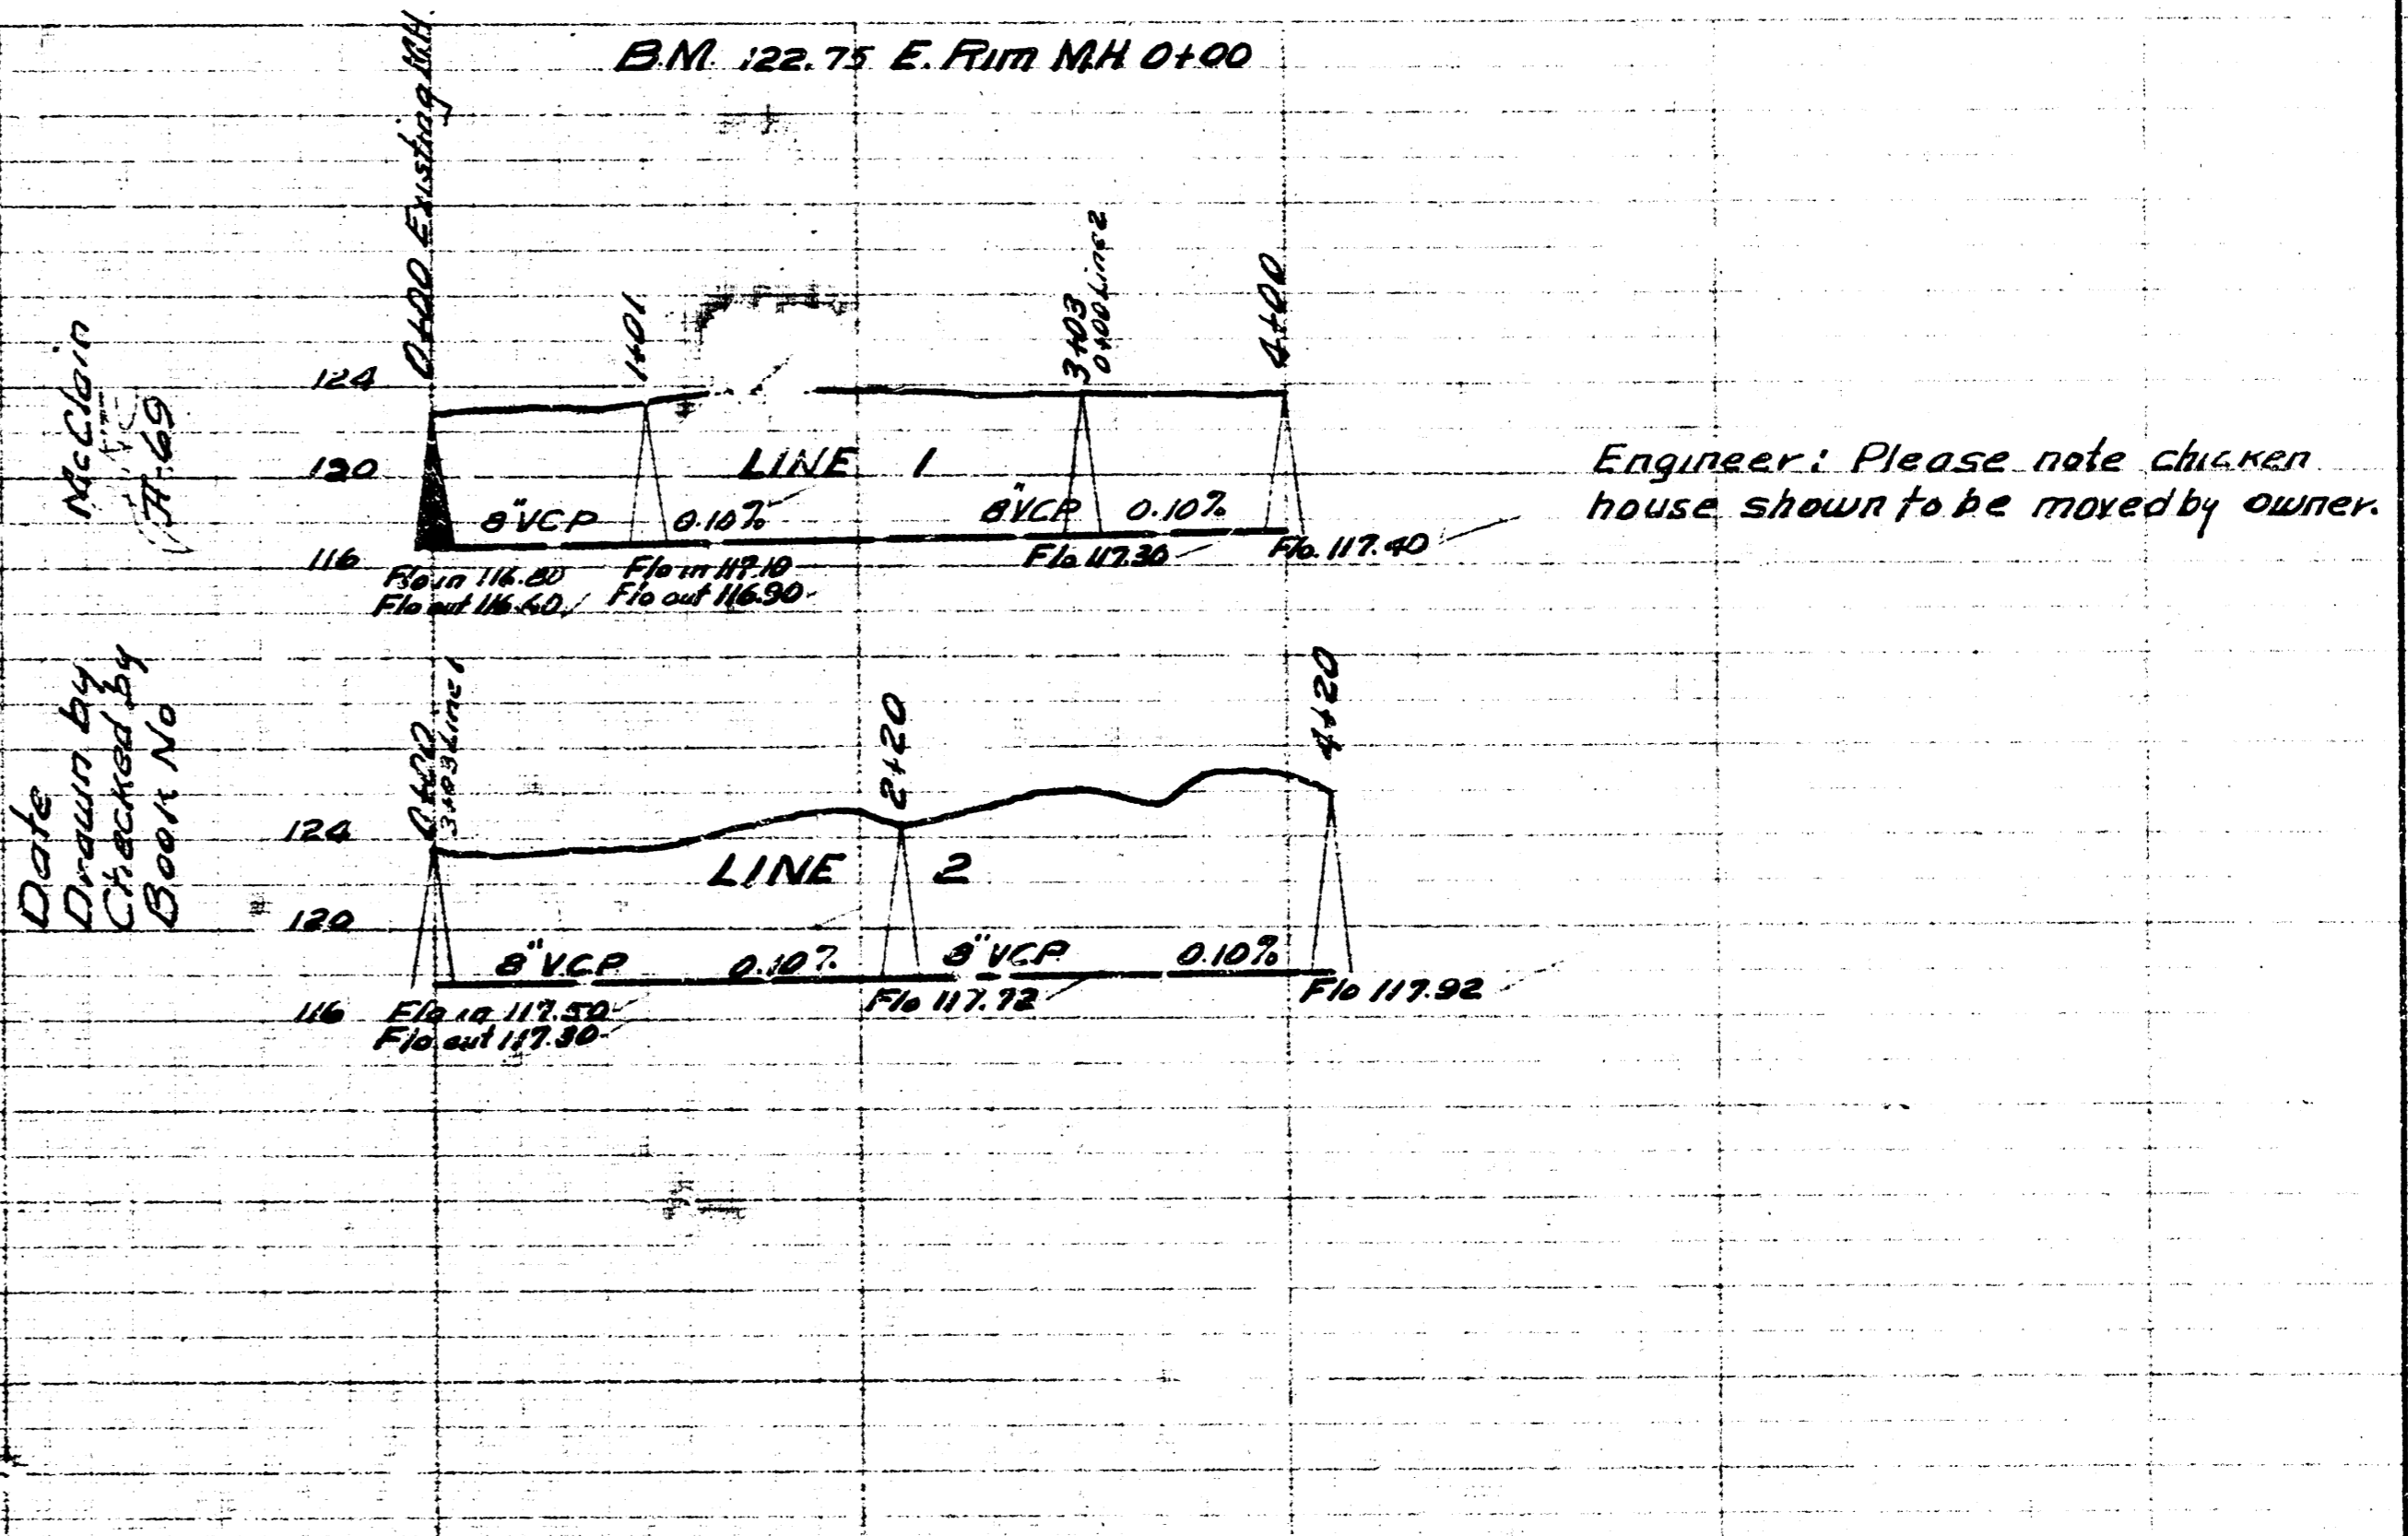

LAT. 3 DIST. RR. 55.20
 CITY OF WICHITA KANSAS
 BE. SMITH CITY ENGINEER
 Proj. No. C-23-2

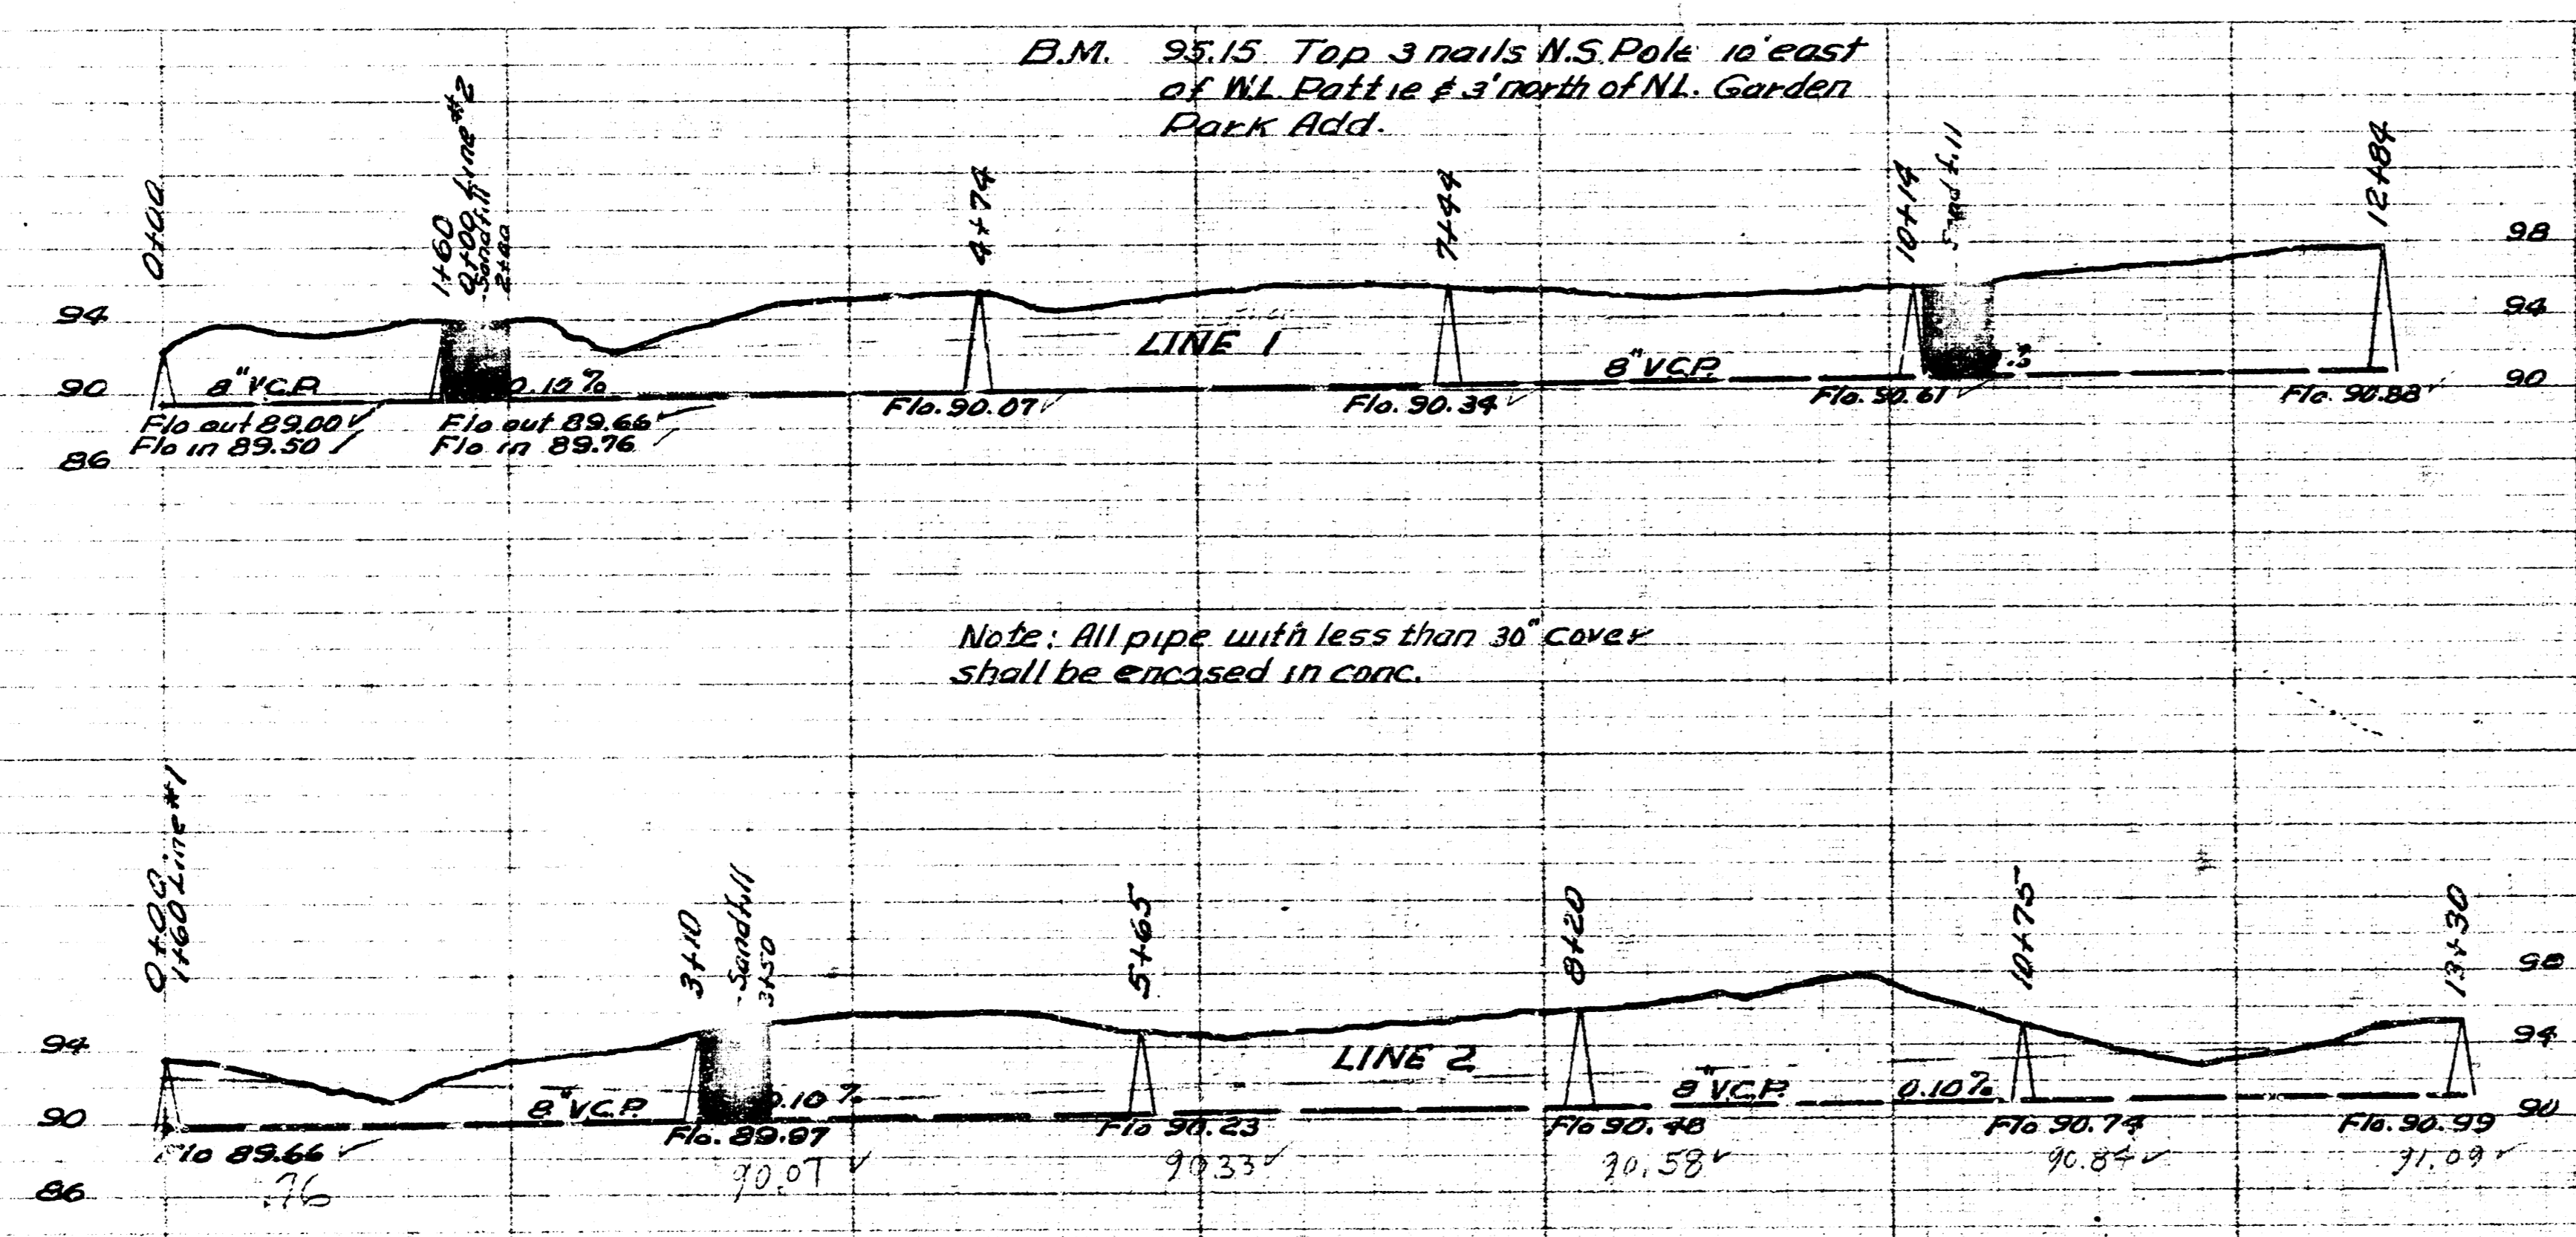

LAT. 34 DIST. T. 55.12
 CITY OF WICHITA KANSAS
 BE. SMITH CITY ENGINEER
 Proj. No. C-23-44