




LAT J DIST O S.S.12

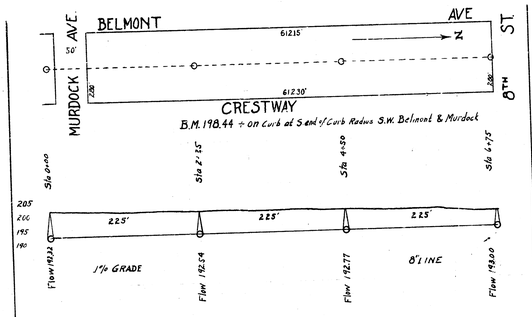


LAT. 26 DIST. A S.S.12

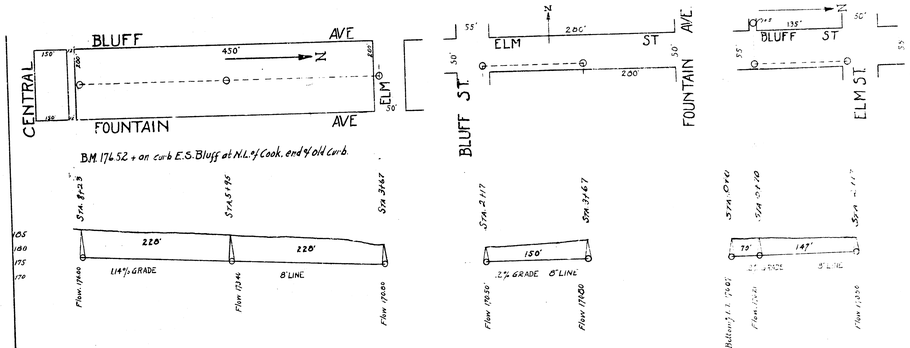

LAT. X DIST. D S.S.12

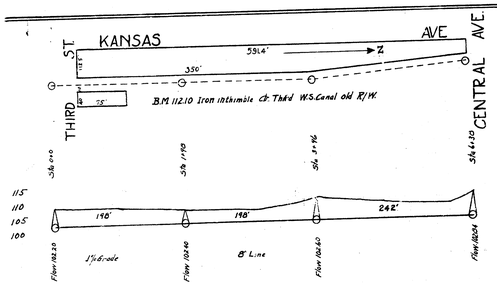

LAT 3 DIST N-O S.S. 20

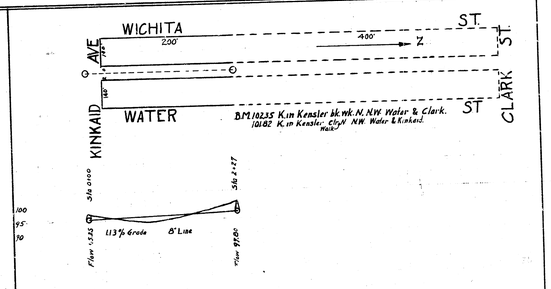

LAT. G DIST. B S.S. 20