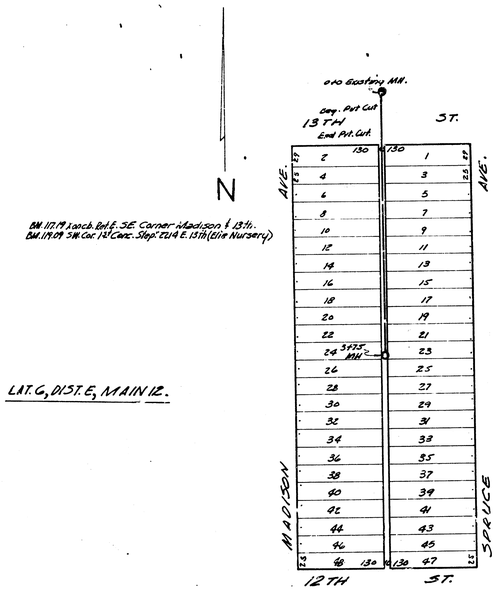


LAT. 6, DIST. E, MAIN 12.

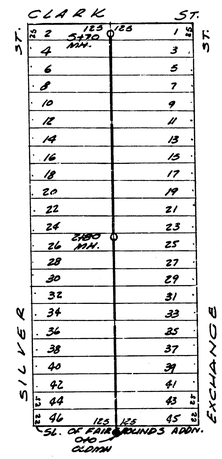


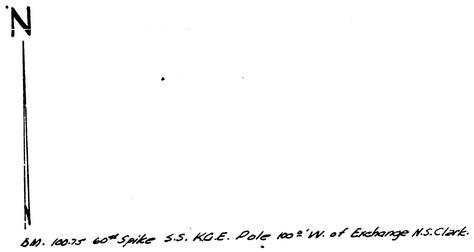


LAT. 4, DIST. B, MAIN 20

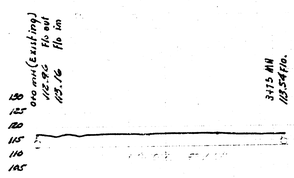


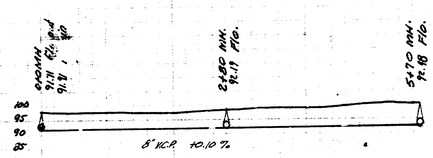


LAT. 4, DIST. B, MAIN 20
LAT. 6, DIST. E, MAIN 12

CITY OF WICHI . KANSAS

L. K. White City Engineer

Date 11-26-48 Proj. No. C28-31