
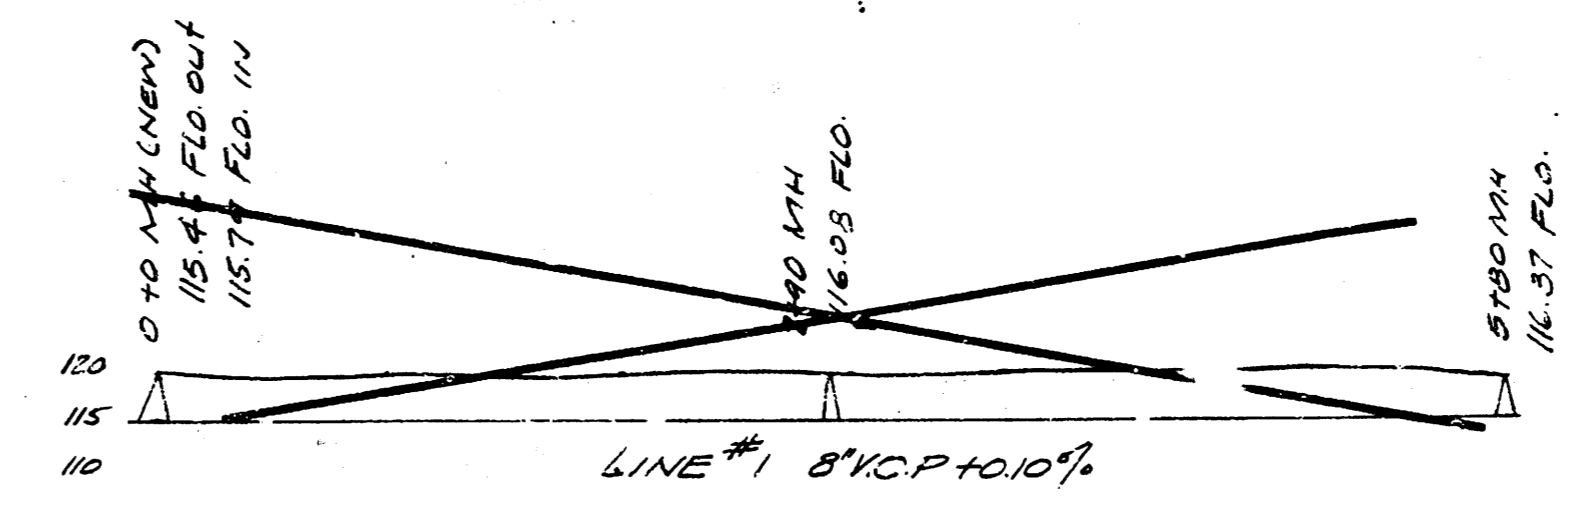


LAT. 17 - DIST. B - 55#20

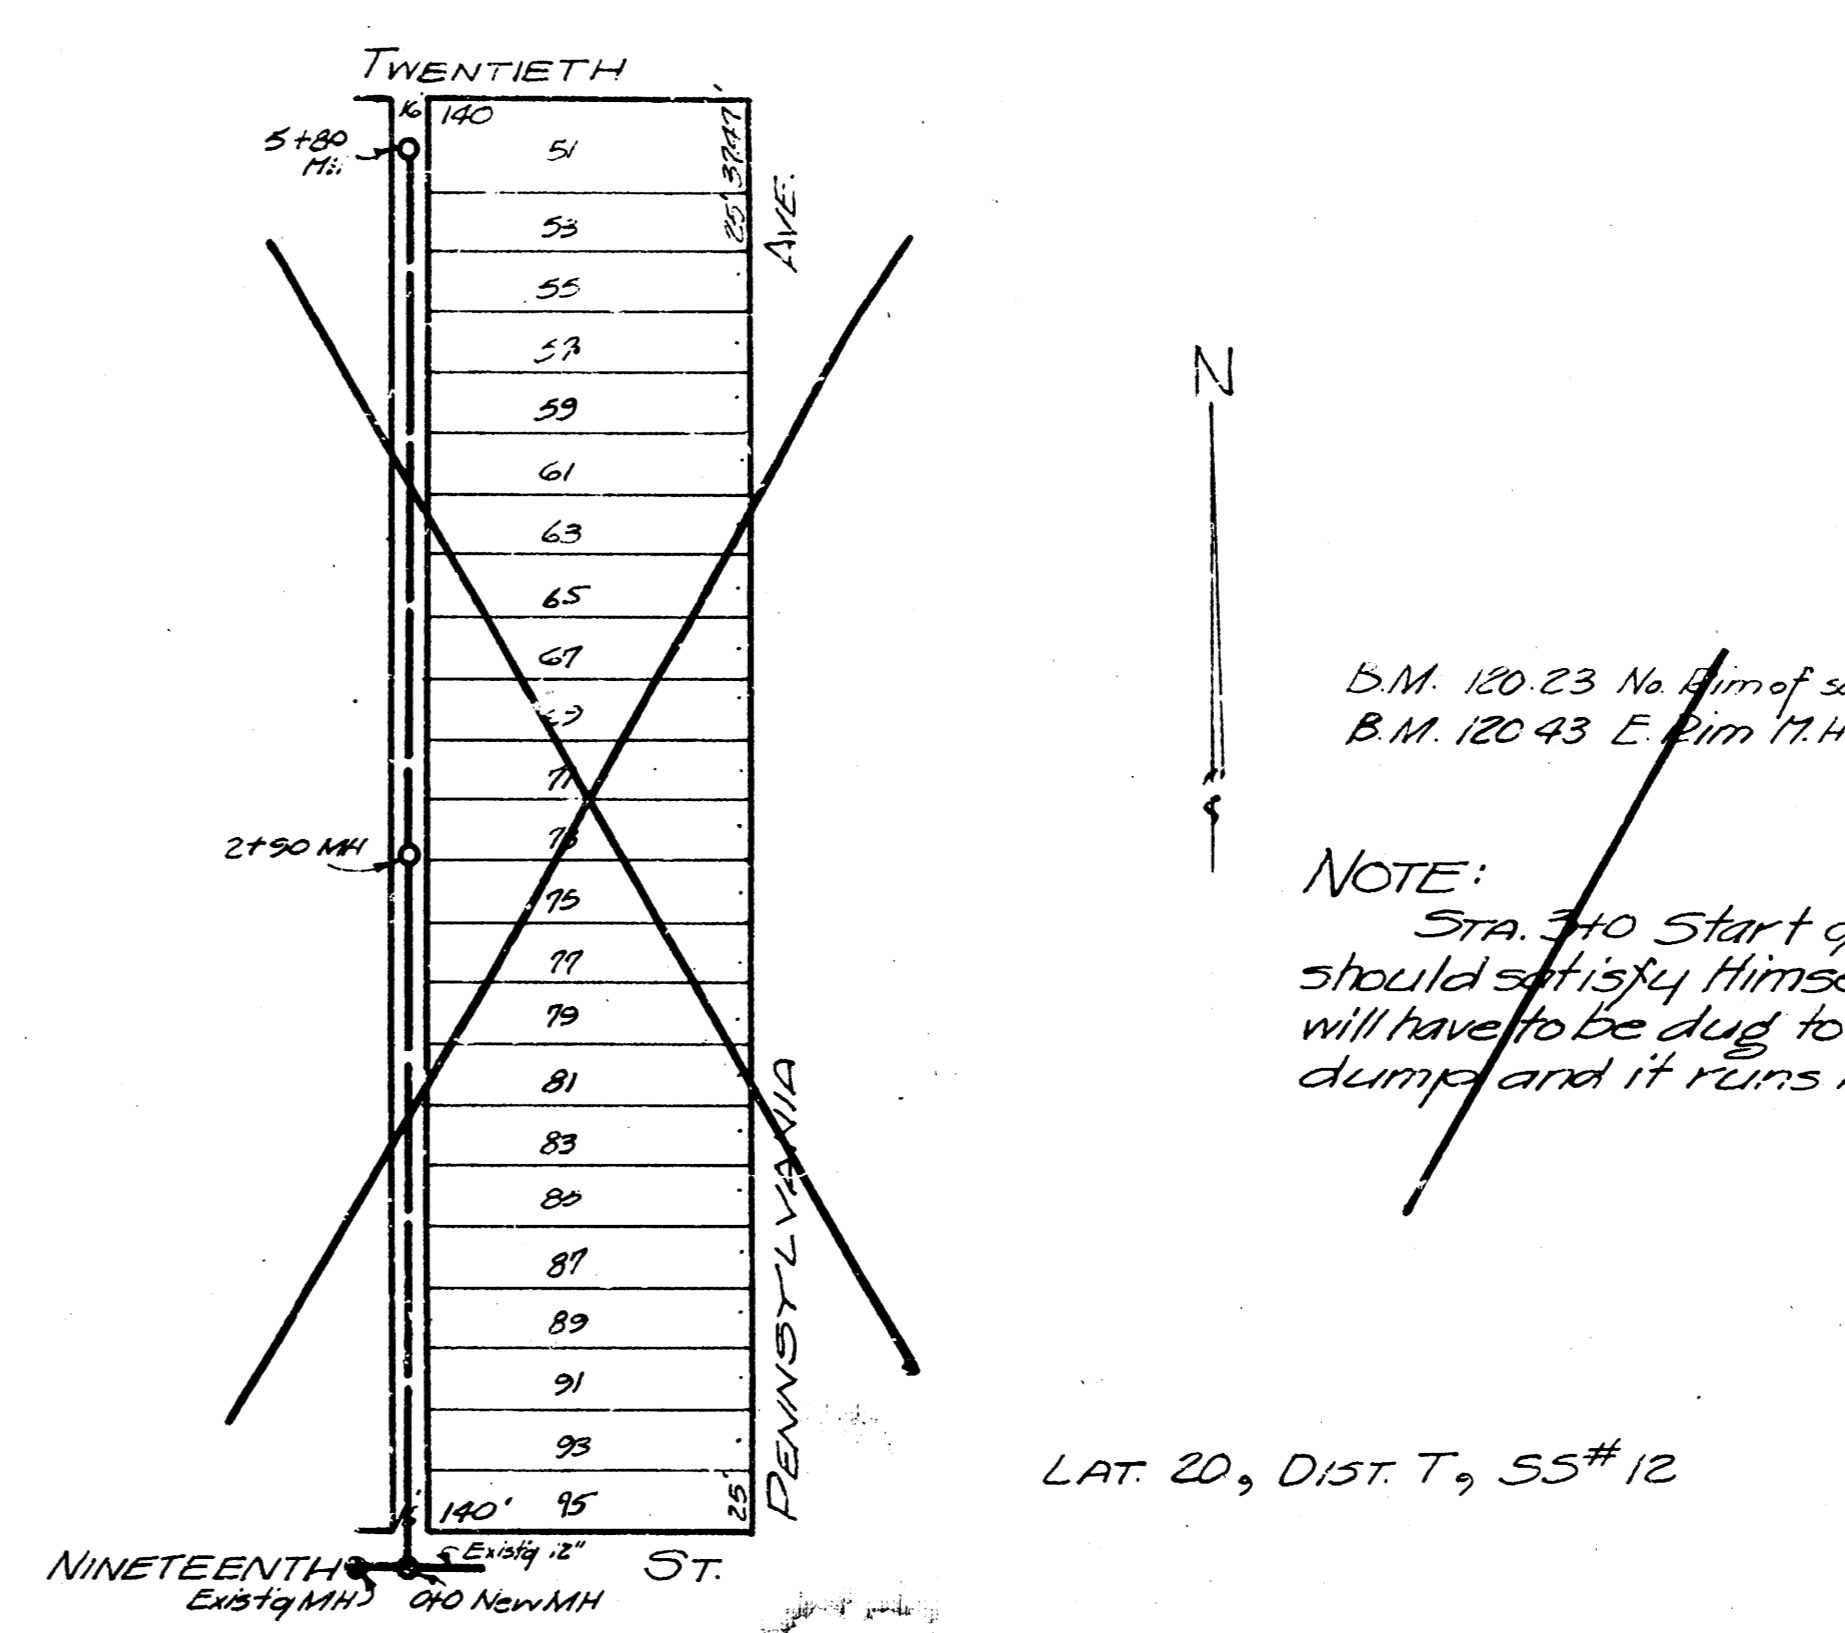

LAT. 17, DIST. B, 55#20
~~LAT. 20, DIST. T, 55#12~~
 CITY OF WICHITA, KANSAS
 L.K. WHITE ... CITY ENGINEER
 Date 6-6-50