

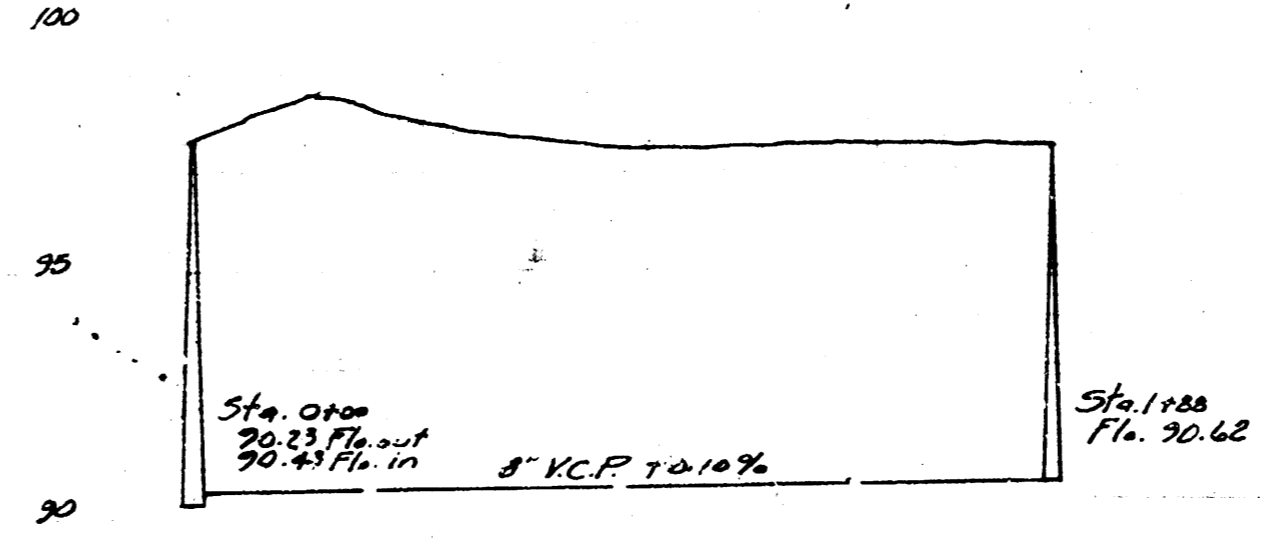
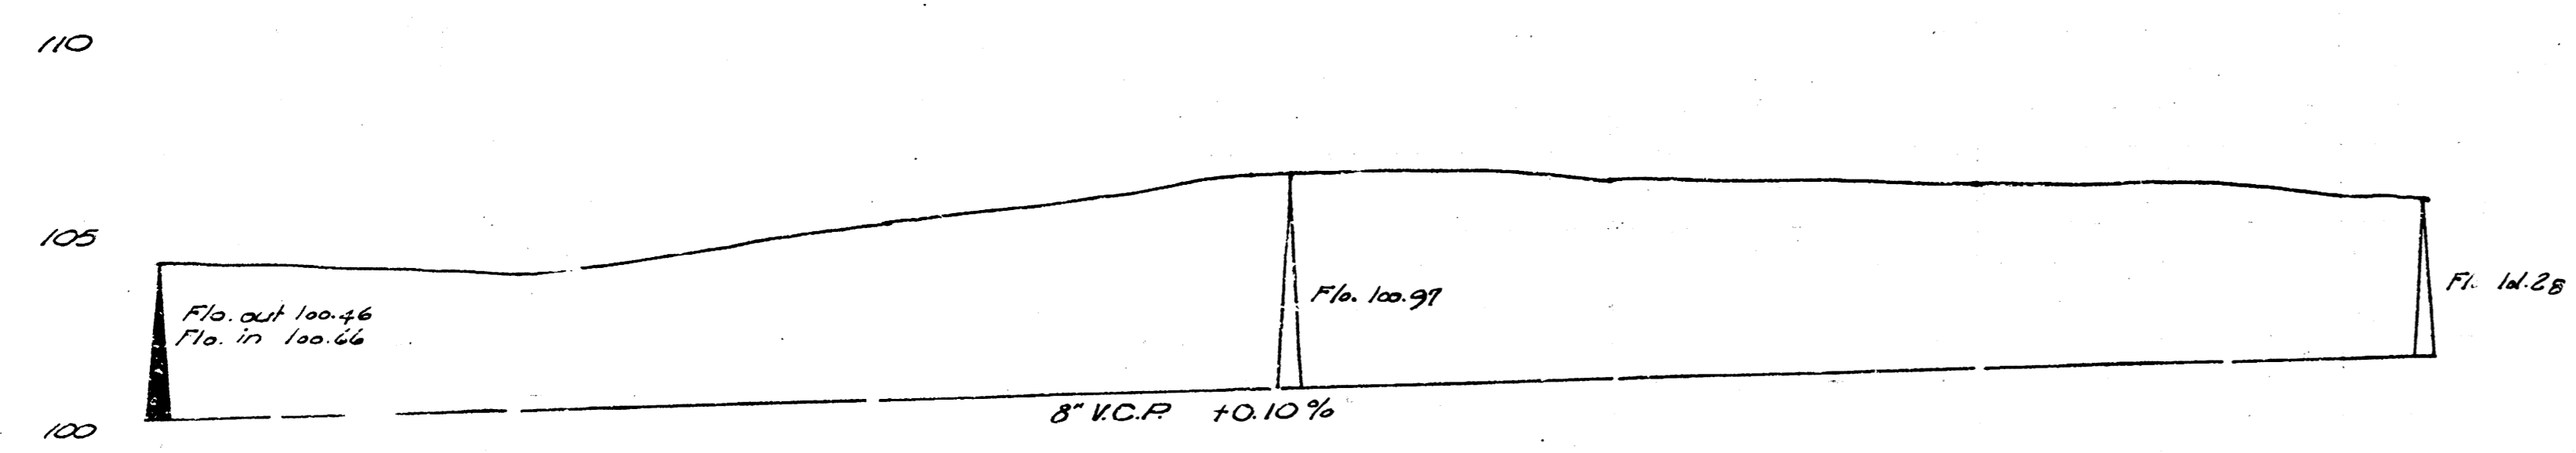
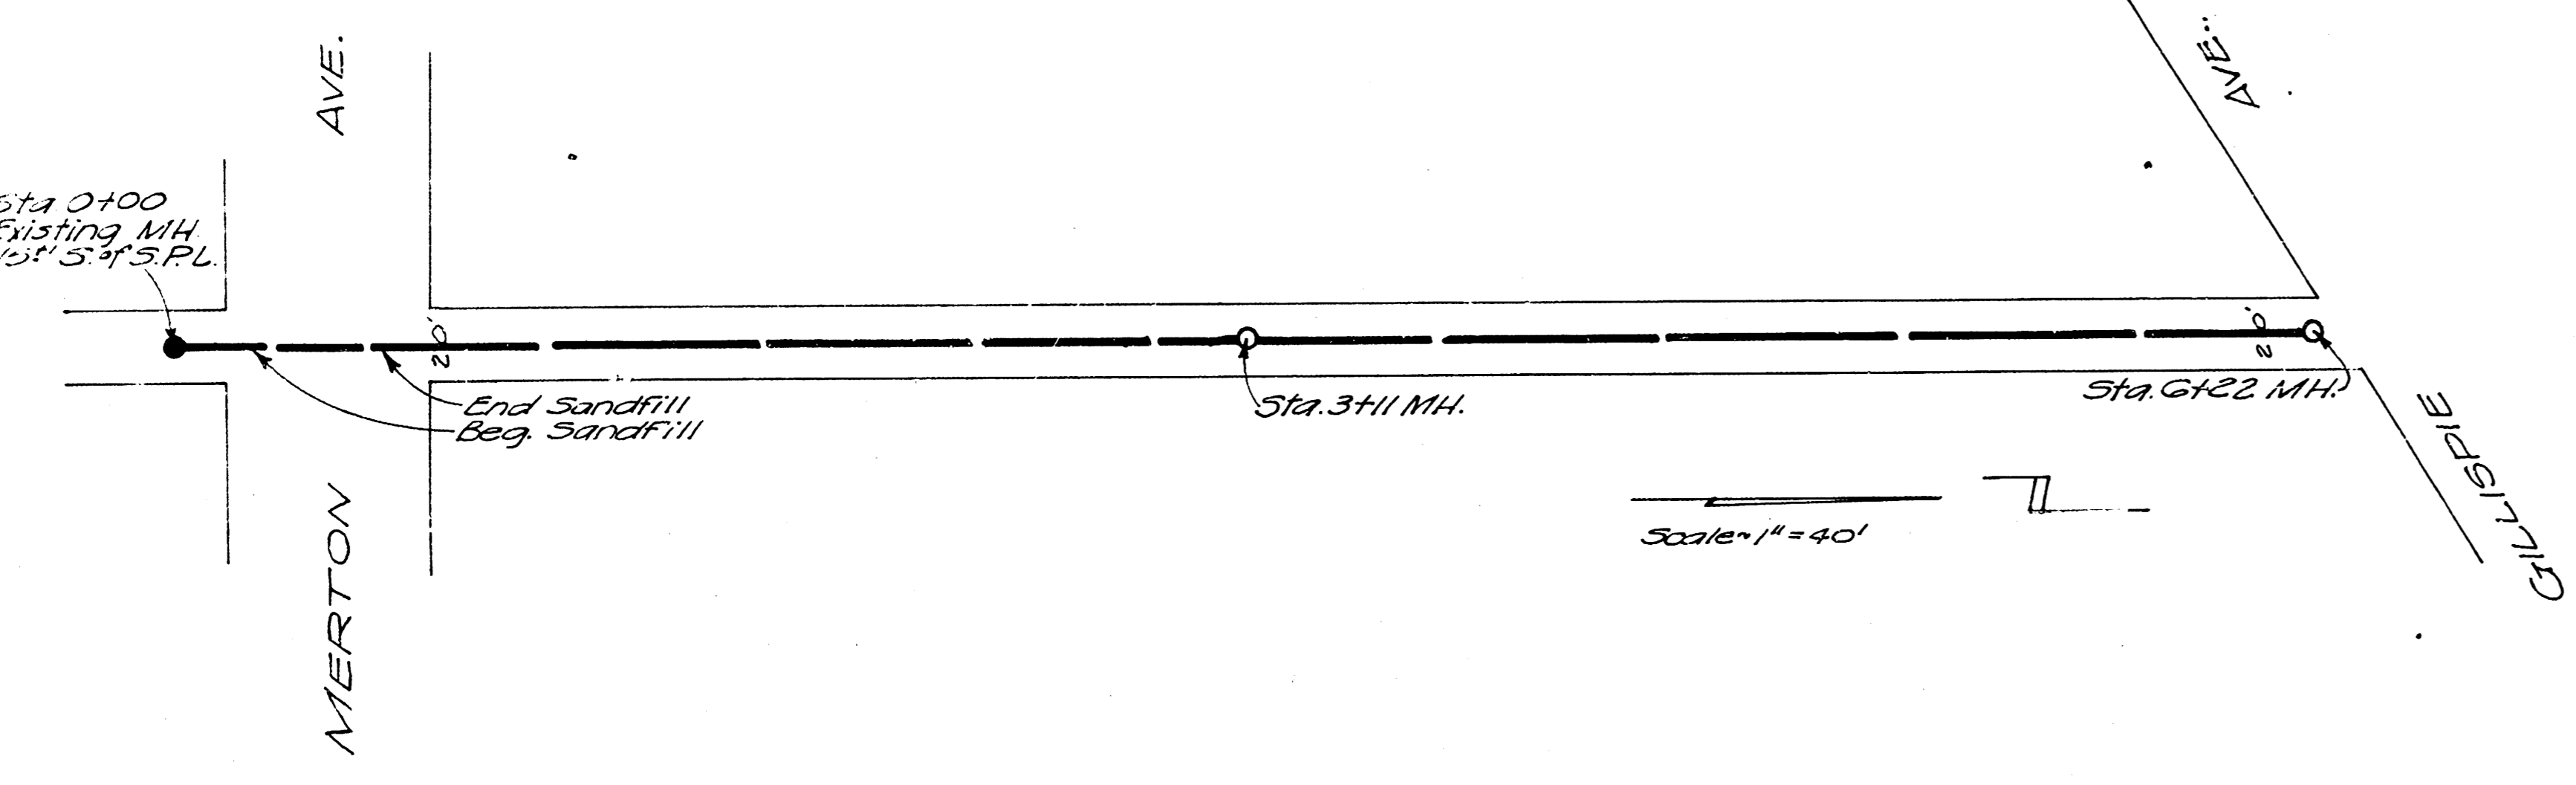
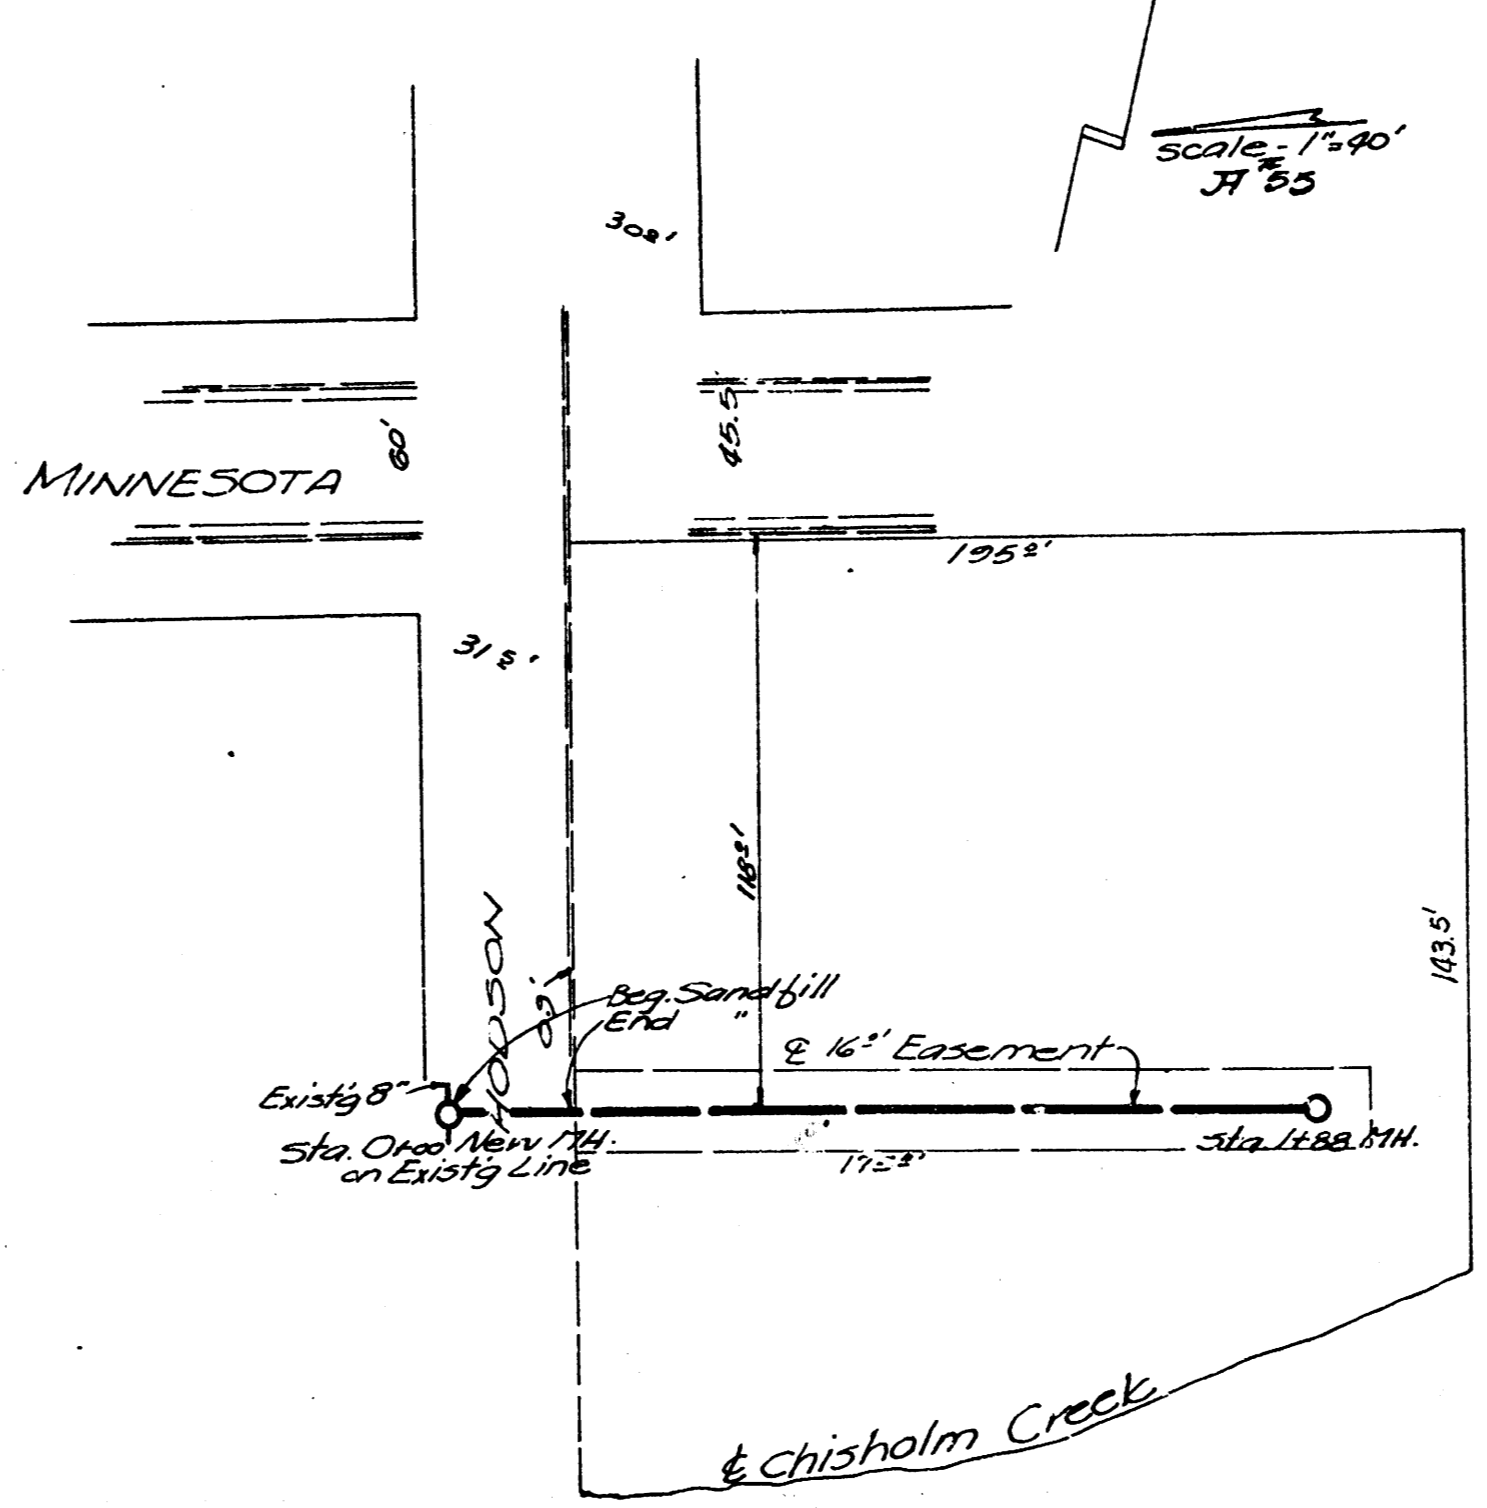
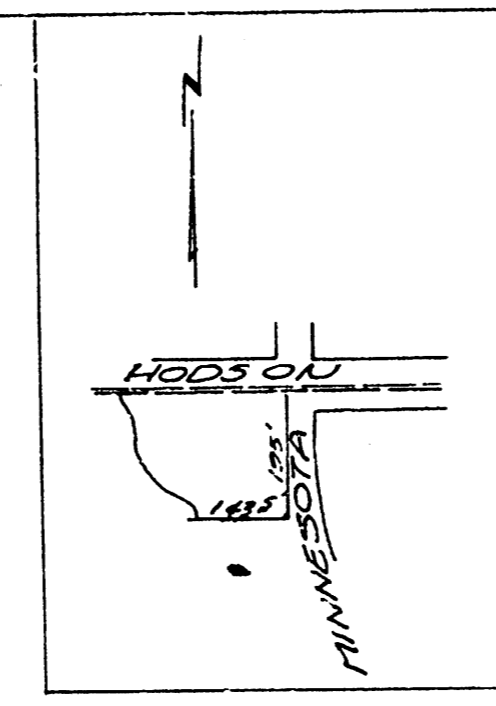


SEE 416

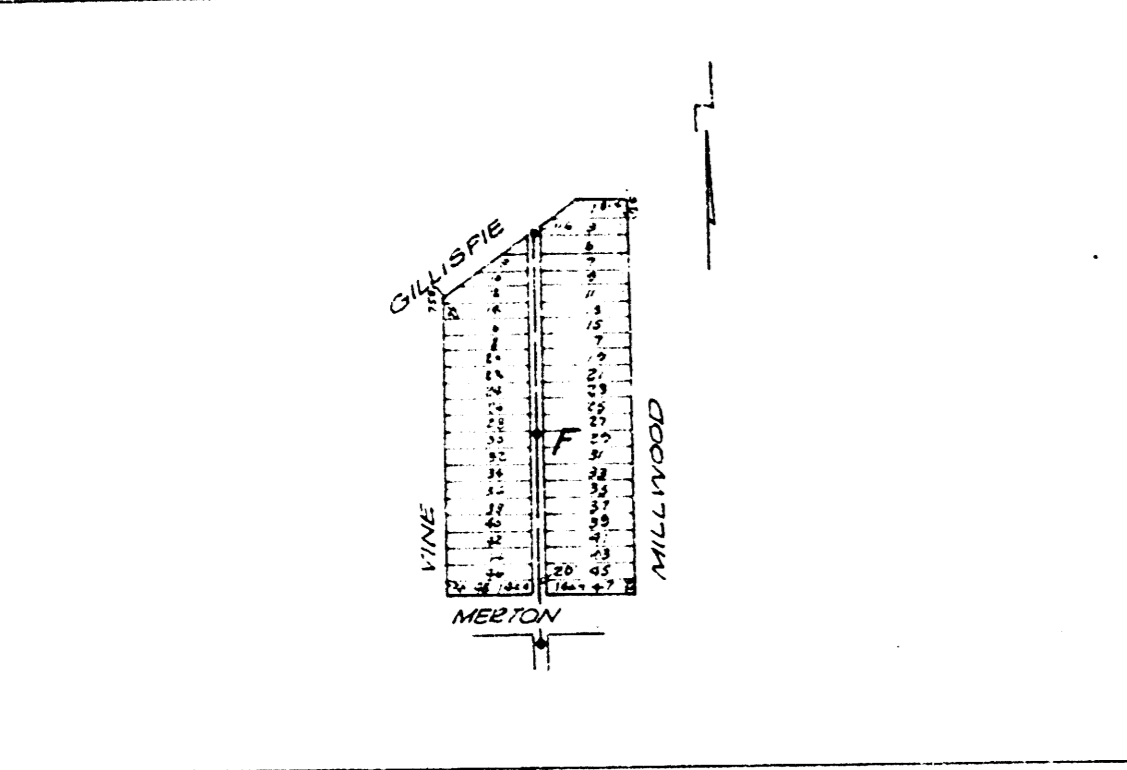

LAT. 19, DIST. B, SANITARY SEWER 20
 LAT. 0, DIST. E, SANITARY SEWER 21
 CITY OF WICHITA, KS.
 L.K. White City Engineer
 1951 C 20-73
 C 21-4

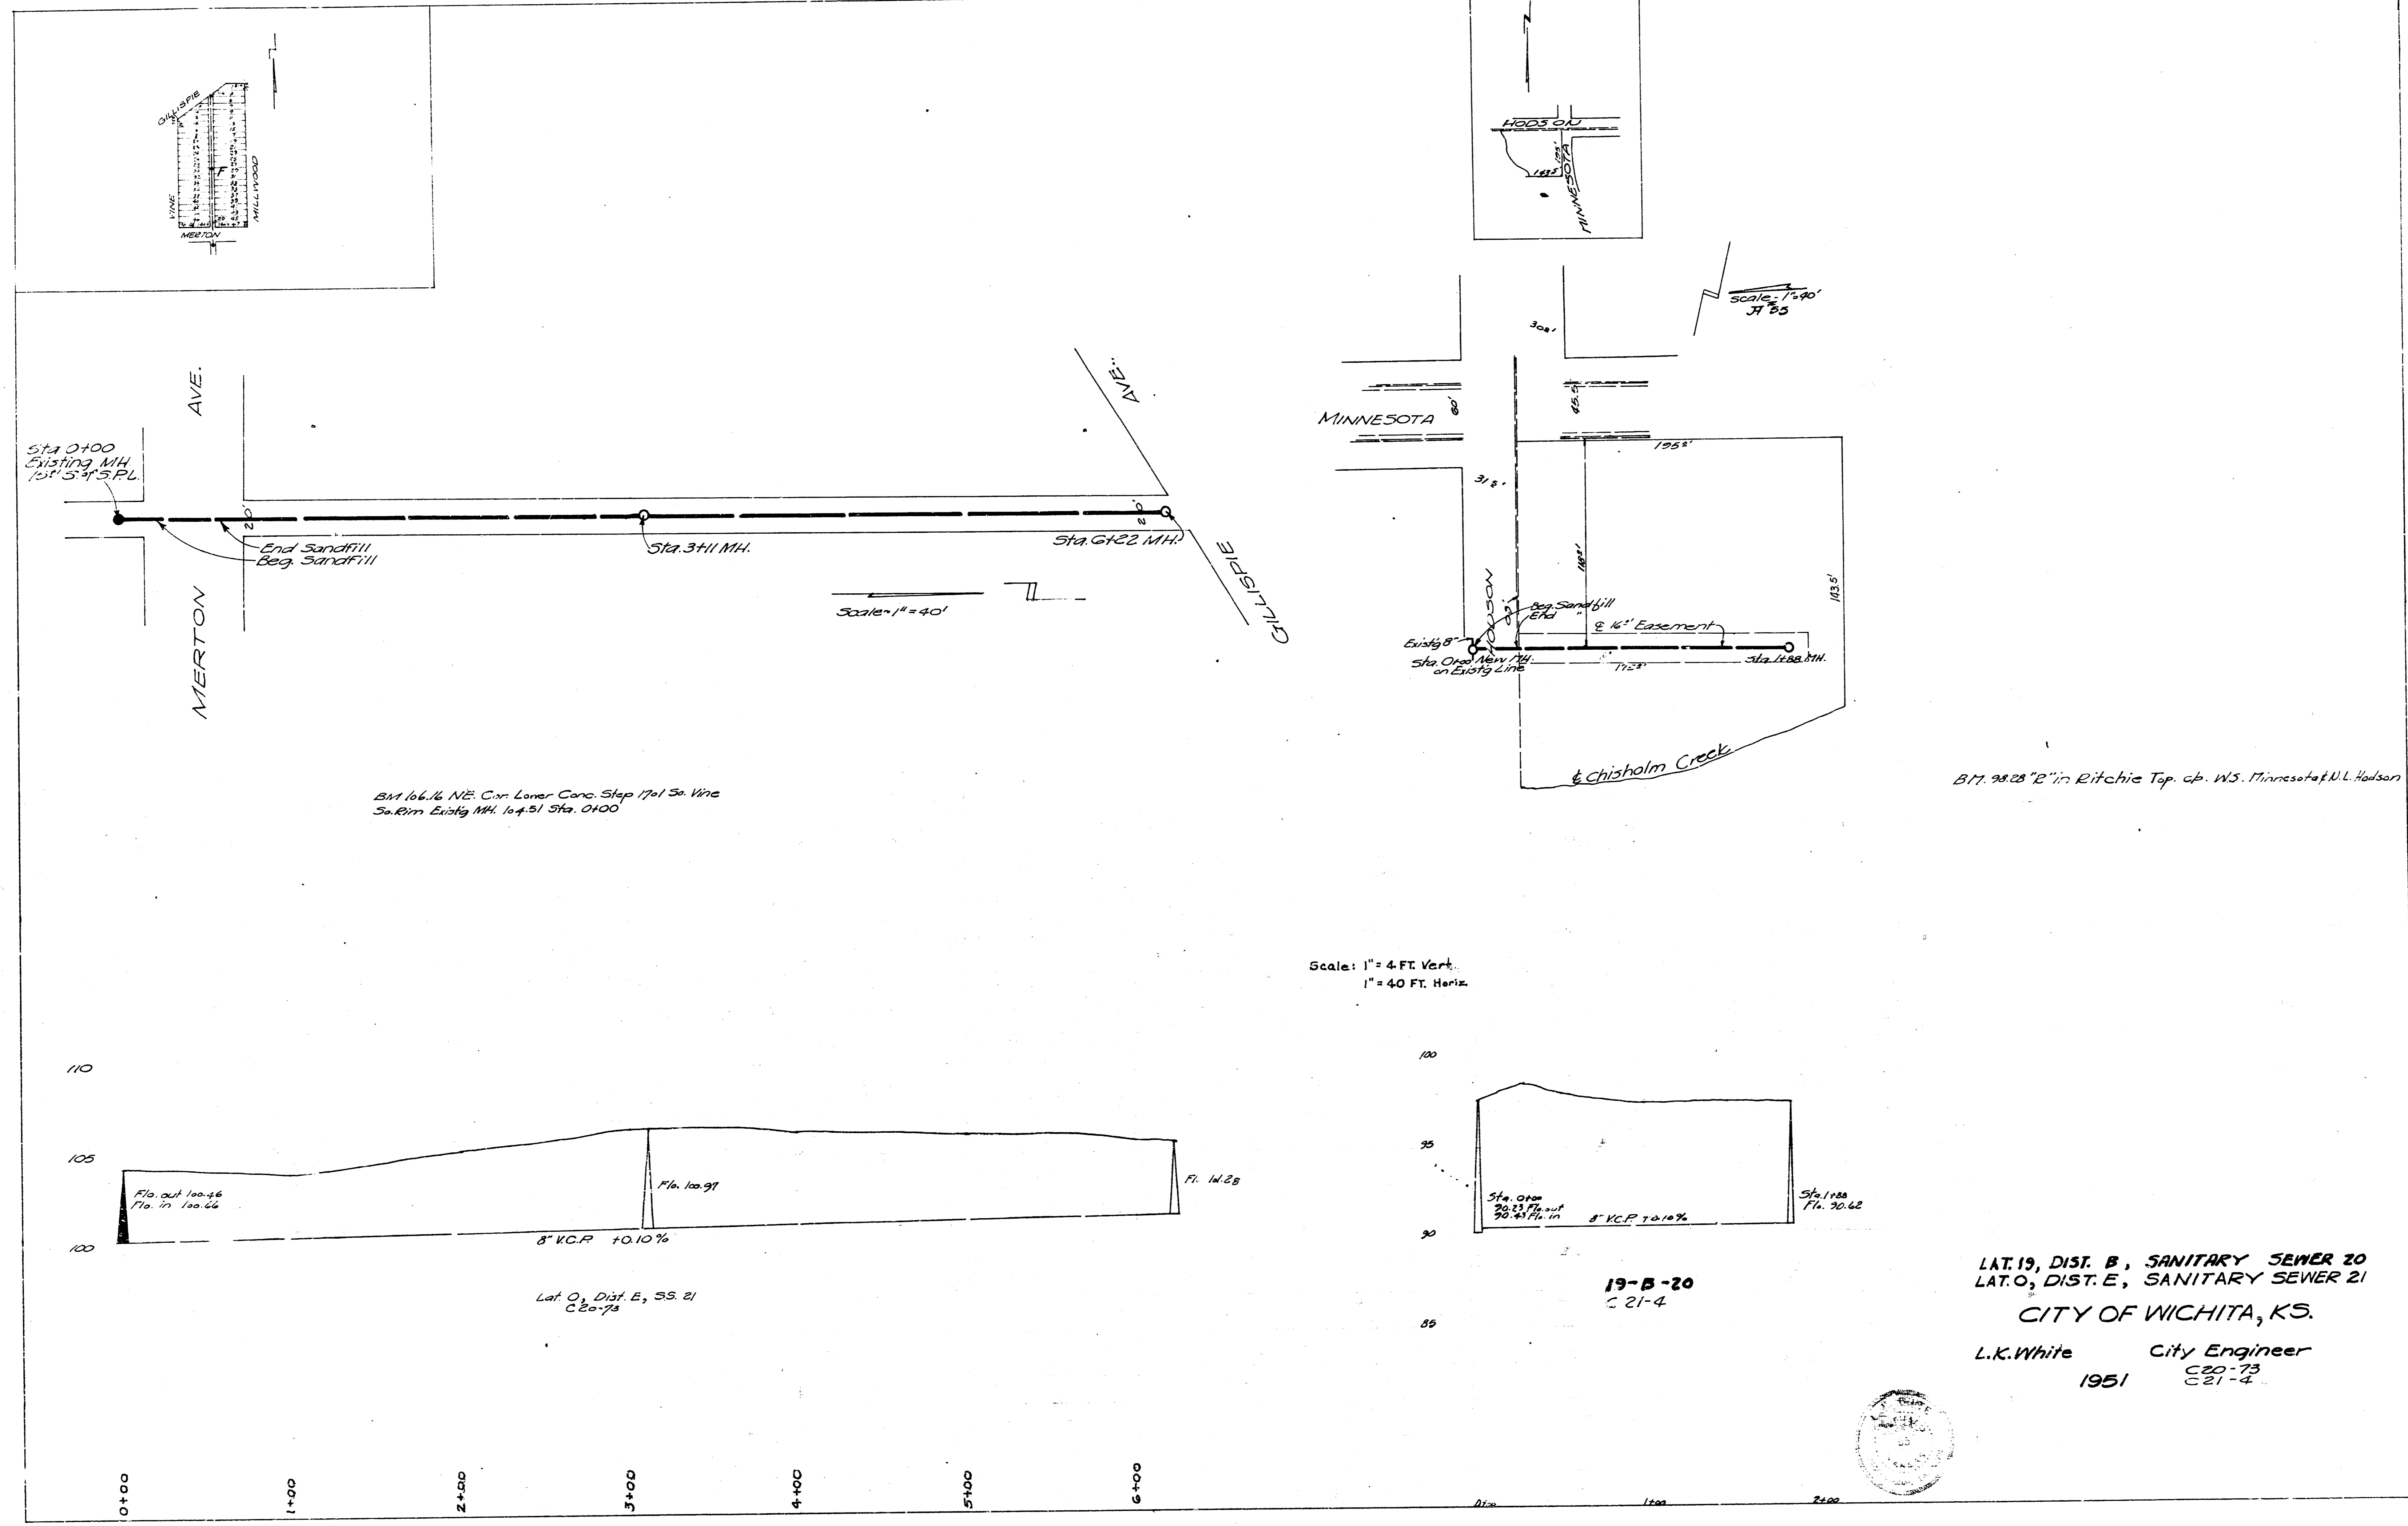