
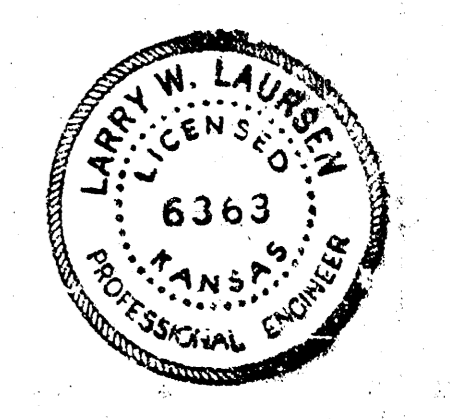




Plan Scale 1" = 40'
 Profile Scale 1" = 40' Horiz.
 1" = 5' Vert.

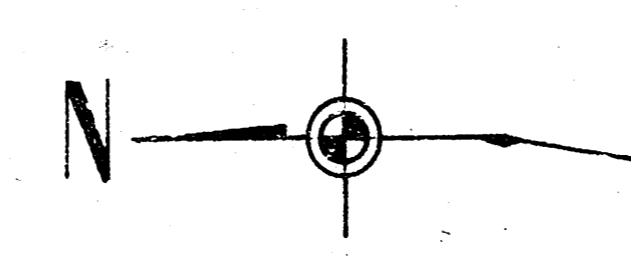

LAT. 26, DIST. B, S. S. NO. 20
PHASE I
CITY OF WICHITA, KANSAS
R. W. LINN — CITY ENGINEER
JAN. 1973 PROJECT NO. DBKL 572074

205


10 SETS - EA
 1 SET - WATER

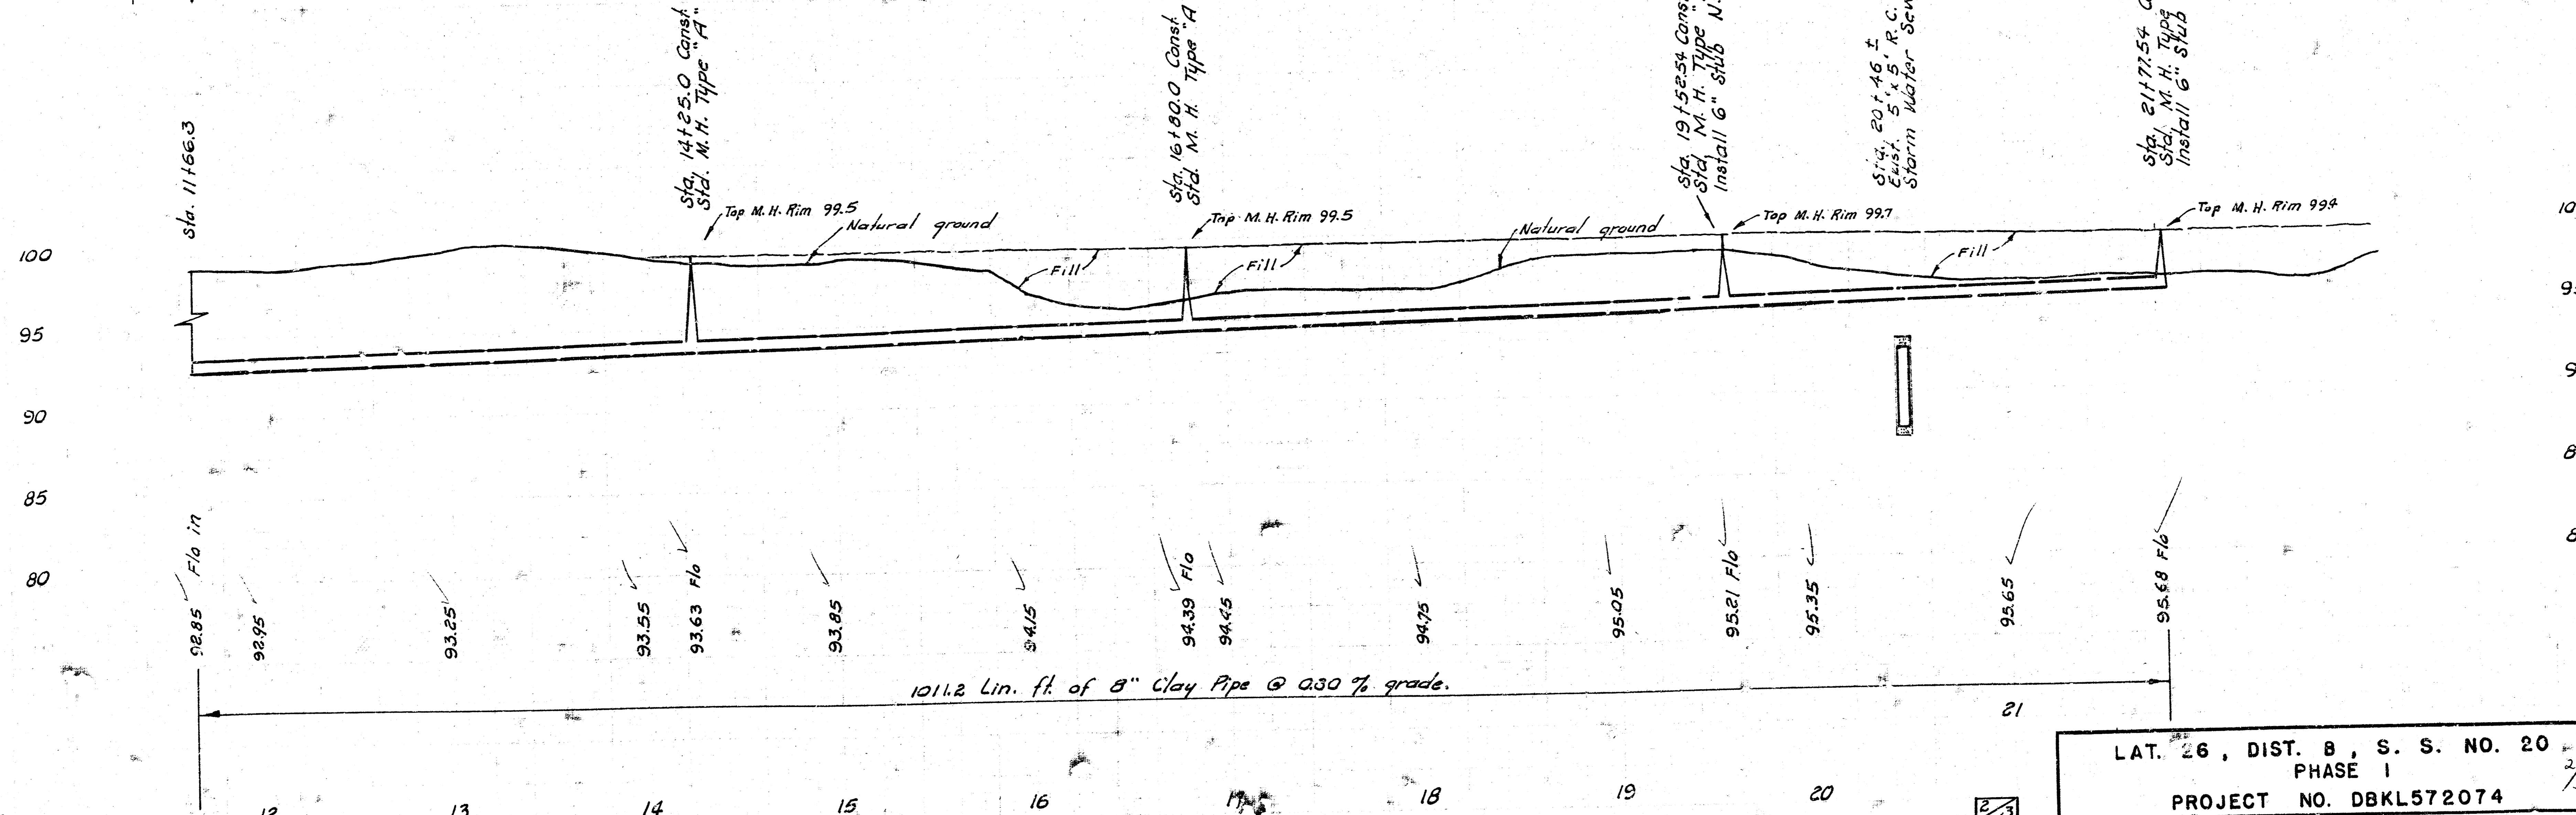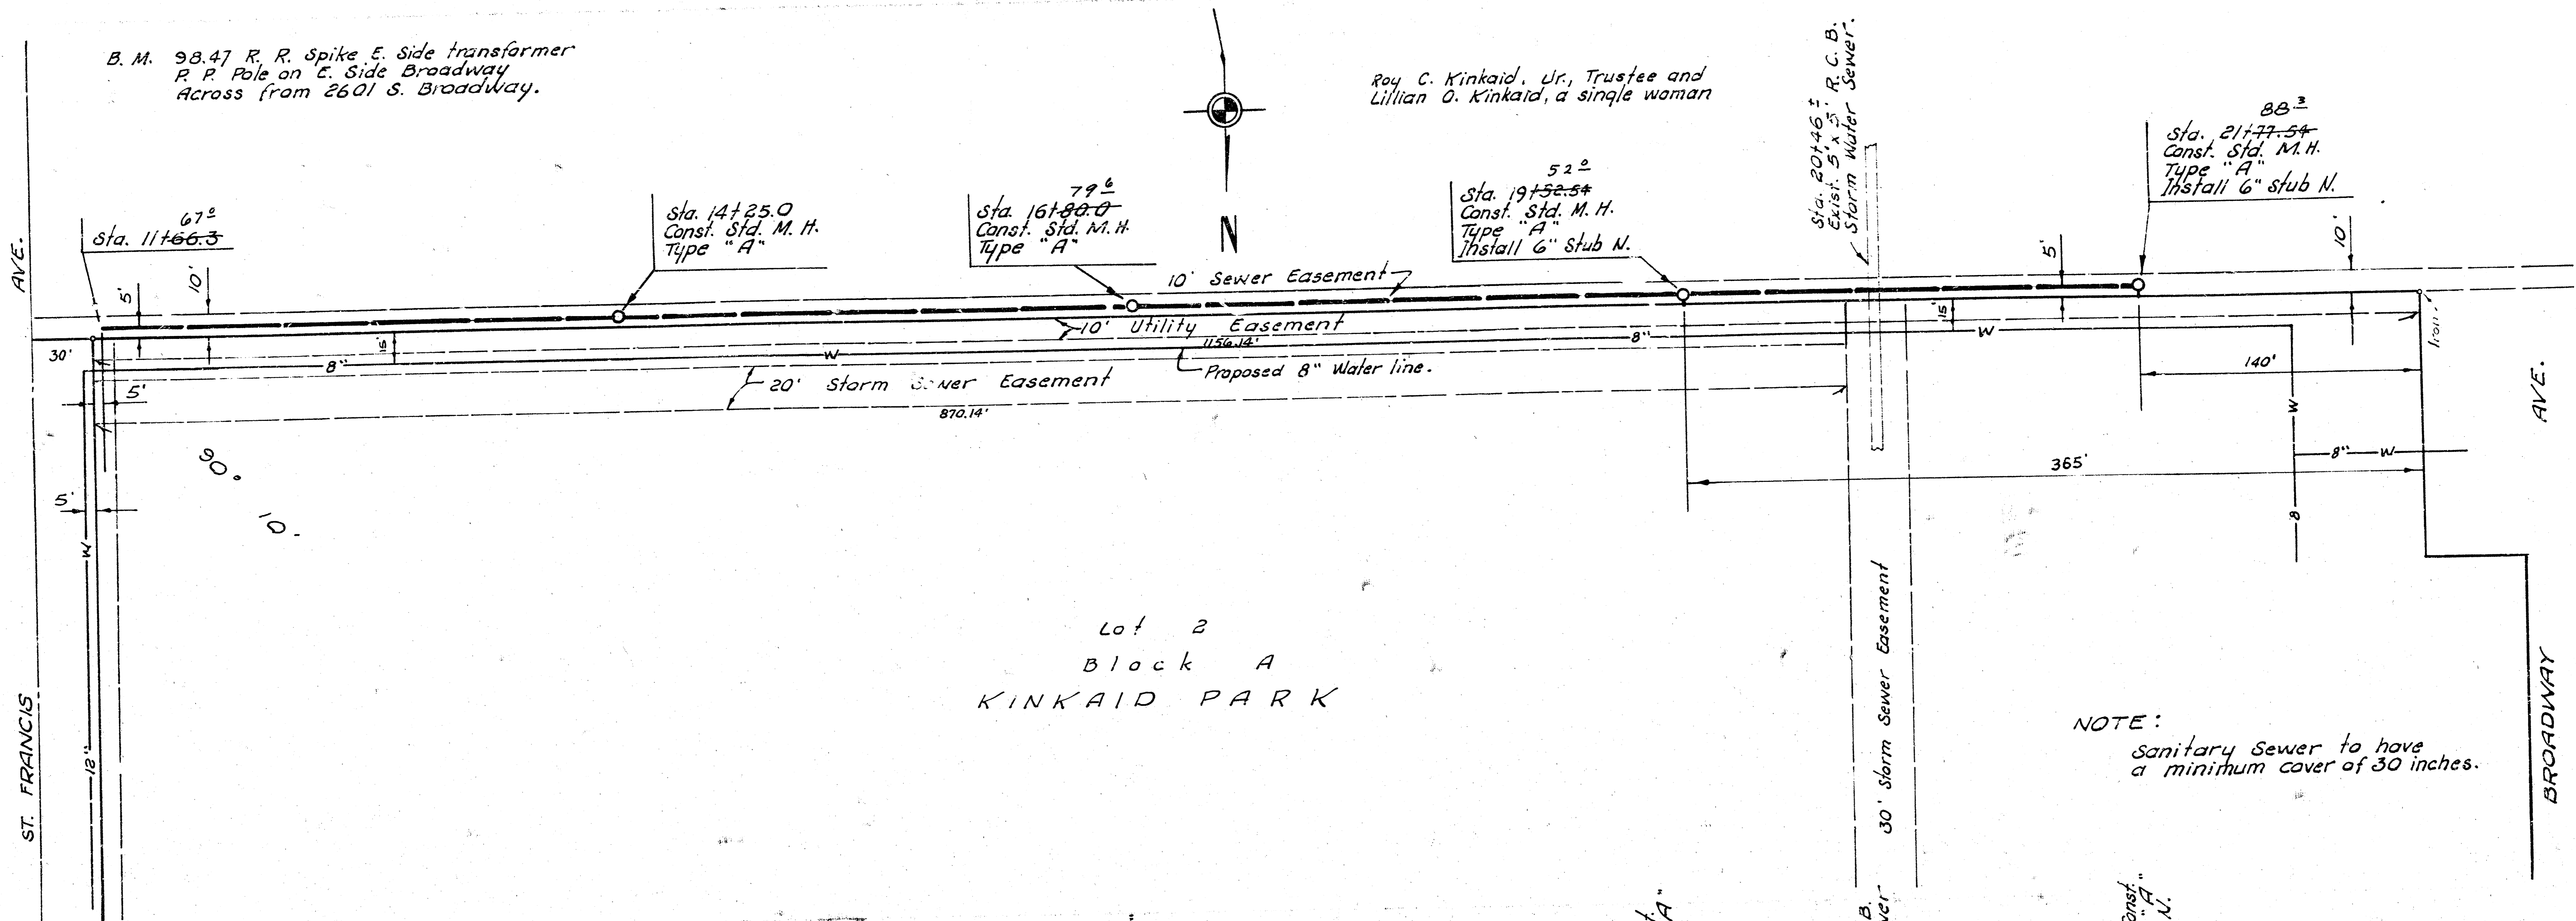

LAT. 26, DIST. 8, S. S. NO. 20
 PHASE I
 PROJECT NO. DBKL572074
 2/3

J. F. W.

205

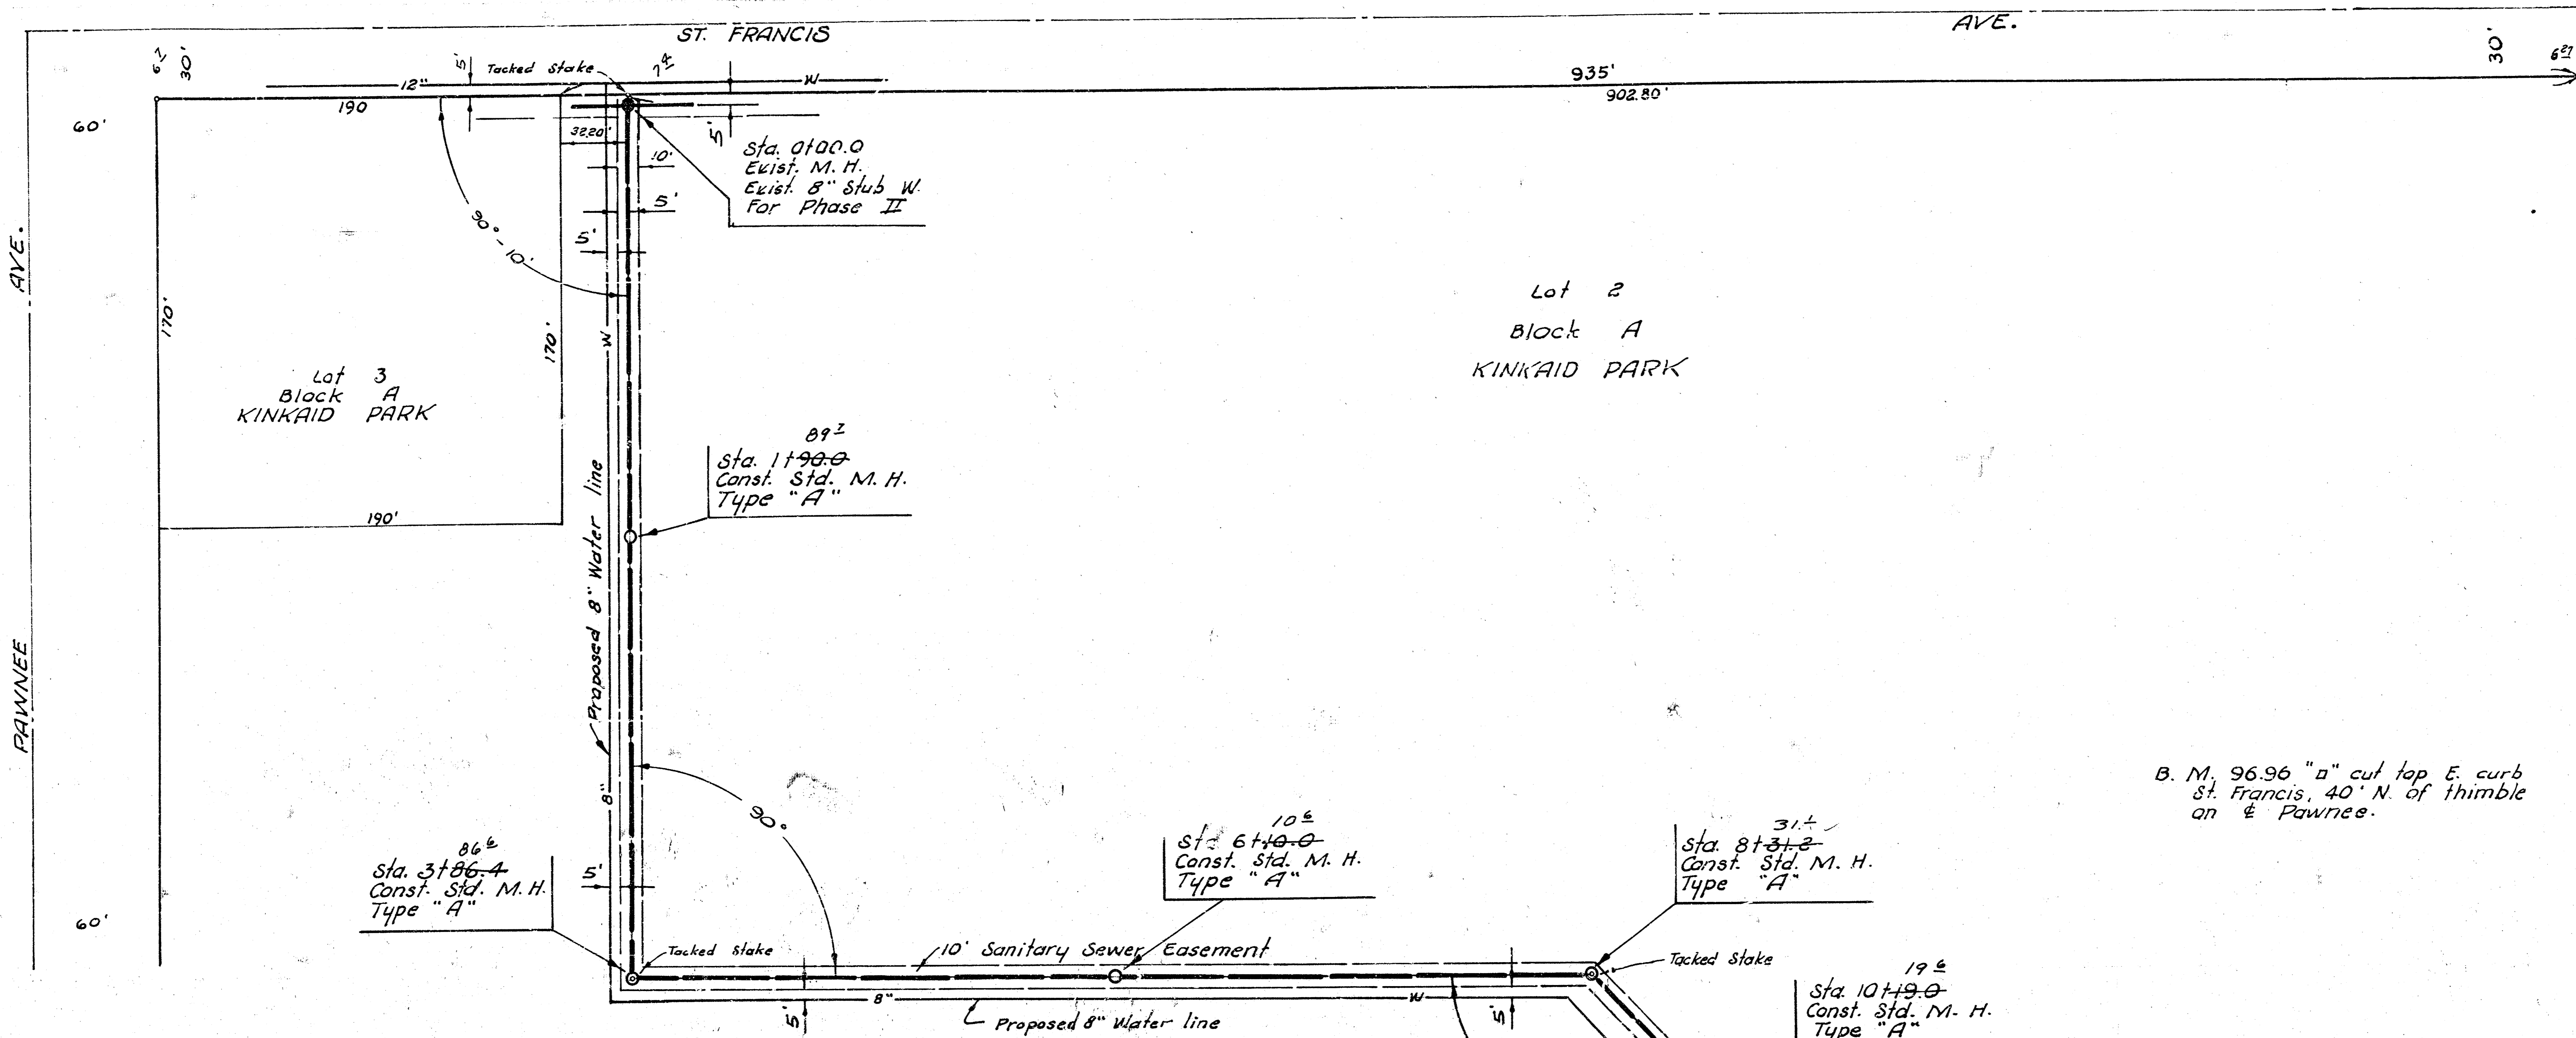

B. M. 96.96 "d" cut top E. curb St. Francis, 40' N. of thimble on E. Pawnee.

