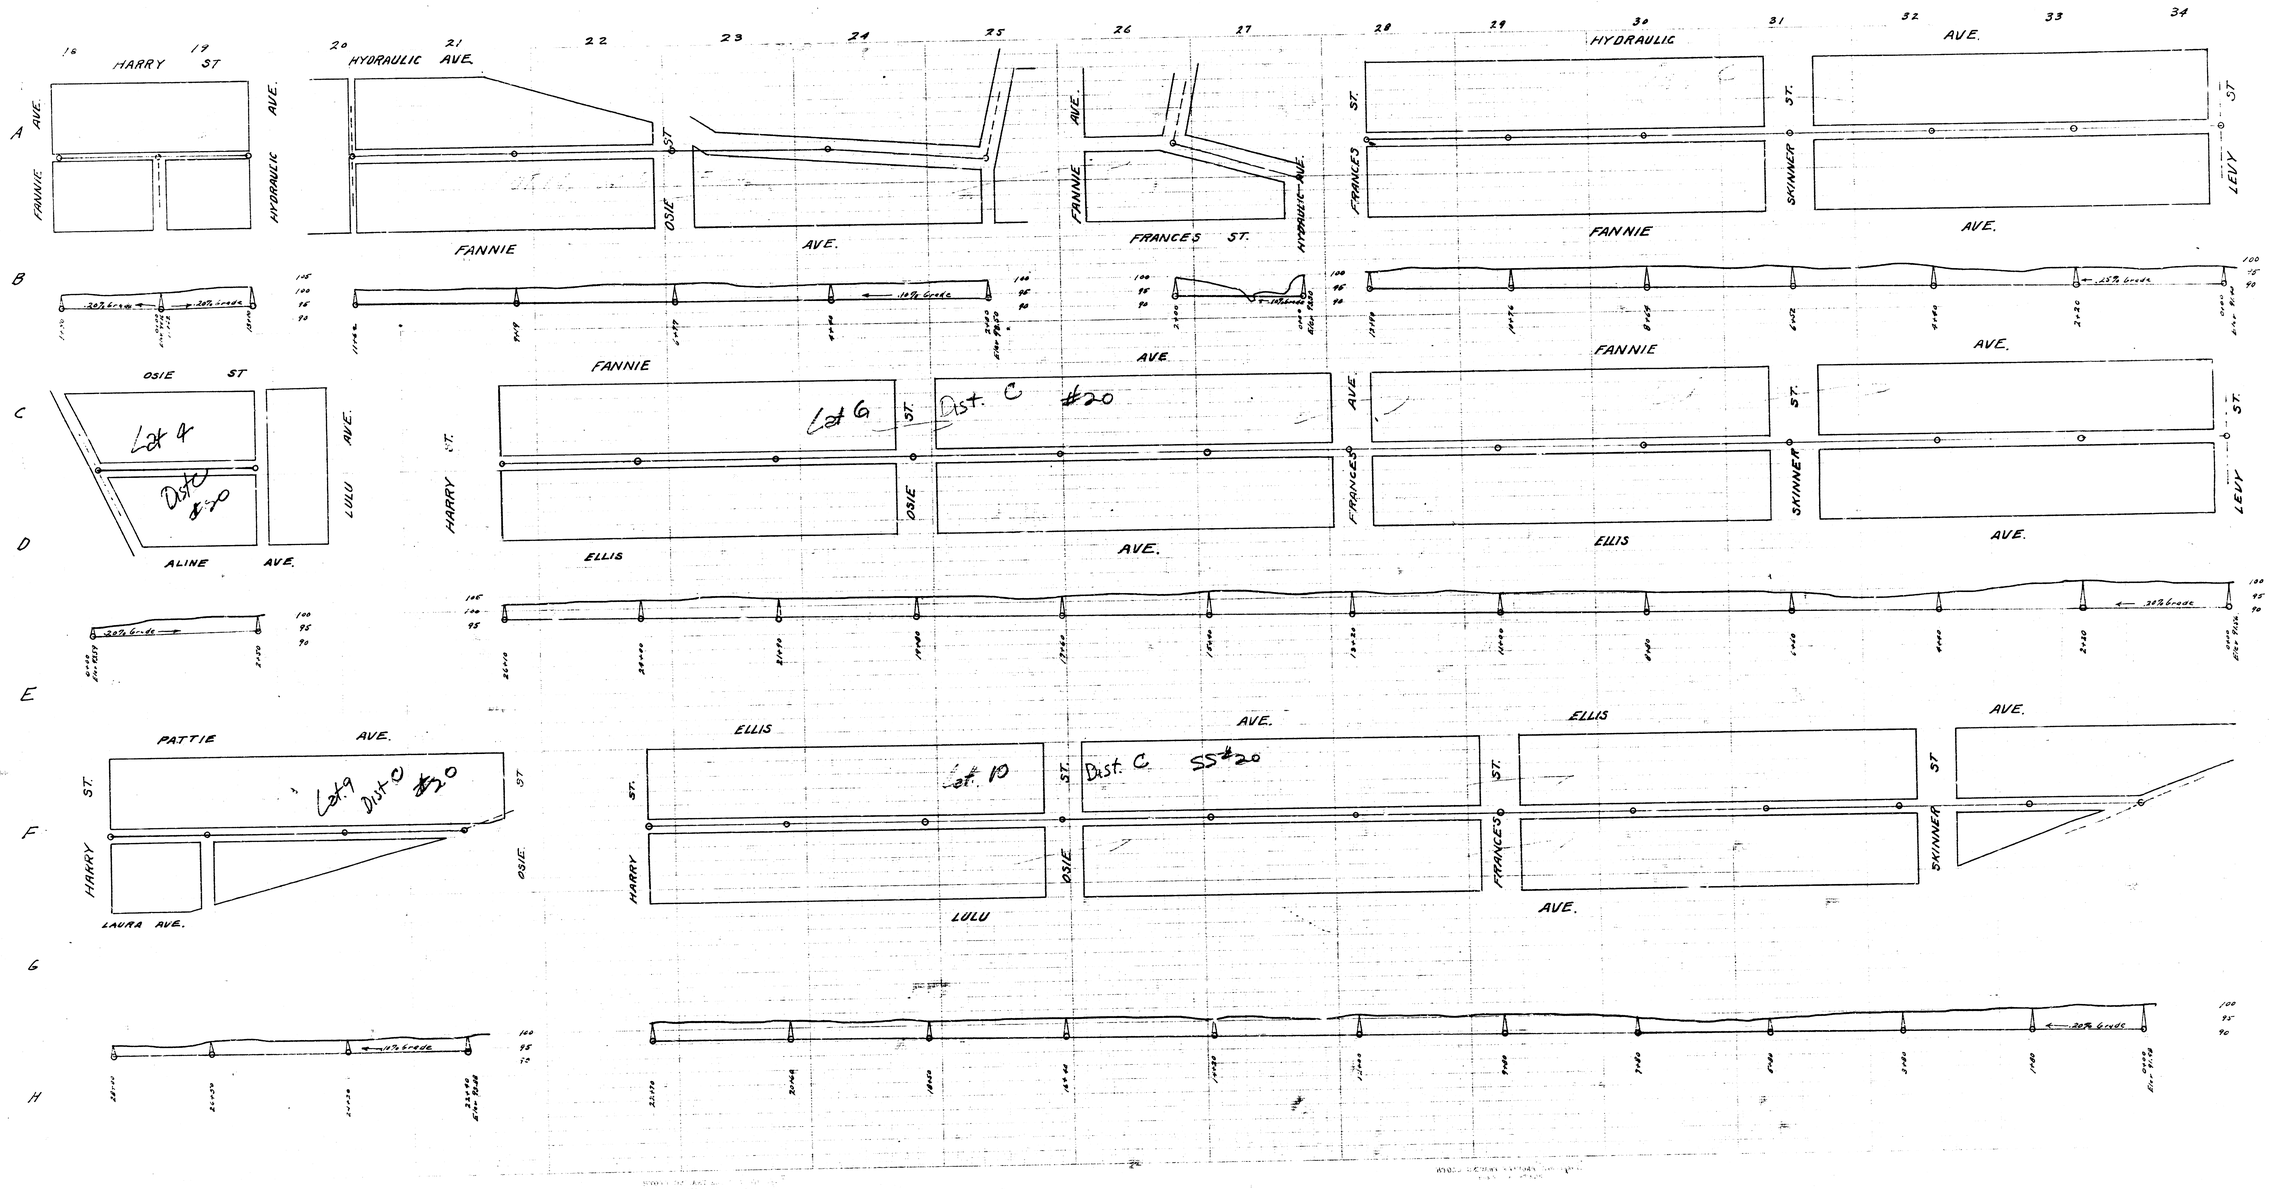
HARRY ST.
HYDRAULIC AVE.
FANNIE AVE.
OSIE ST.
FRANCES ST.
SKINNER ST.
LEVY ST.
LULU AVE.
ALINE AVE.
ELLIS AVE.
PATTIE AVE.
LAURA AVE.
Lot 4 Dist. C #20
Lot 6 Dist. C #20
Lot 9 Dist. C #20
Lot 10 Dist. C SS #20
10% Grade
20% Grade