



ADDITION TO SUBMAIN R SAN. SEWER 20
CITY OF WICHITA, KANSAS
B.E. SMITH CITY ENGINEER
PROJECT NO. C21-69

ADDITION TO SUBMAIN R SAN. SEWER 20
CITY OF WICHITA, KANSAS
B.E. SMITH CITY ENGINEER
PROJECT NO. C21-69

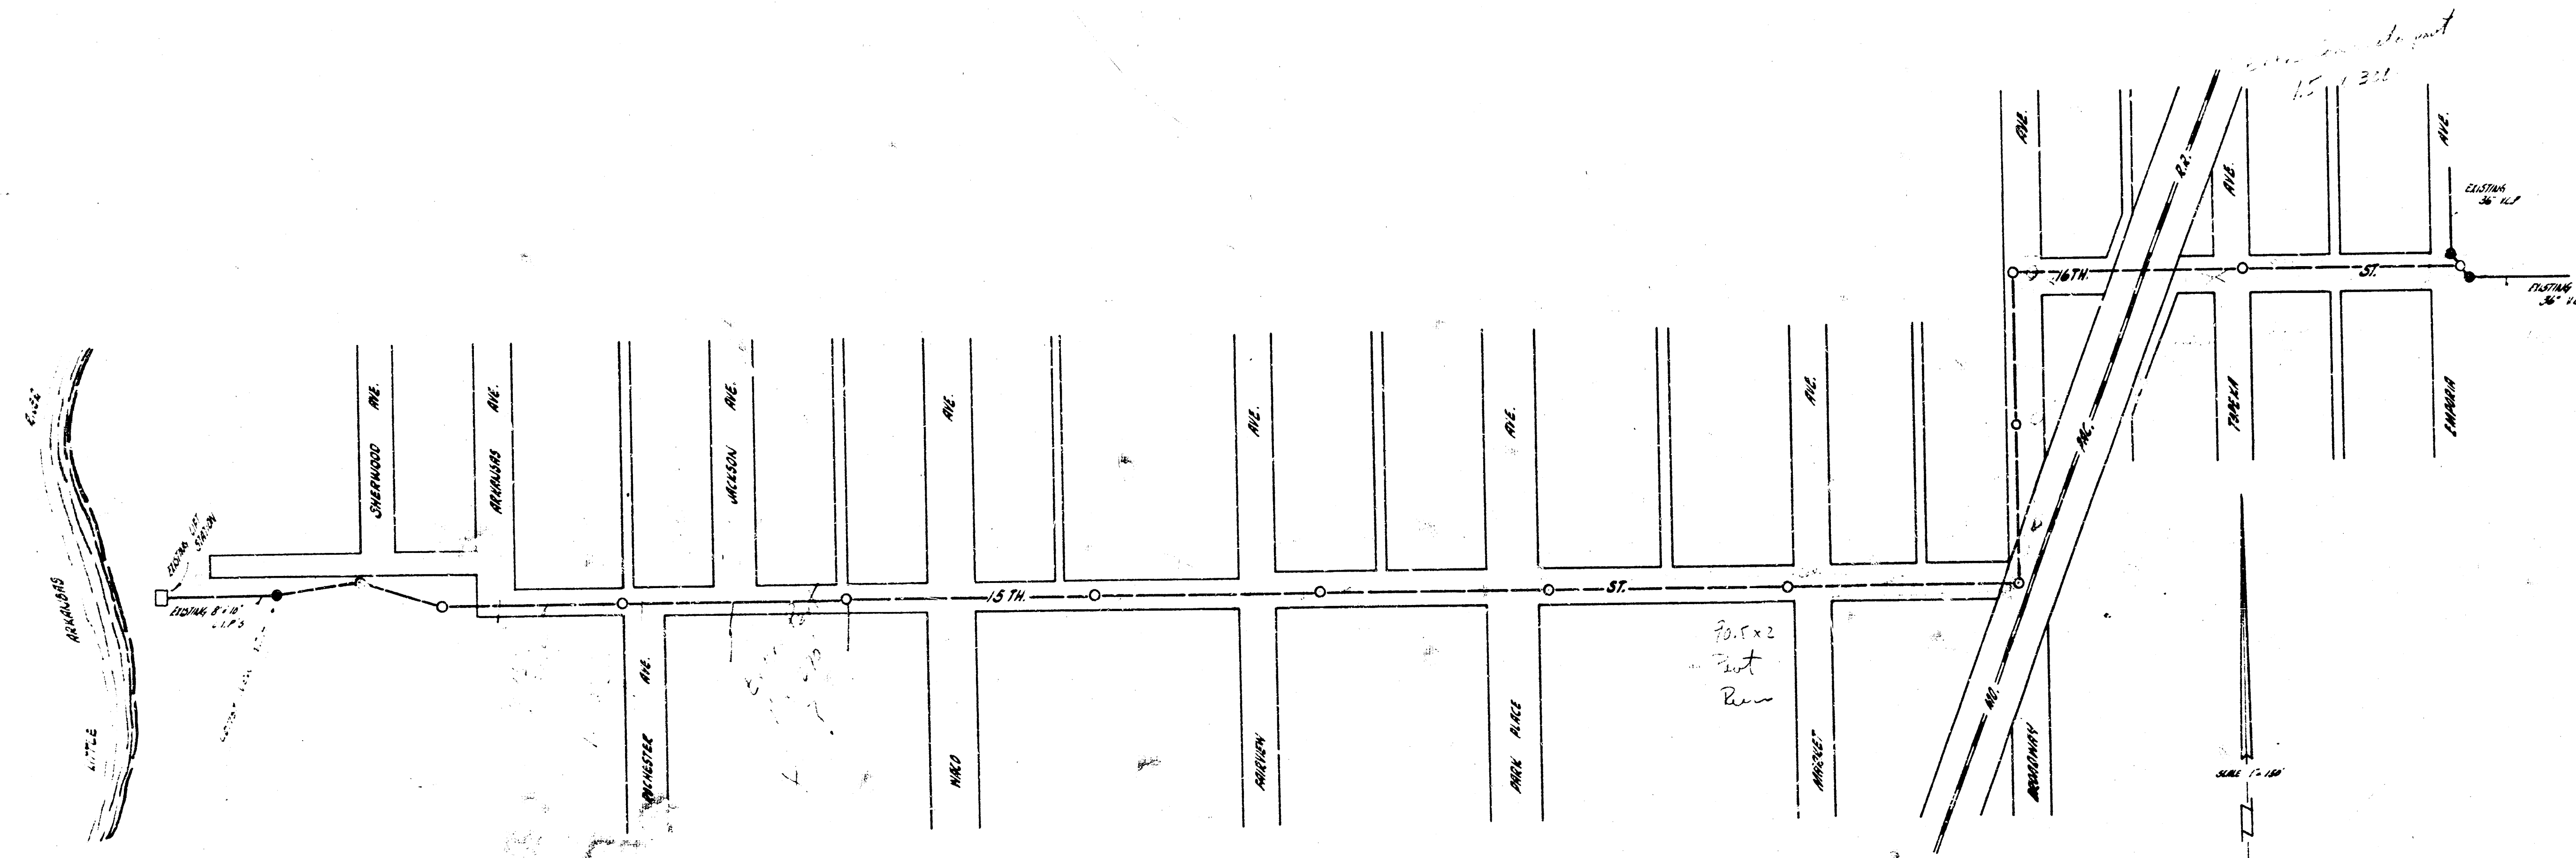


B.E. Smith
City Engineer


ADDITION TO SUBMAIN R SAN. SEWER 20
PROJECT NO. C21-69 12-14-59

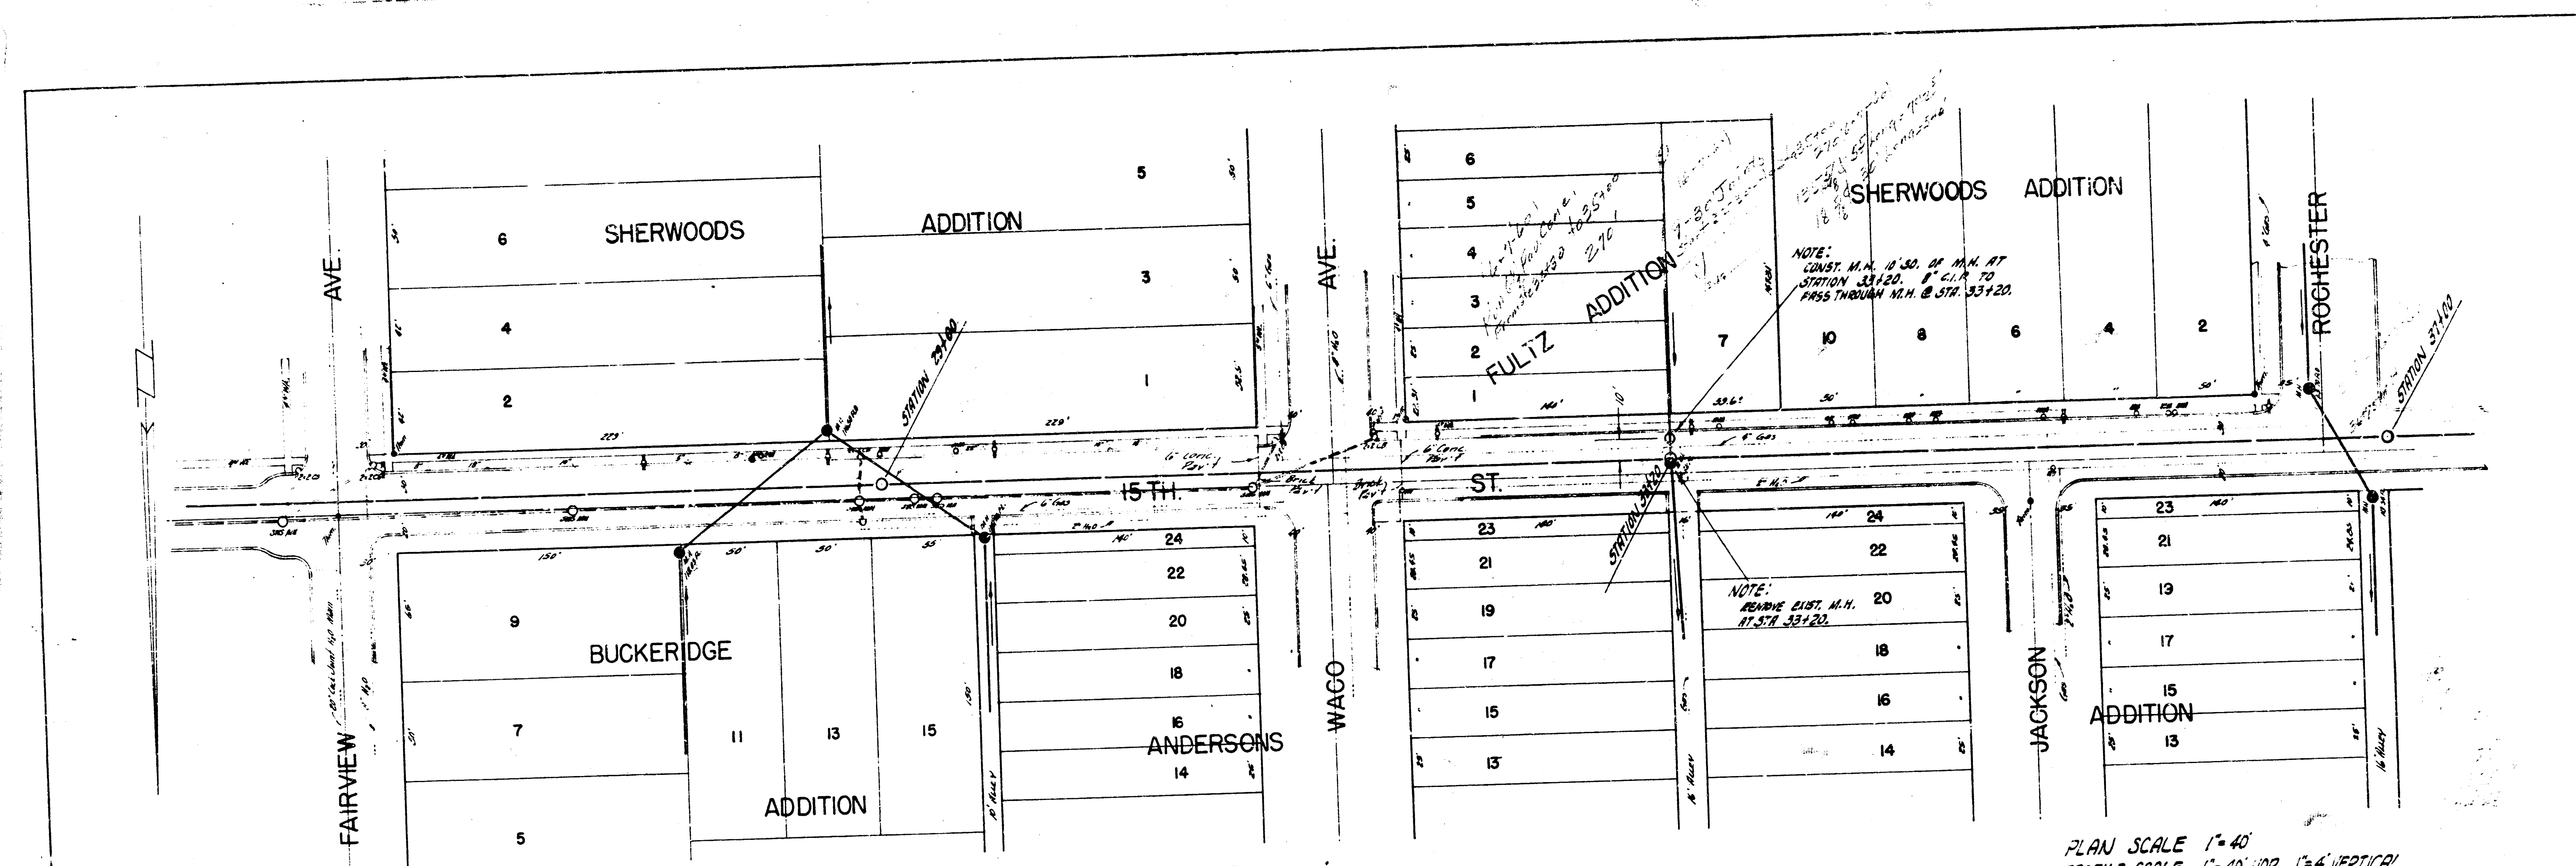

PLAN SCALE 1"=40'
 PROFILE SCALE 1"=40' HOR, 1"=4' VERTICAL


B.M. 120.02 "H" IN HURST ON W.K. 110 AT INT. S.G. SE COR. ROCHESTER & 15TH.

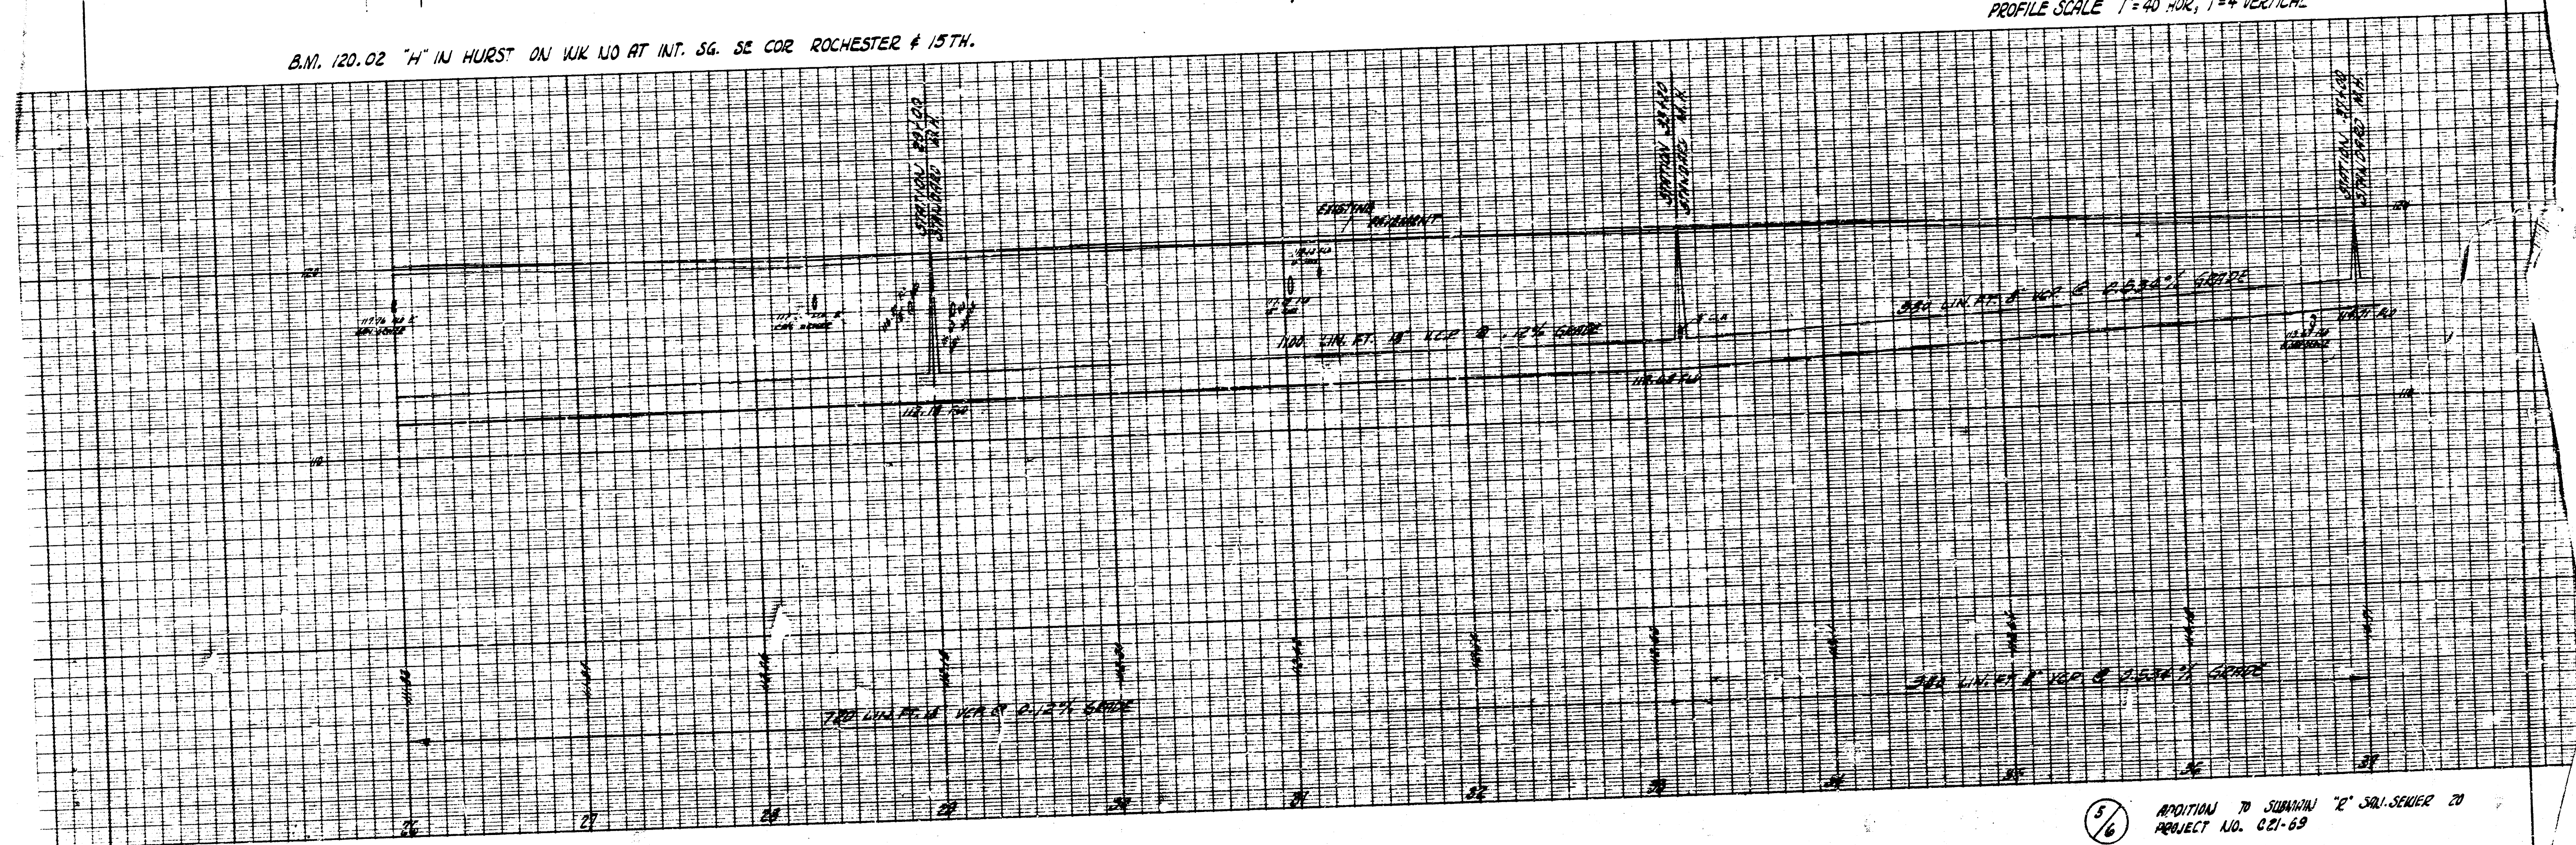

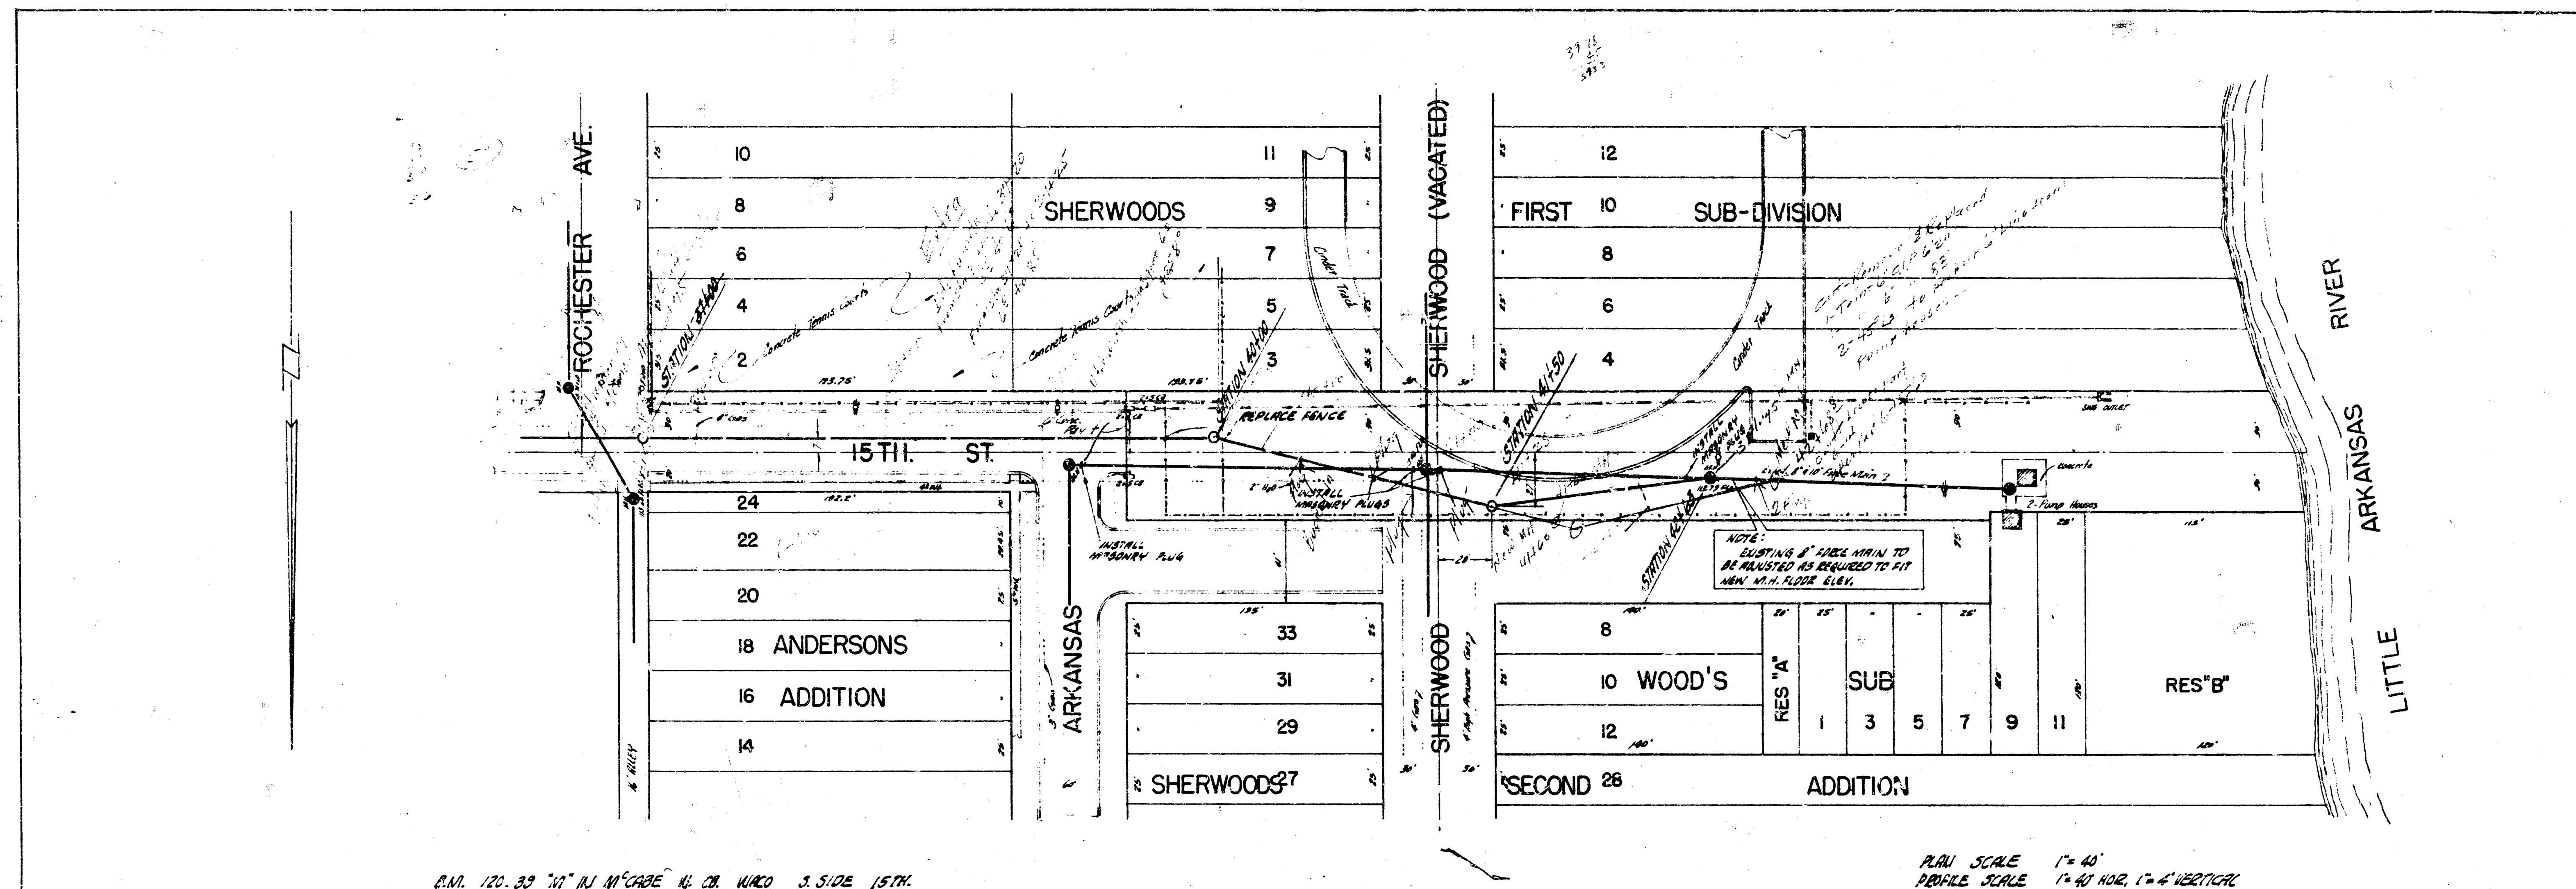


PLAN SCALE 1" = 40'
PROFILE SCALE 1" = 40' HORIZ, 1" = 4' VERTICAL

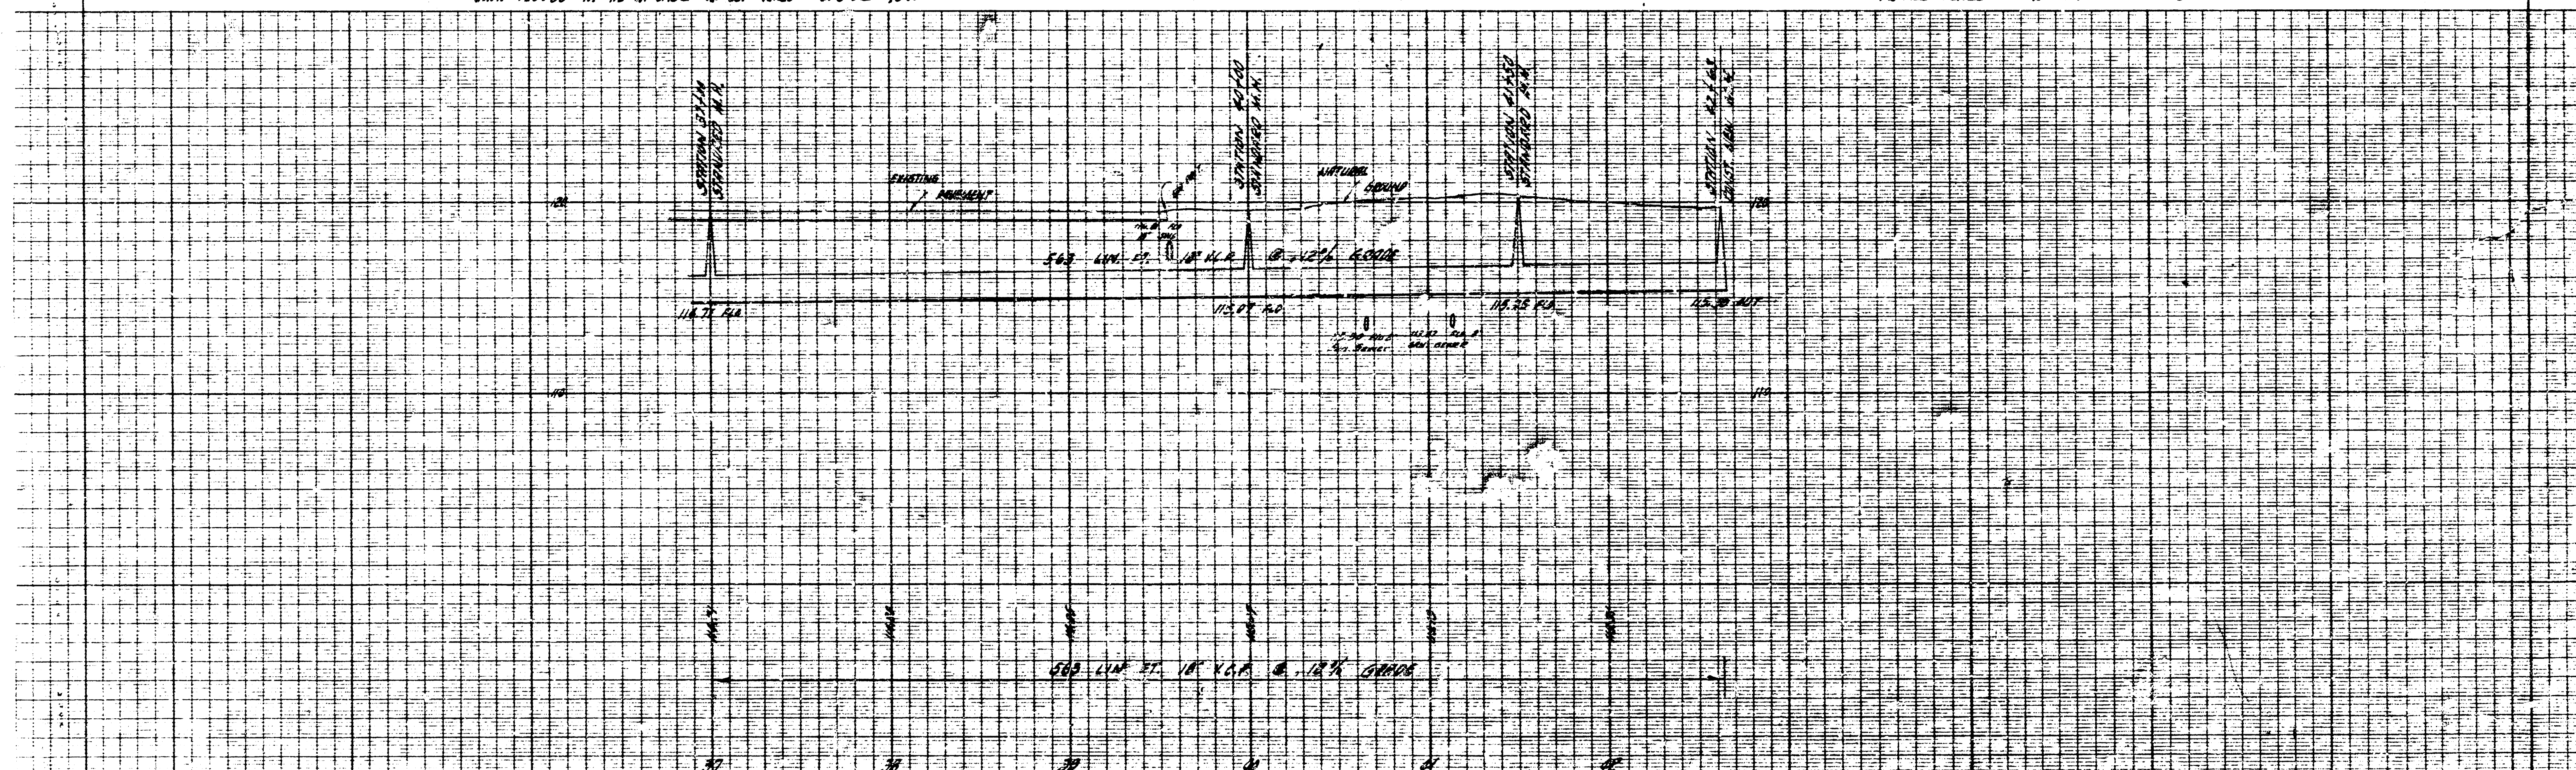

6/6 ADDITION TO SUBDIVISION "R" SUB. SERIES 20
PROJECT NO. C21-69