

LAT. V, DIST. R, S.S. #20
WICHITA, KANSAS

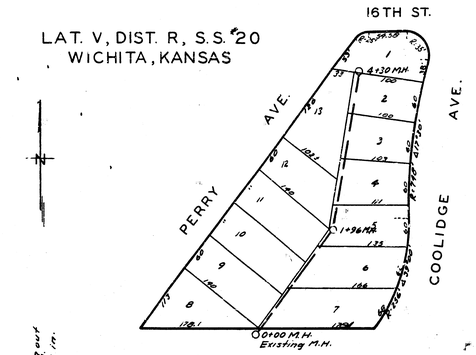


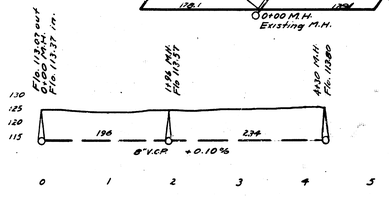


B.M. 124.00 N.W. Cor. Wk. So.
S.W. Cor. Coolidge & Parker

ENGINEERING DEPARTMENT
CITY OF WICHITA KANSAS
P.L. BROCKWAY CITY ENGINEER
B.E. SMITH ENGINEER OF DESIGN
SEPT. 1941 DRAWN BY W.C.R.


LAT. A, DIST. F, S.S. #21
WICHITA, KANSAS

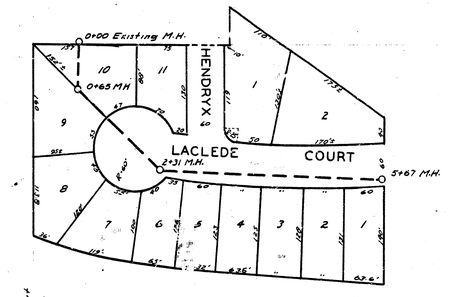


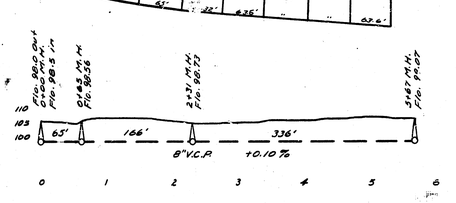

B.M. 108.21 N.E. Cor. E. Brick Pillar front of Ho. # 503 (Front yard pillar)


LAT. H, DIST. T, S.S. #20 WICHITA, KANSAS

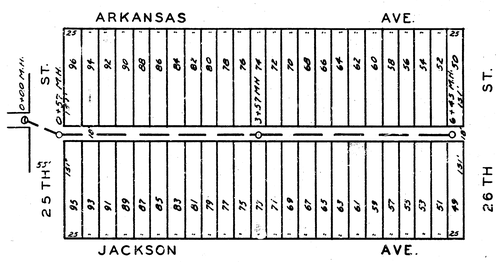


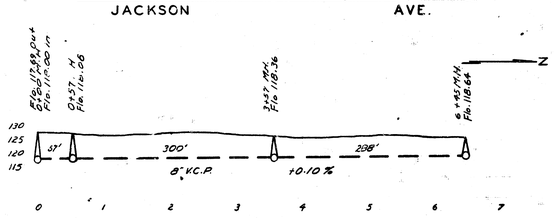

B.M. 126.71 Iron in thim. 25TH & Ark.
B.M. 126.89 Sp. nail in P.P. 15' No. of M.H.

LAT. M, DIST. B, S.S. 20 WICHITA, KANSAS

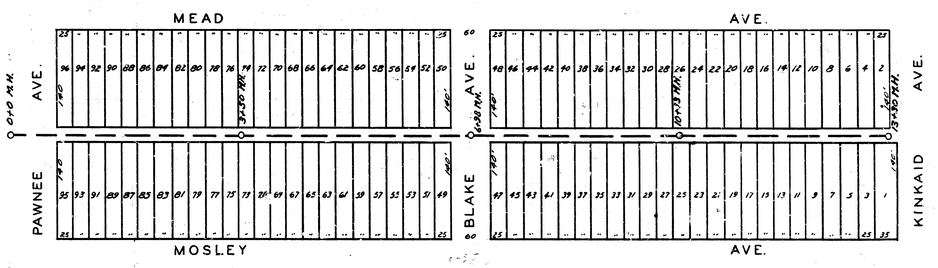

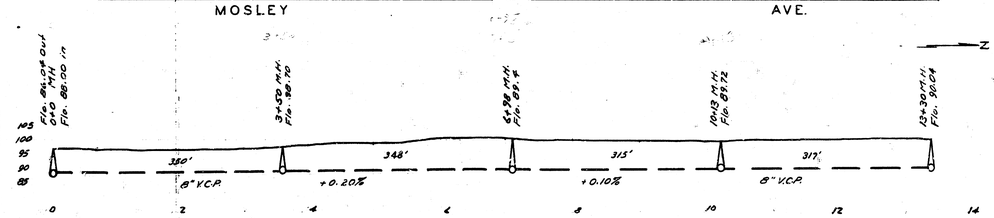

B.M. 100.42 Std. N.E. Cor. Levy & Wash.
B.M. Stephench in P.P. N.S. Clark 102.94
B.M. " " " N.S. Kinkaid @ Alley 102.55

B.M. 101.43 Sp.-nail in T.P. W.S. Alley @ Blake
B.M. 97.97 " " " P.P. on N.S. Pawnee @ alley bet. Mosley & Mead.