

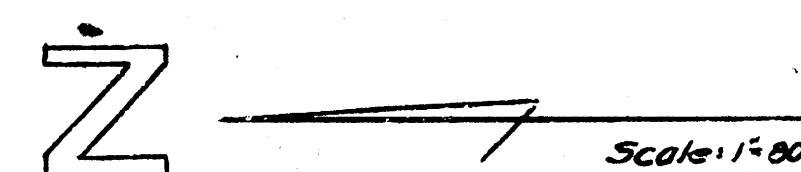


Date 9-18-52
 Drawn by MacLean
 Check by Book No. 33Y

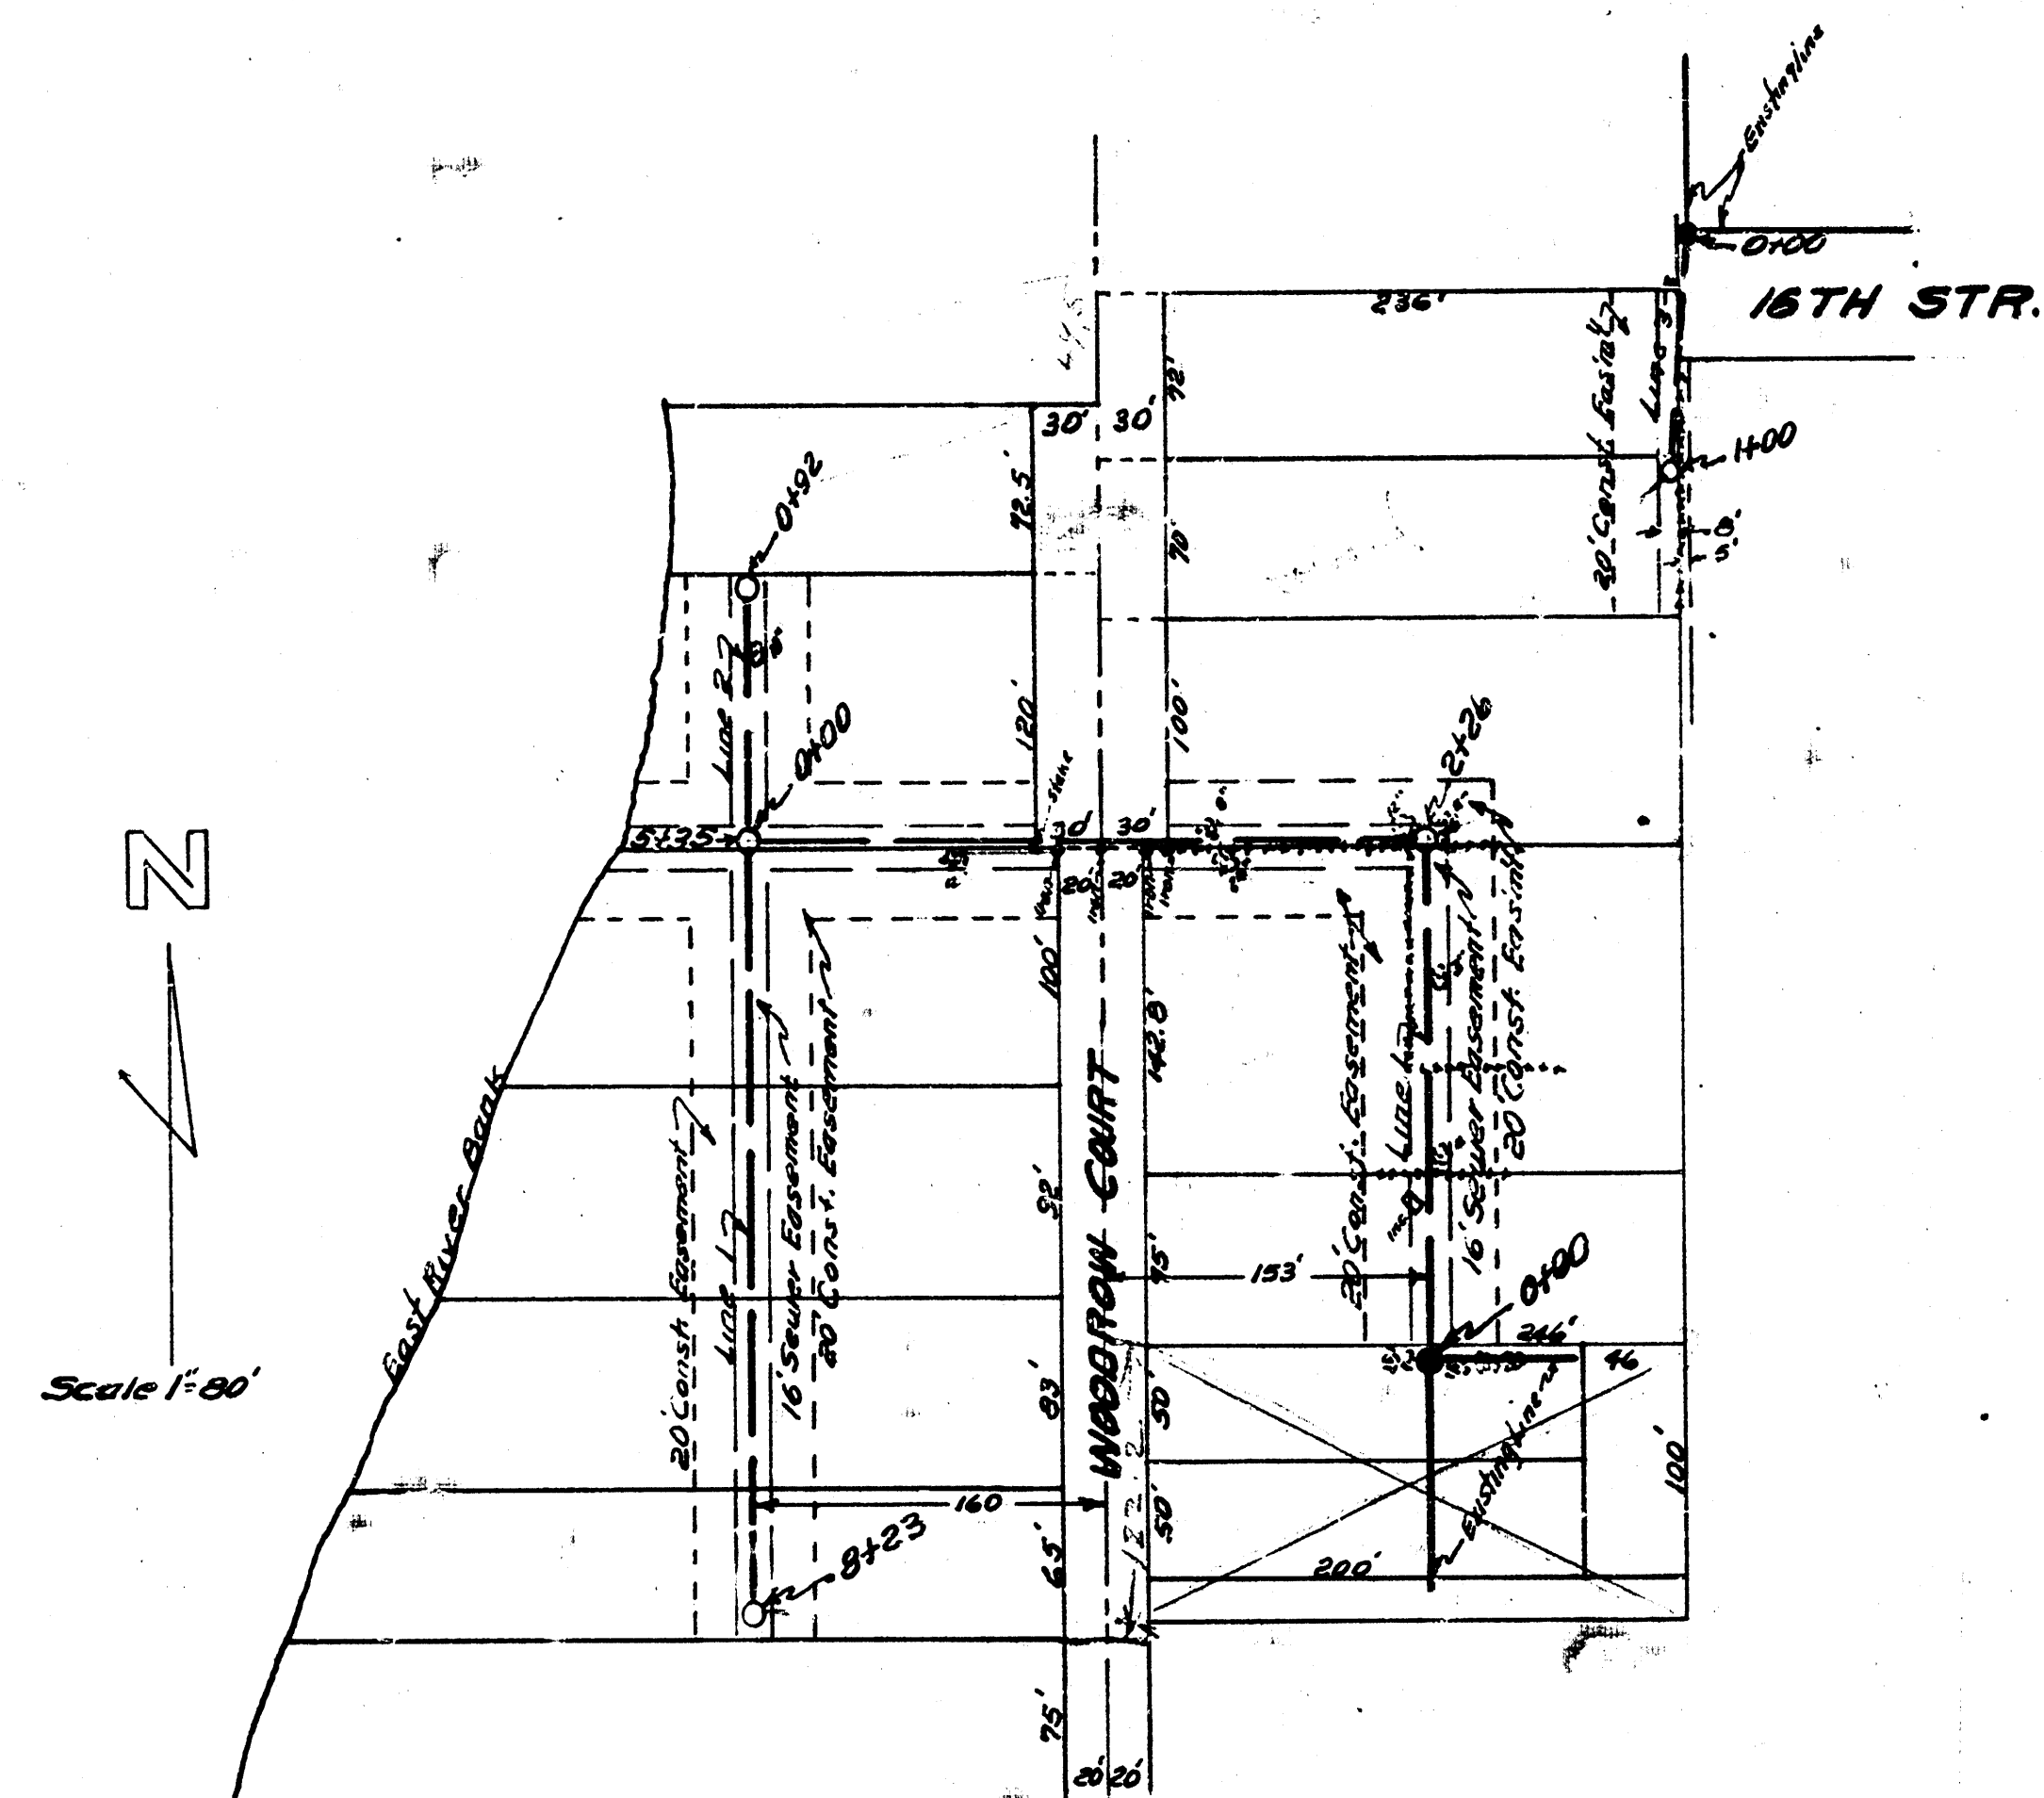


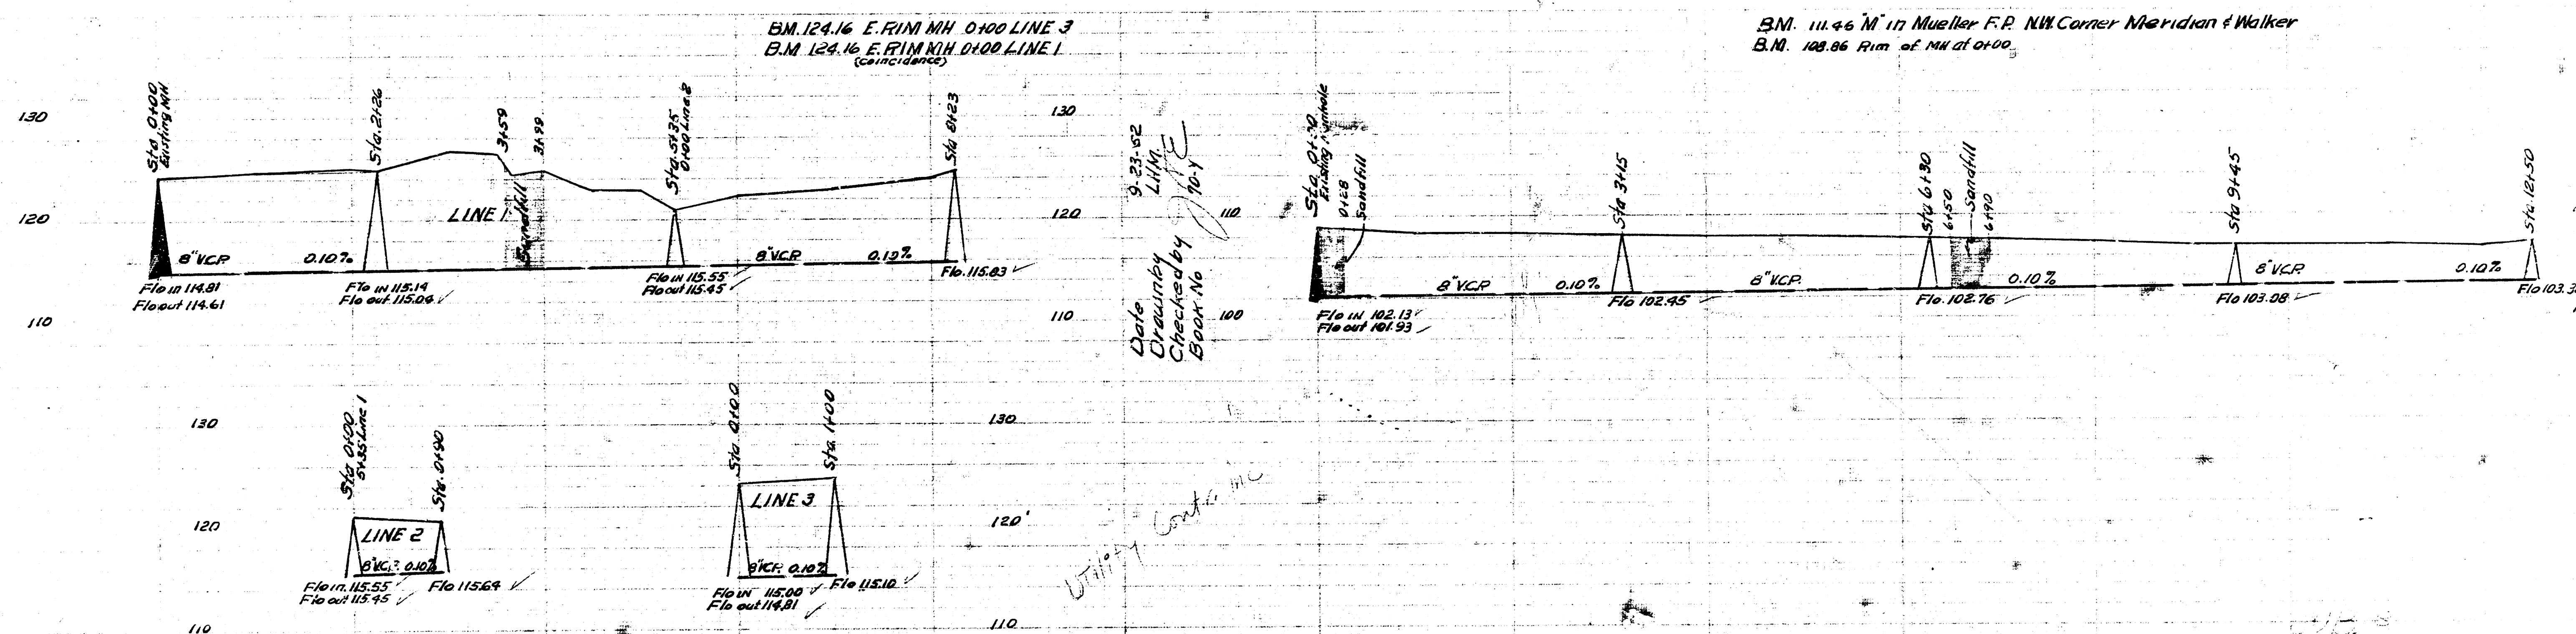

LAT. 3 DIST. R SS. 20
 CITY OF WICHITA KANSAS
 LK. WHITE CITY ENGINEER
 Proj. C. 22-71

LAT. 8 DIST. B SS. 21
 CITY OF WICHITA KANSAS
 LK. WHITE CITY ENGINEER
 Proj. No. C. 22-74