

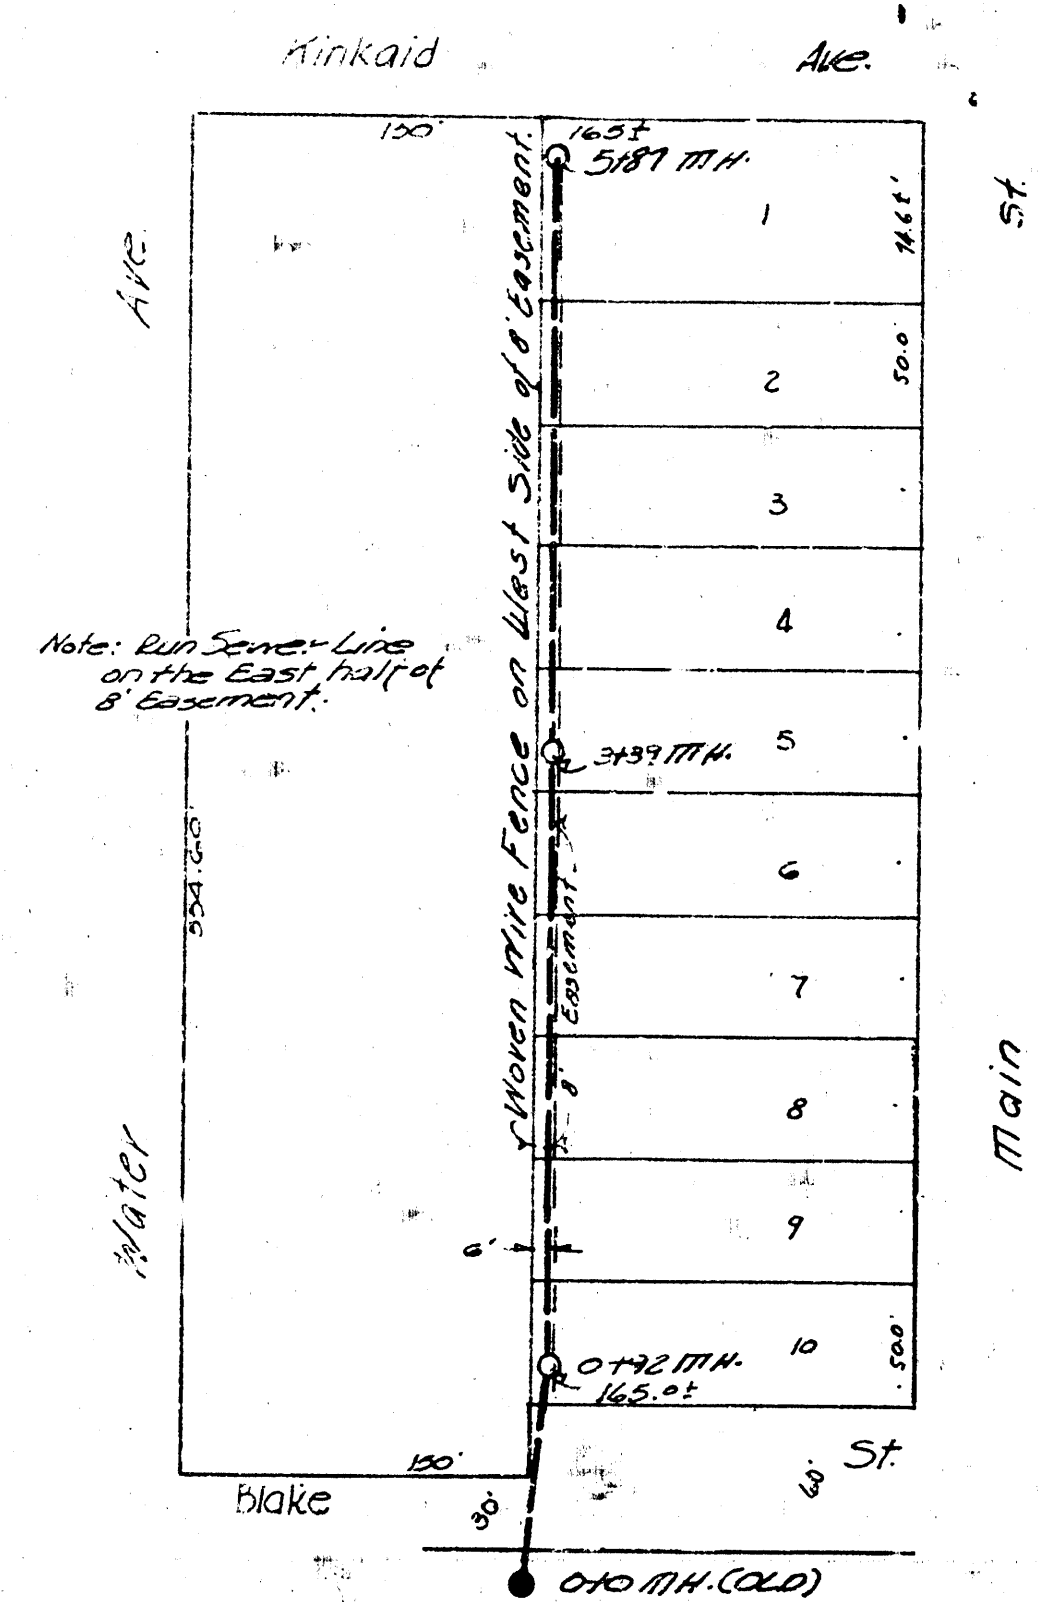


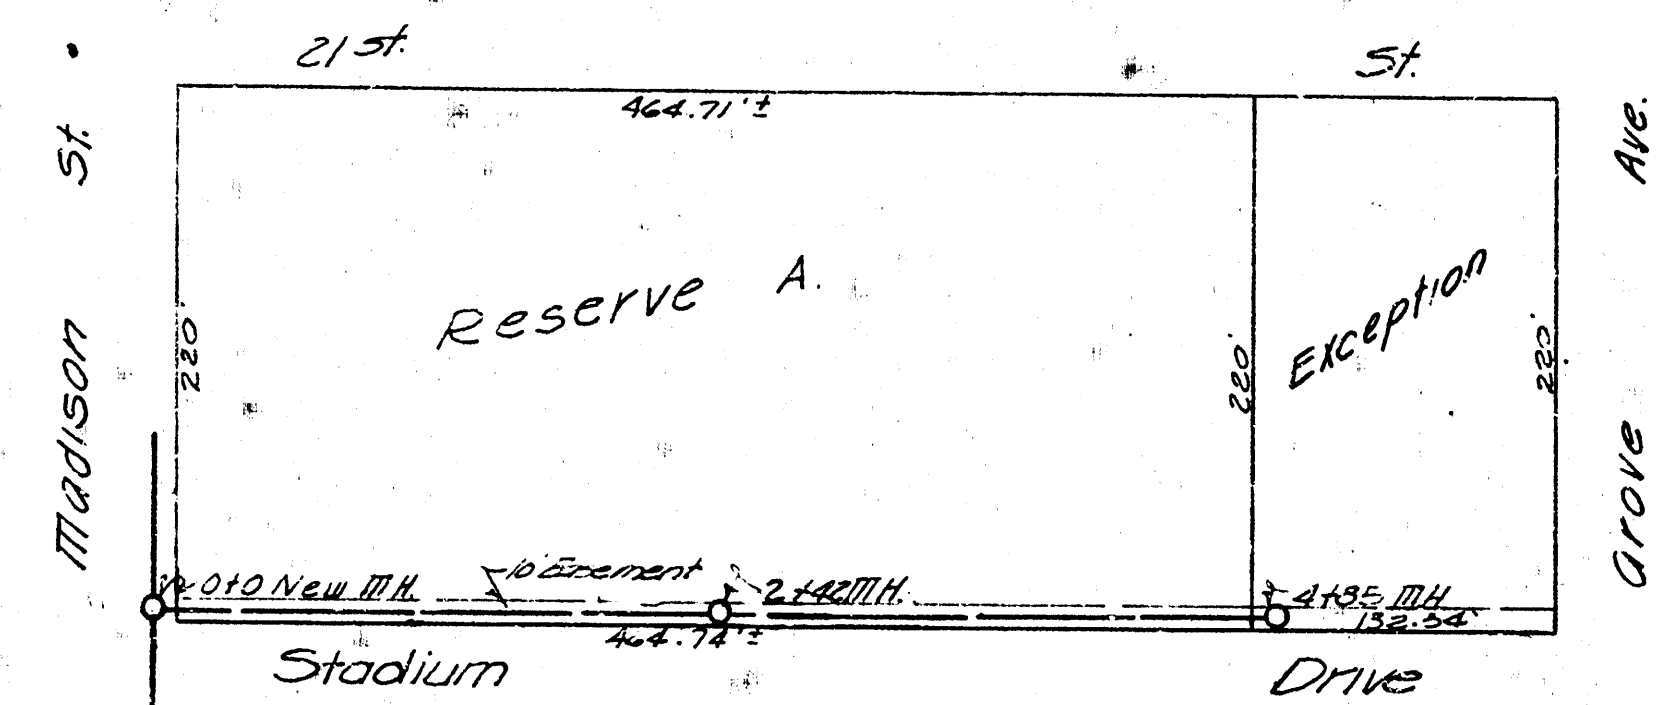




LAT. 12, DIST. A, SS # 20


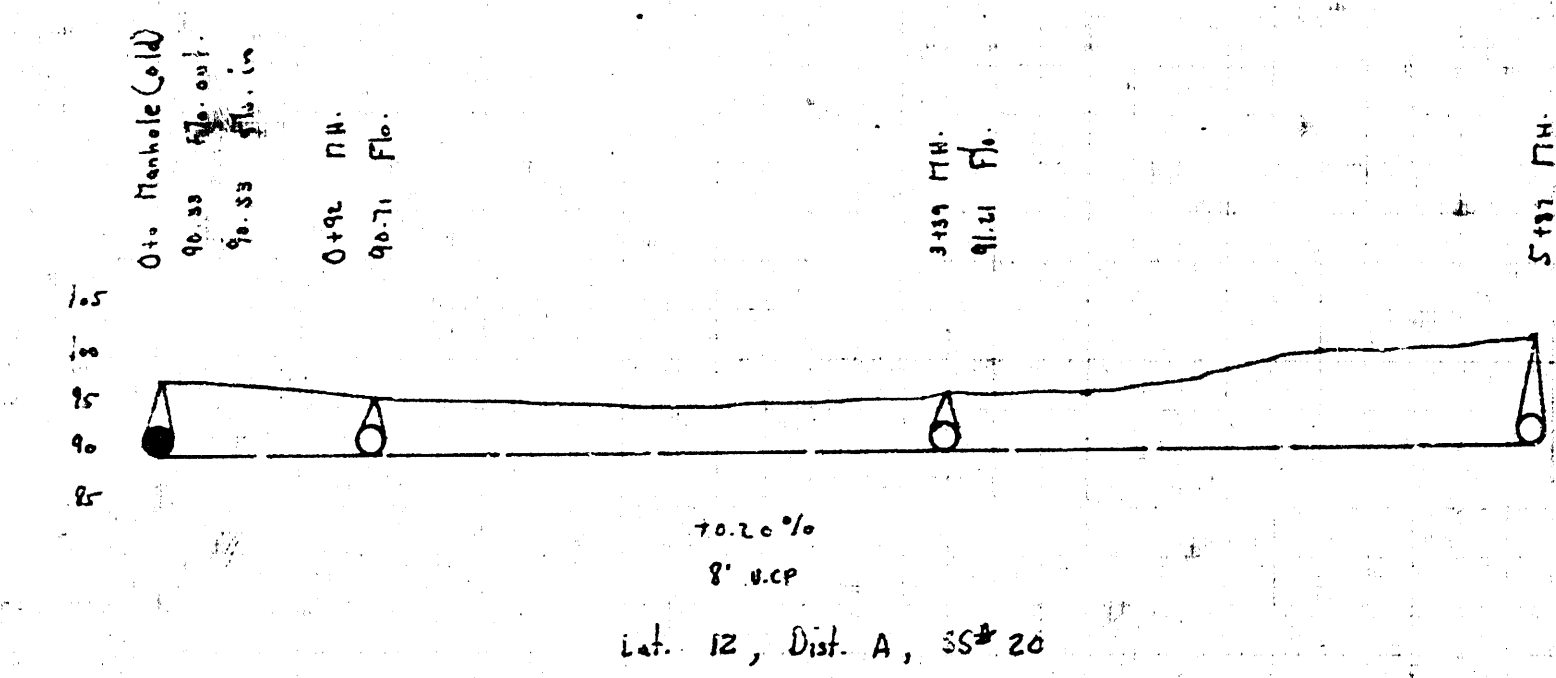

LAT. 9, DIST. E, SS # 12


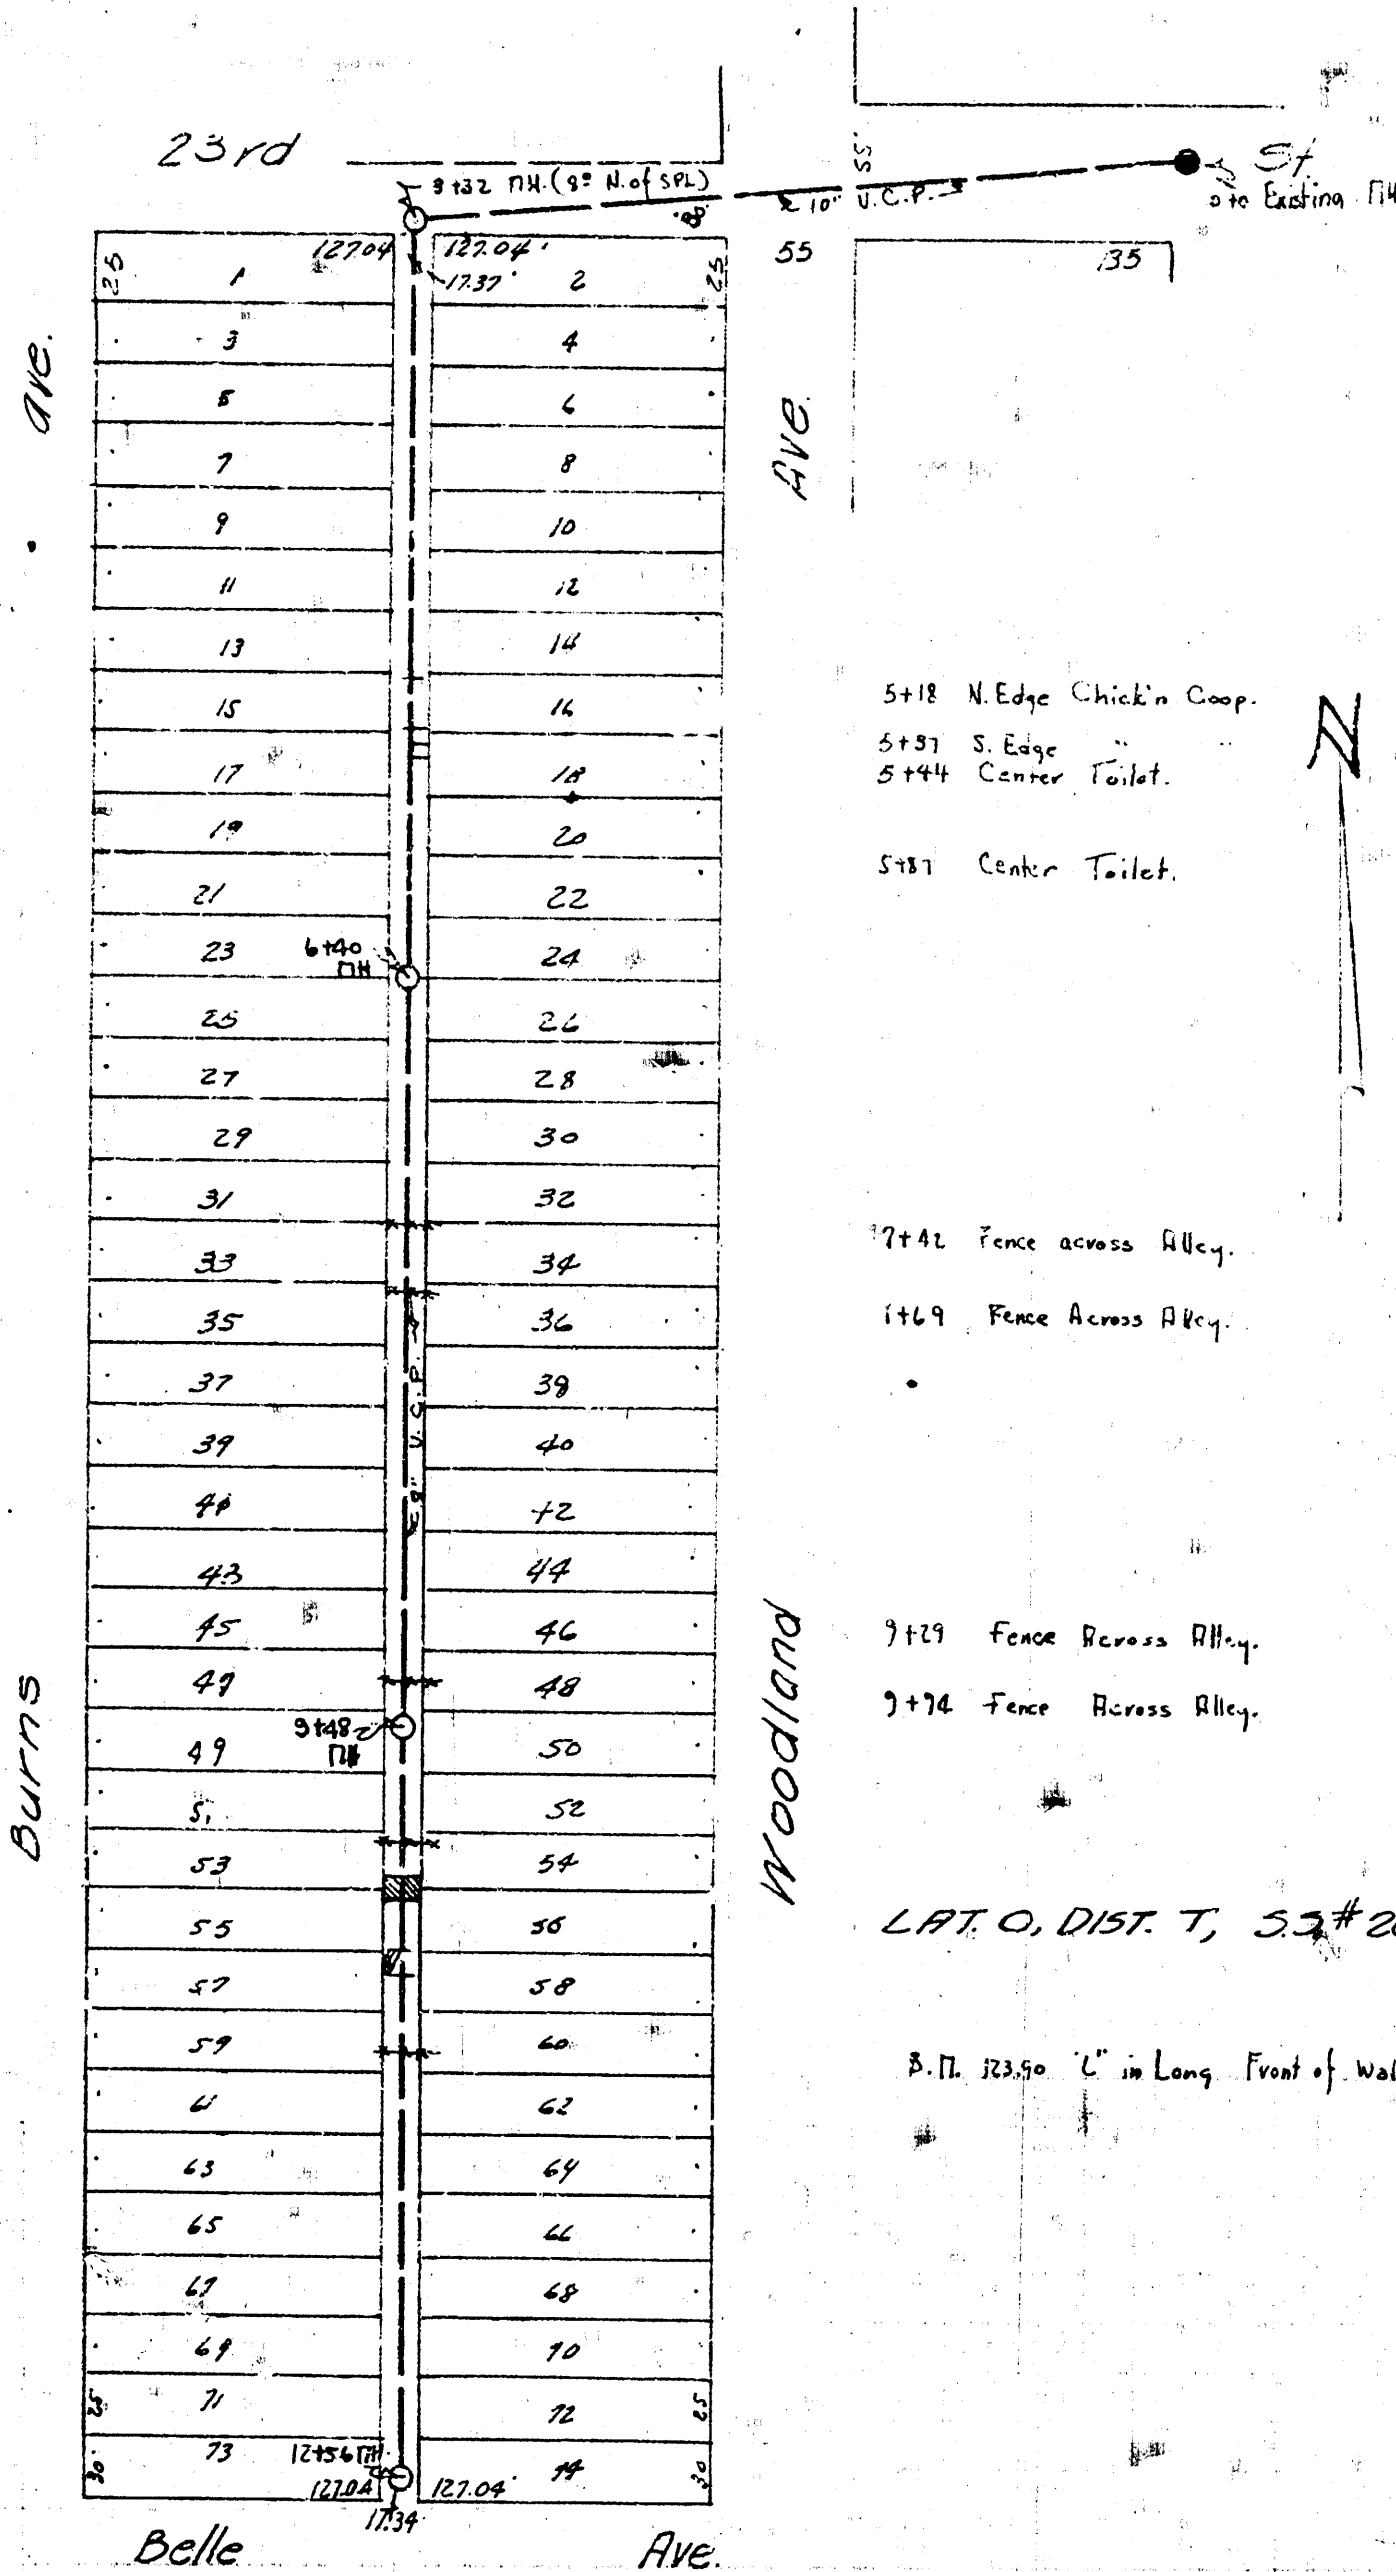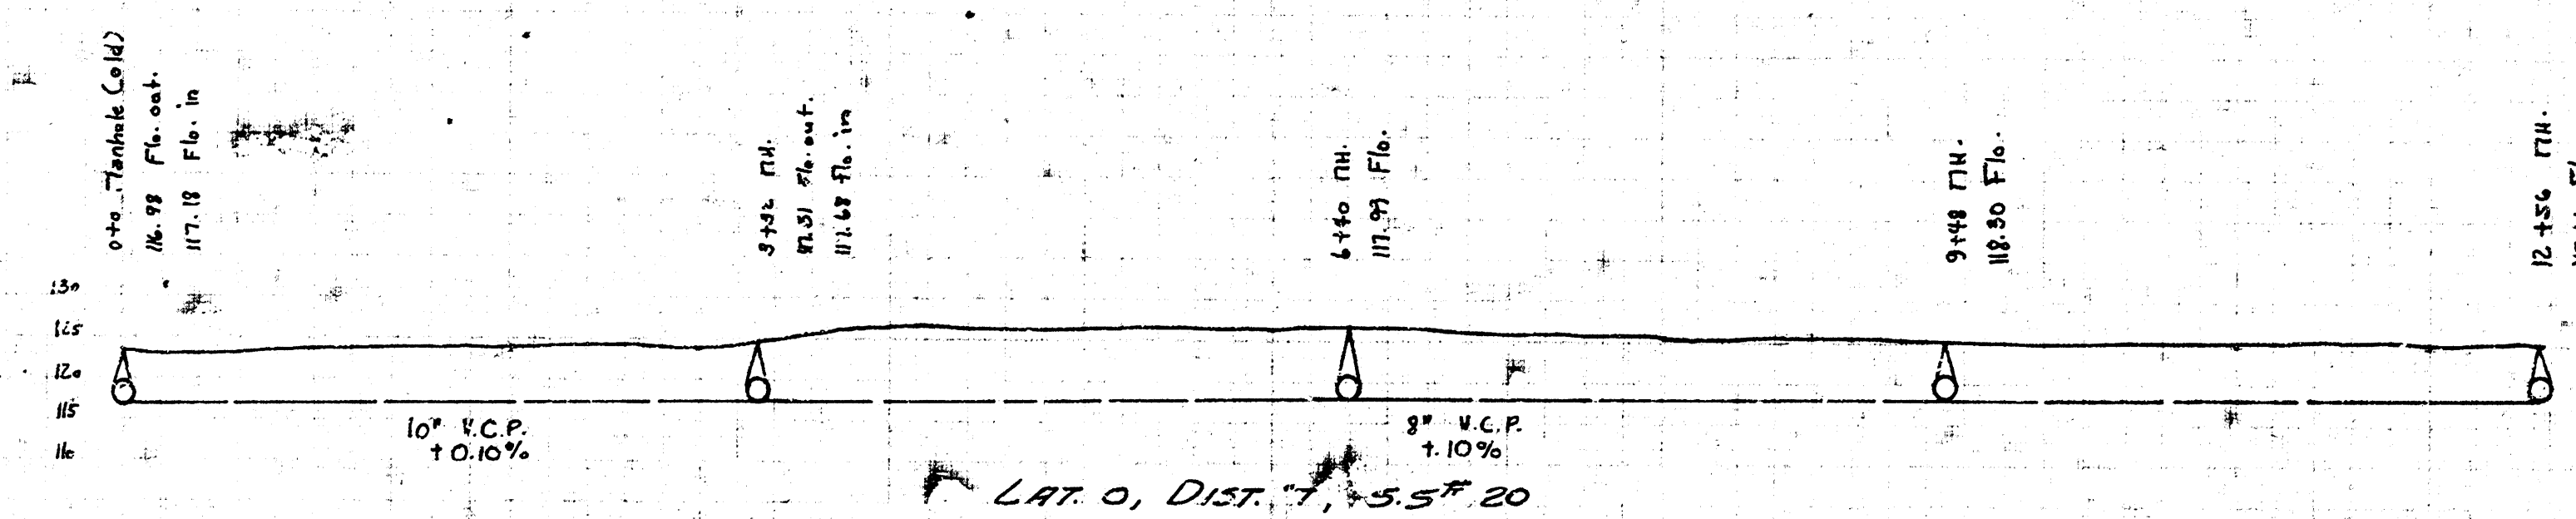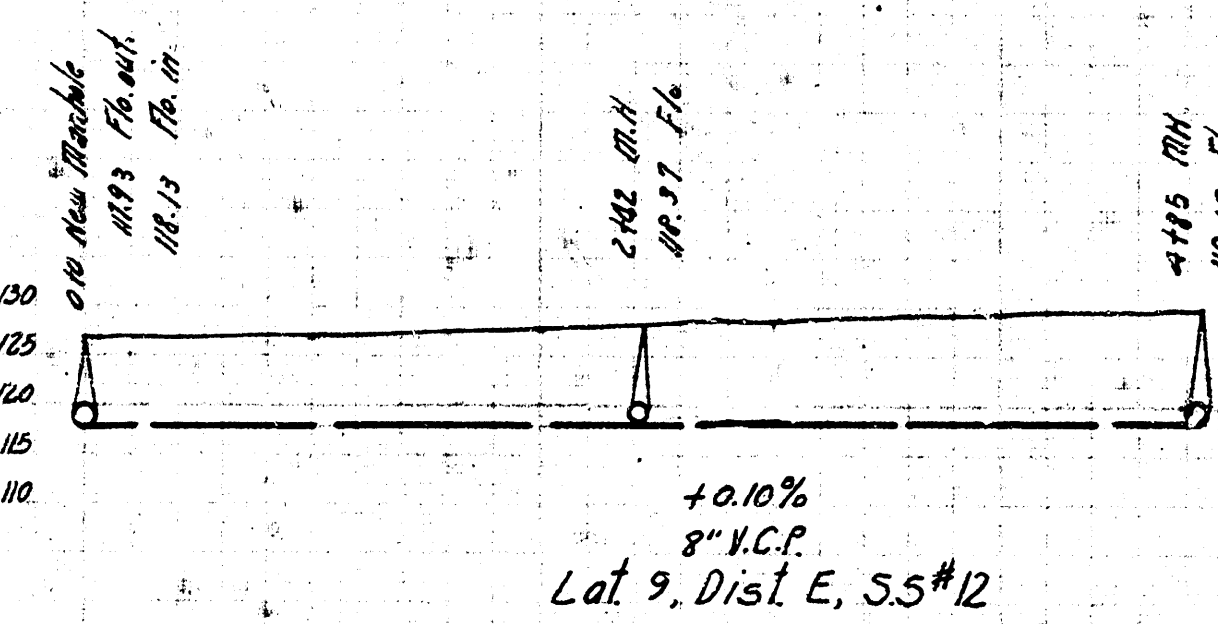




LAT. 0, DIST. T, SS # 20


LAT. 9, DIST. E, SS # 12
LAT. 0, DIST. T, SS # 20

City of Wichita, Kansas.

L.R. White City Engineer

May 1949