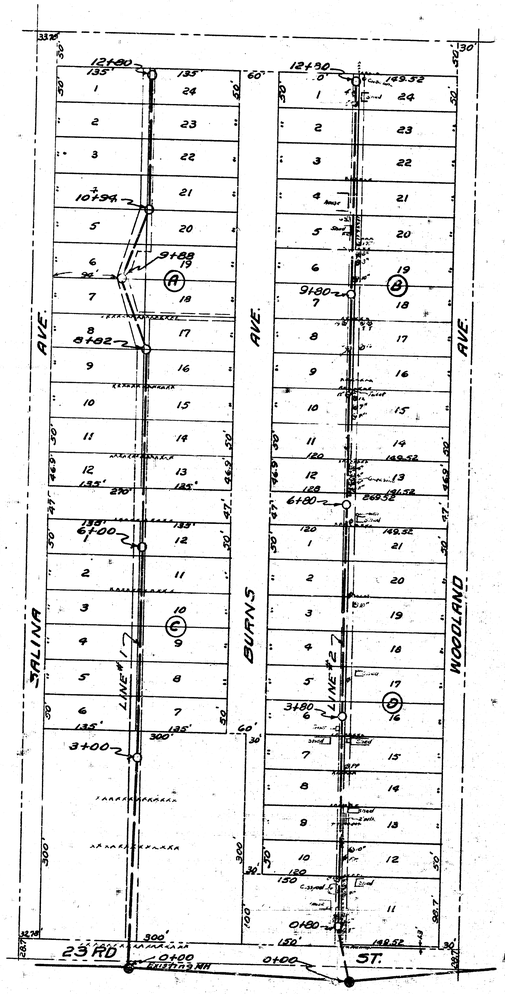

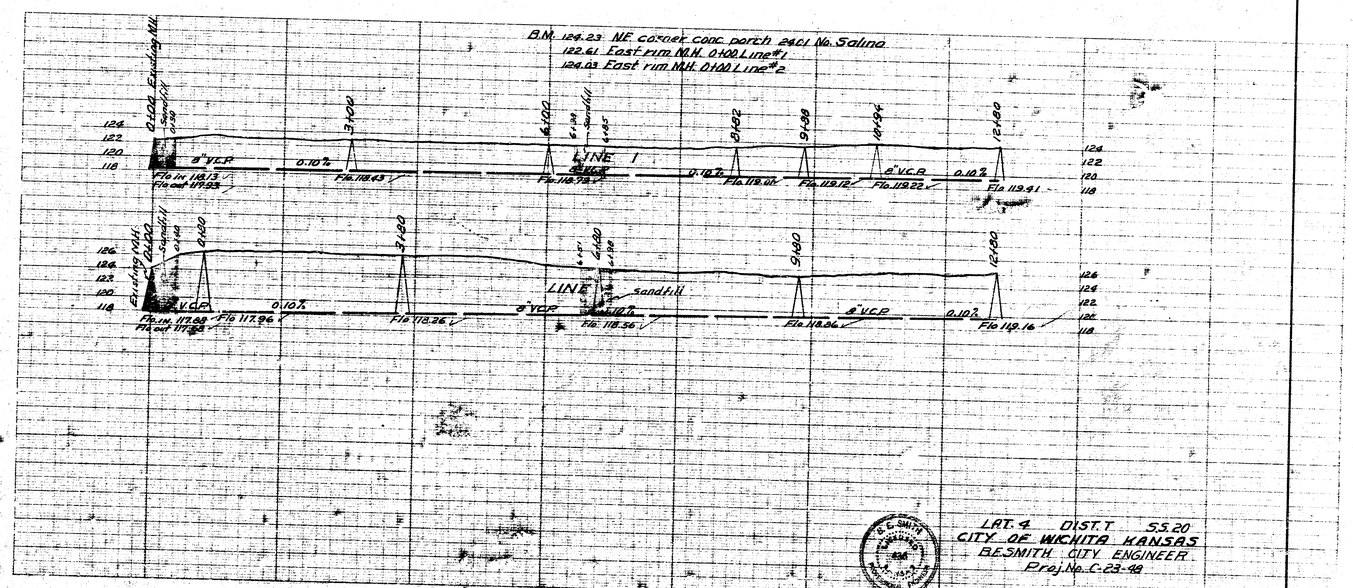

LAT. 4 DIST. T S.S. 20
CITY OF WICHITA KANSAS
B.E. SMITH CITY ENGINEER
Proj. No. C-23-48

Date 1-15-48
Drawn by McCann
Checked by
Book No. 17 42