


Scale: 1"=100'

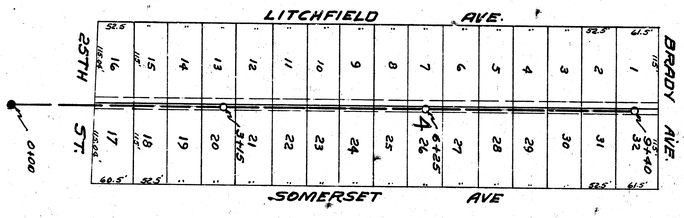


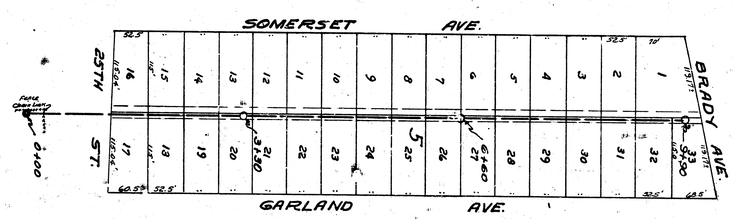

Date 10-15-53
Drawn by MacLain
Checked by GBY
Book N

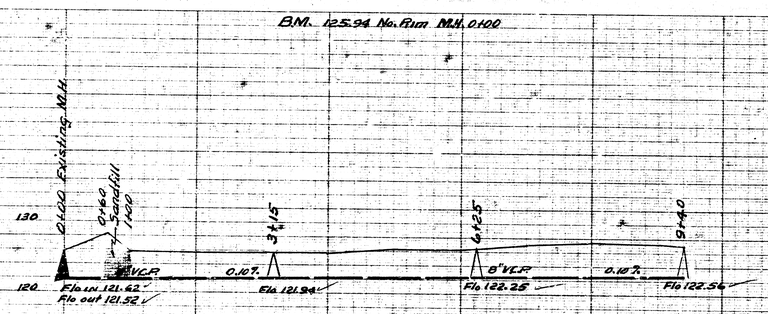

LAT. 8 DIST. T. S.S. 20
CITY OF WICHITA KANSAS
B.E. SMITH CITY ENGINEER
Proj. NO C-23-54

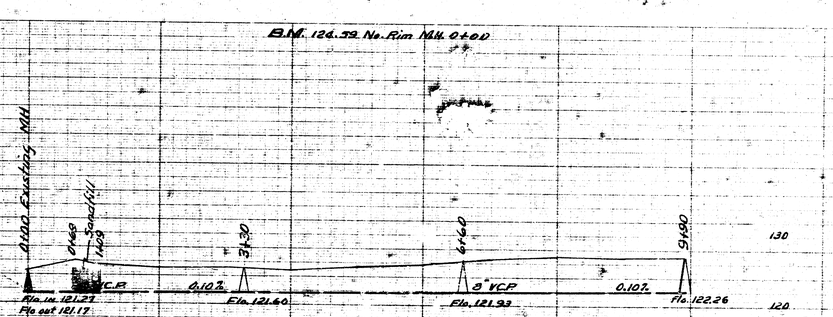

LAT. 9 DIST. T. S.S. 20
CITY OF WICHITA KANSAS
B.E. SMITH CITY ENGINEER
Proj. No. C-23-55