


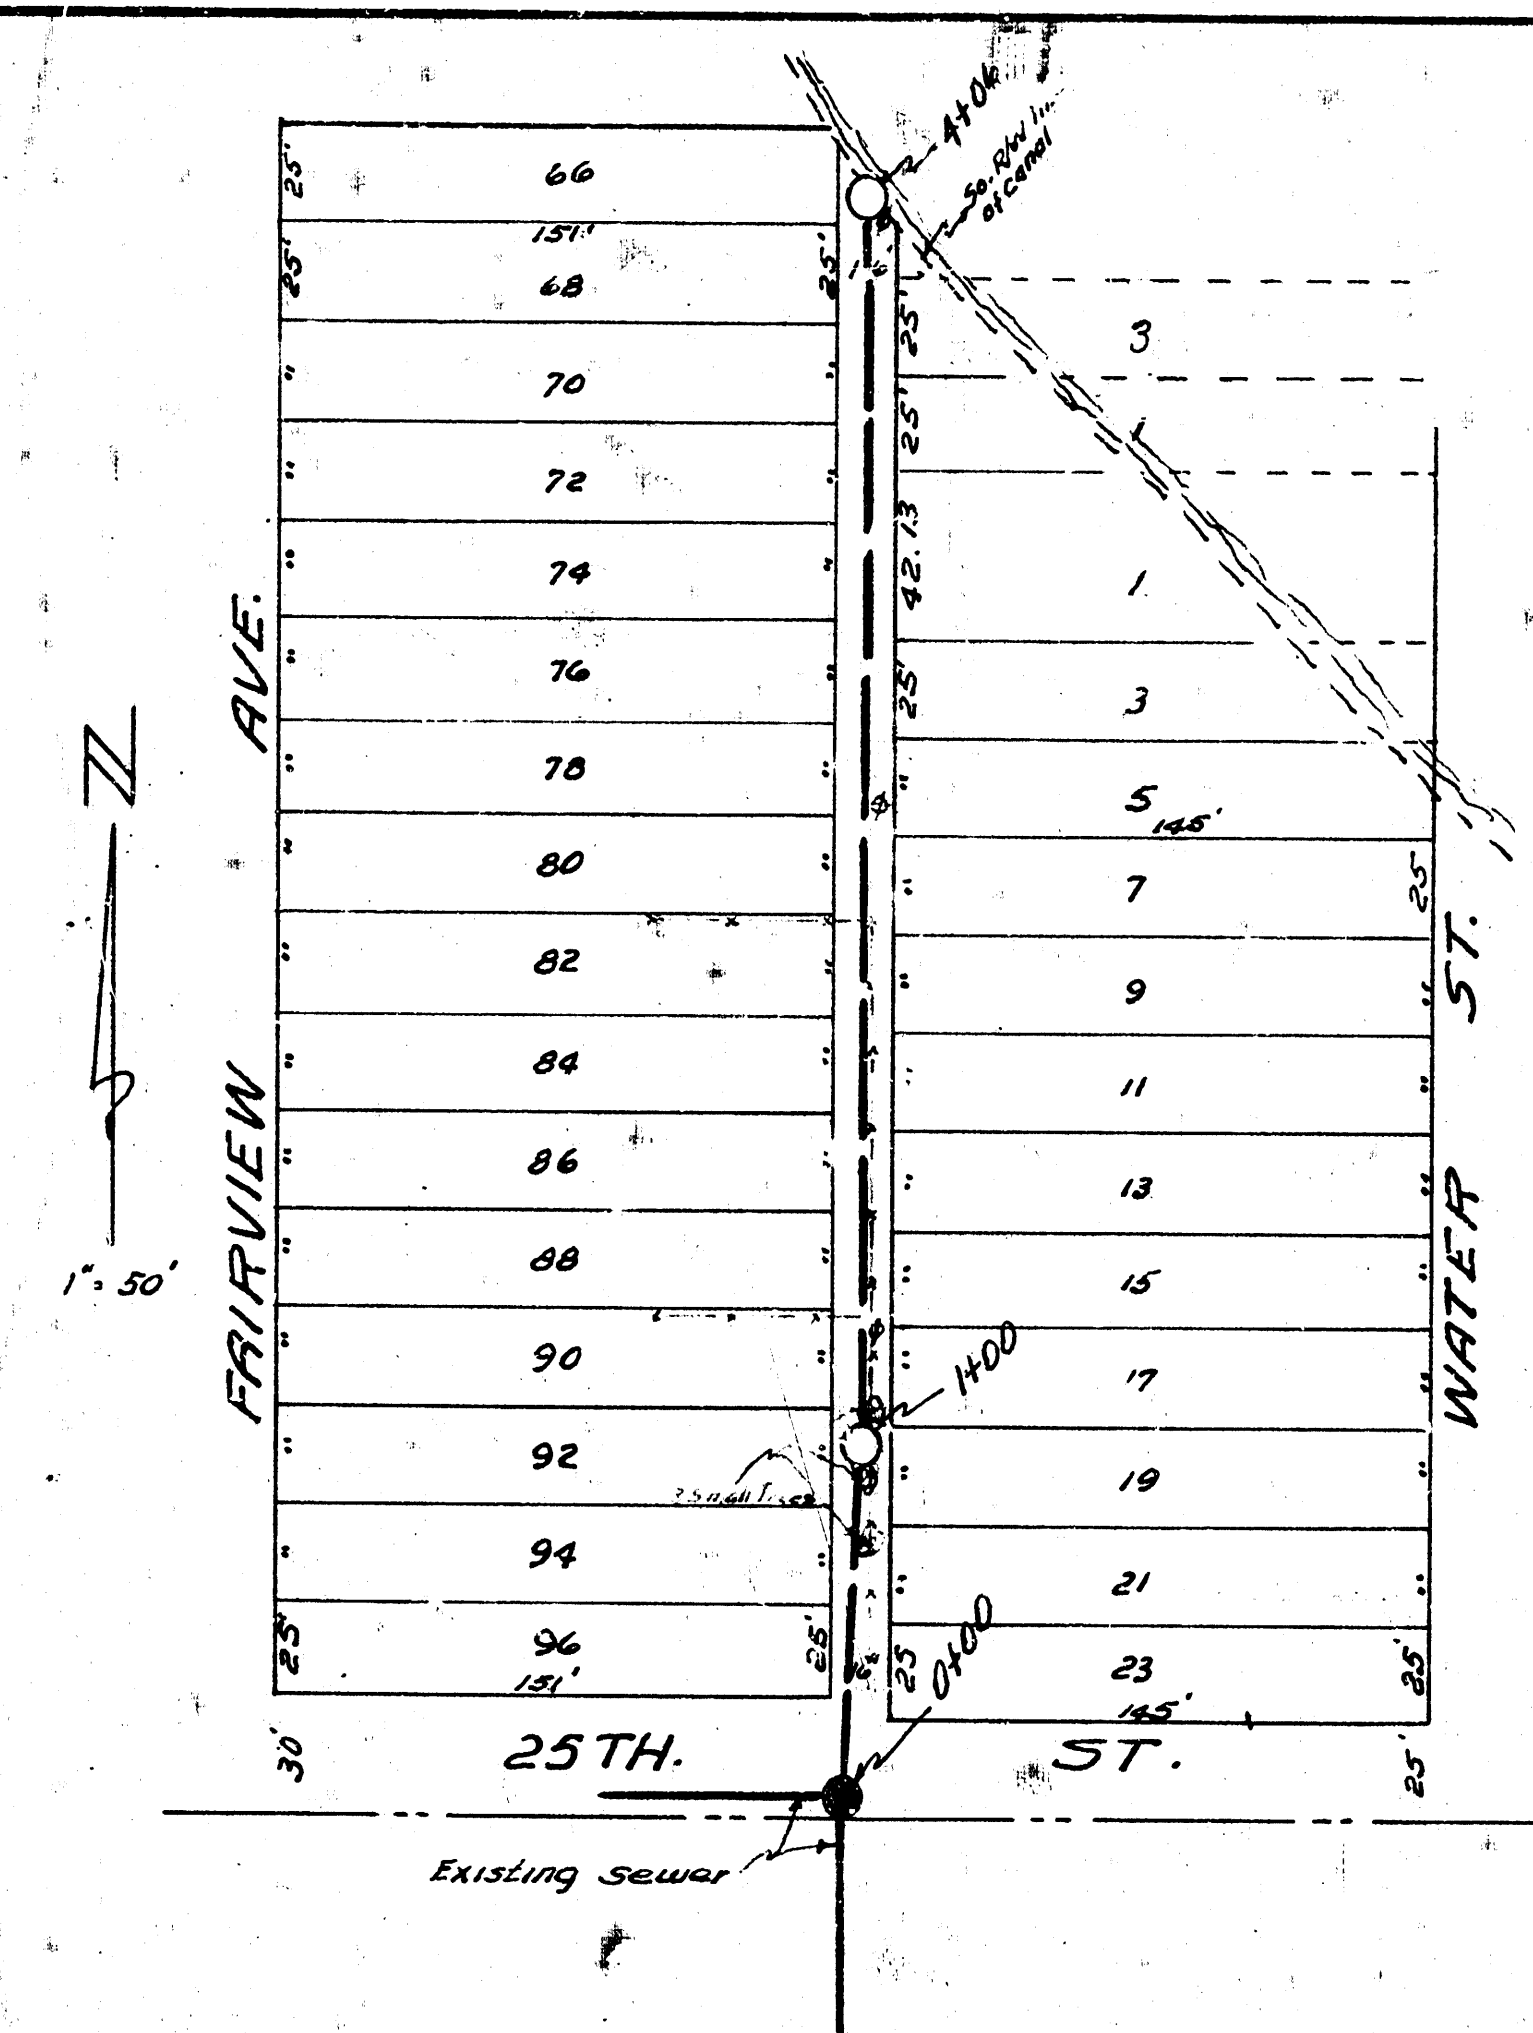
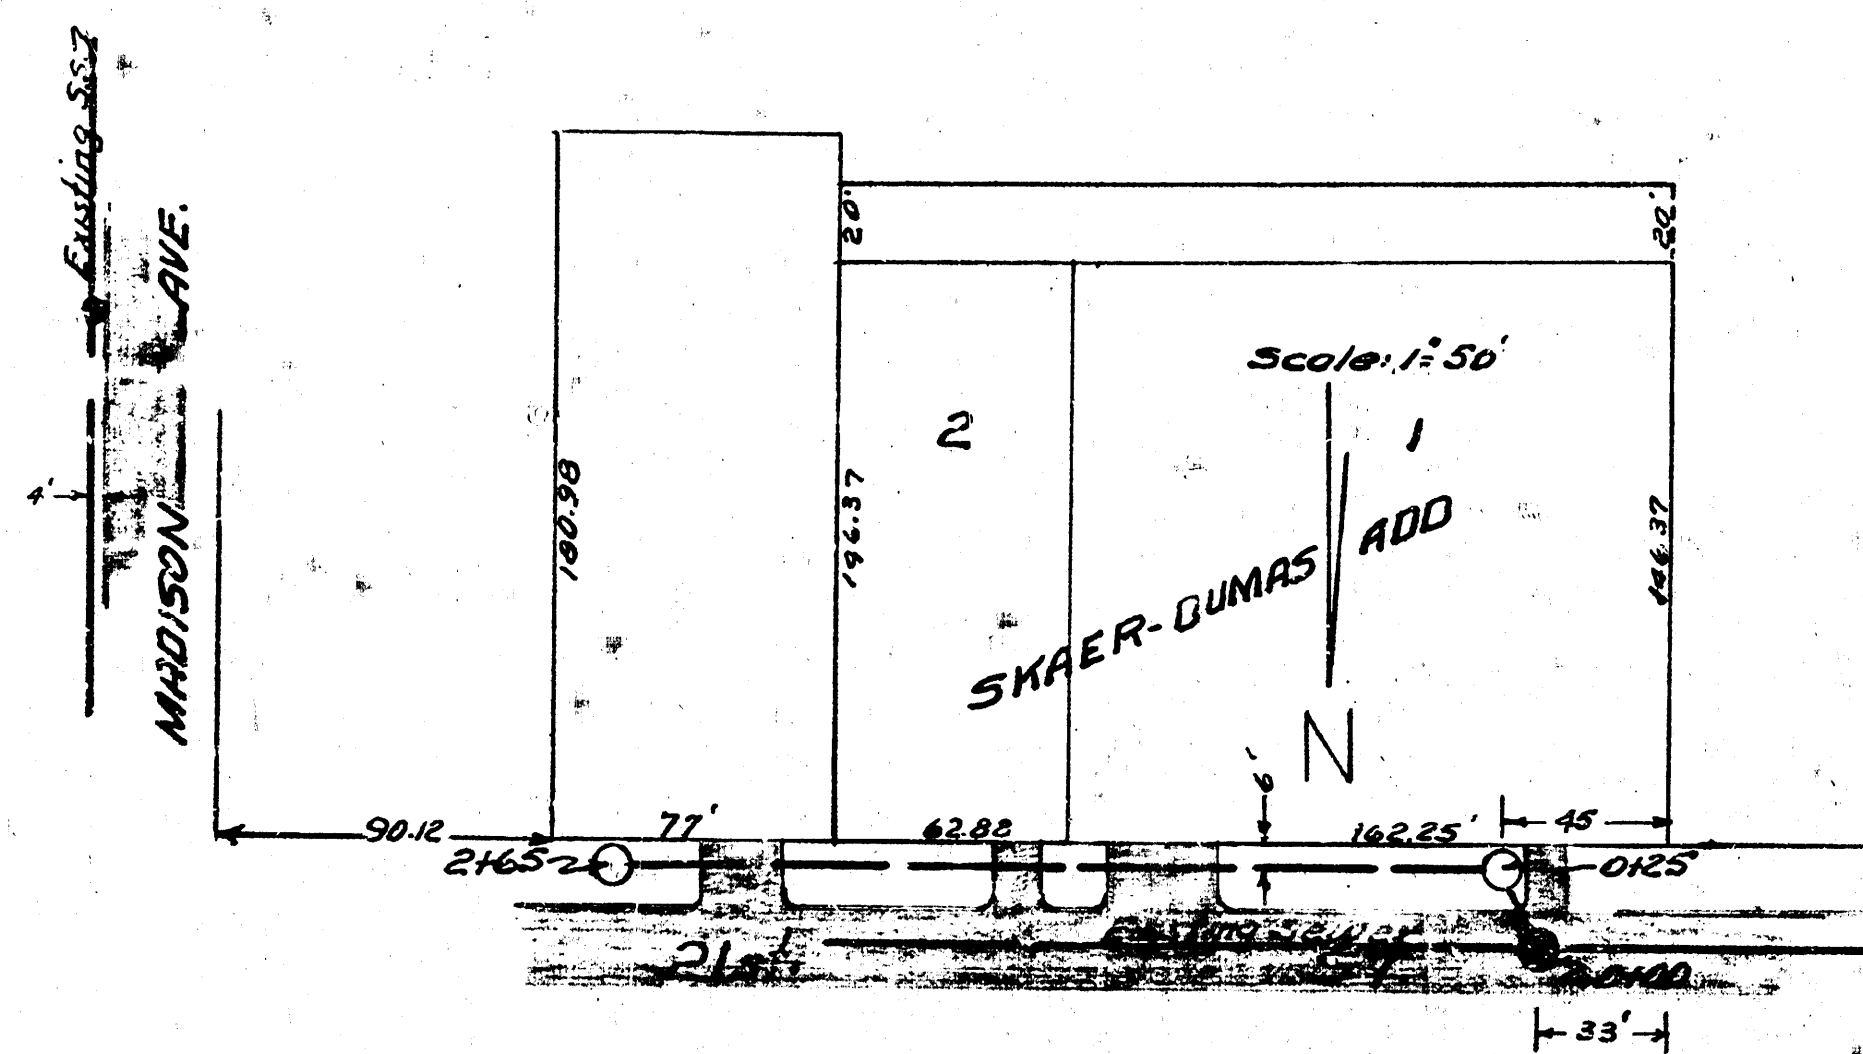
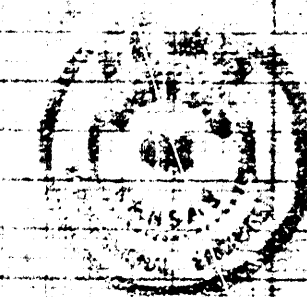


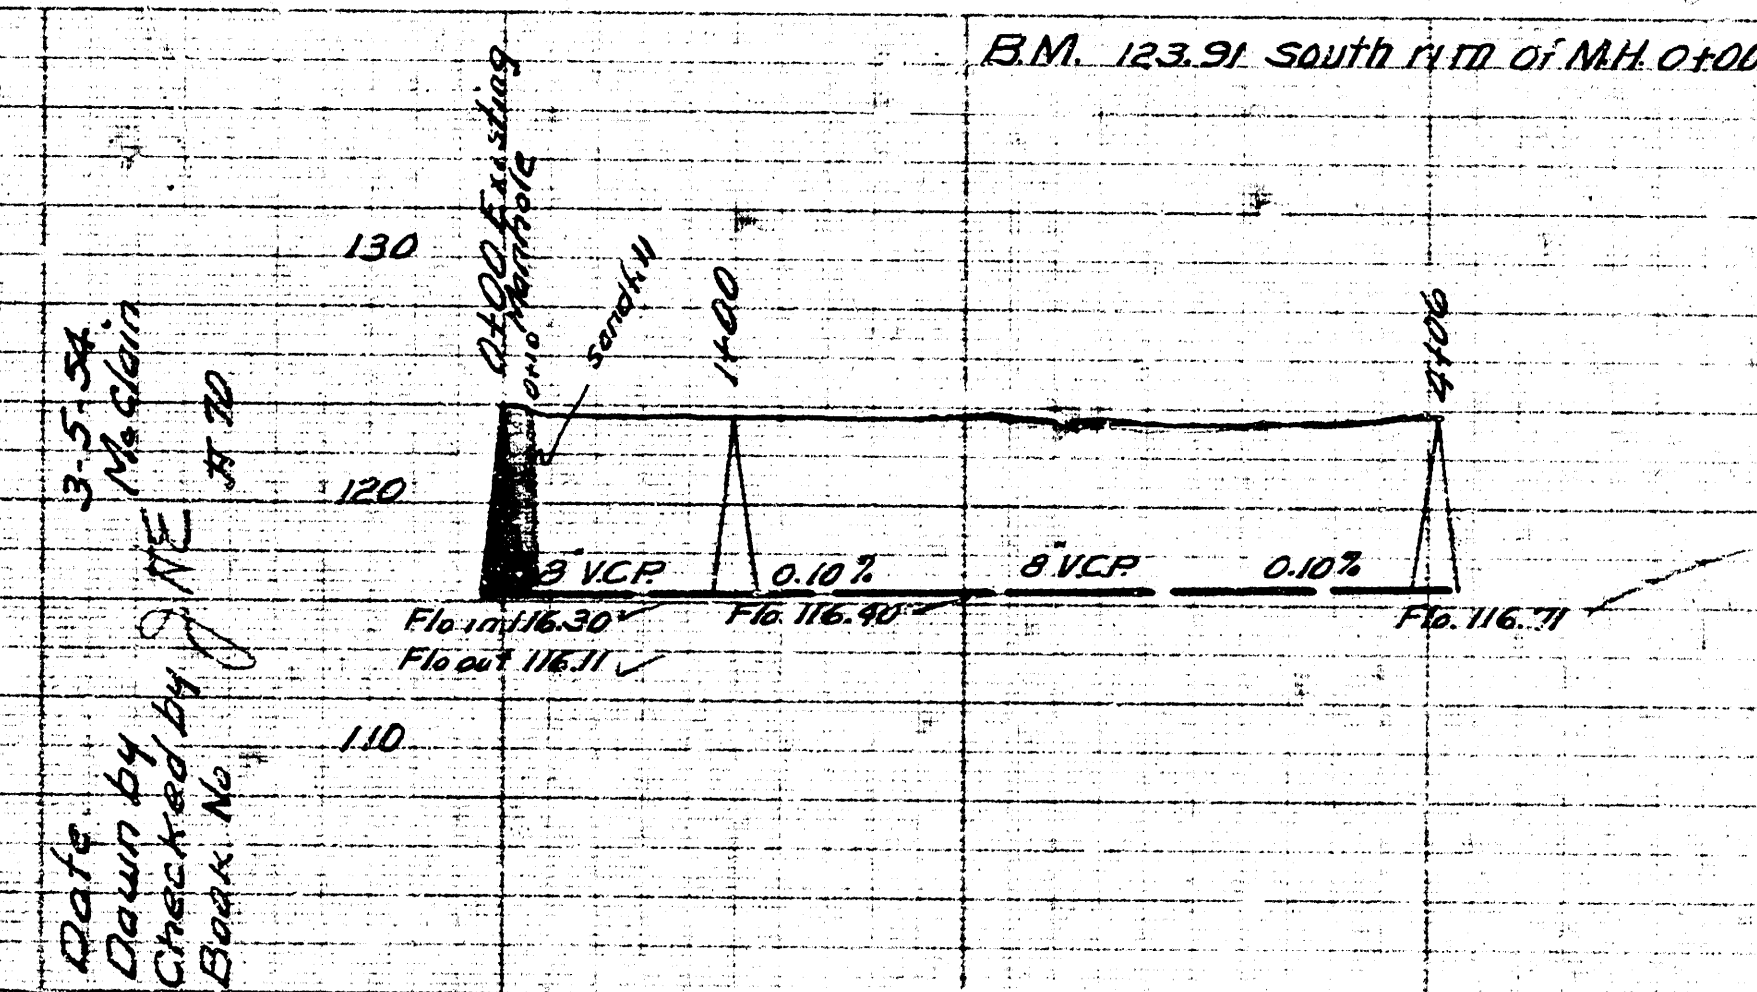

Date
Drawn by
Checked by
Book No.

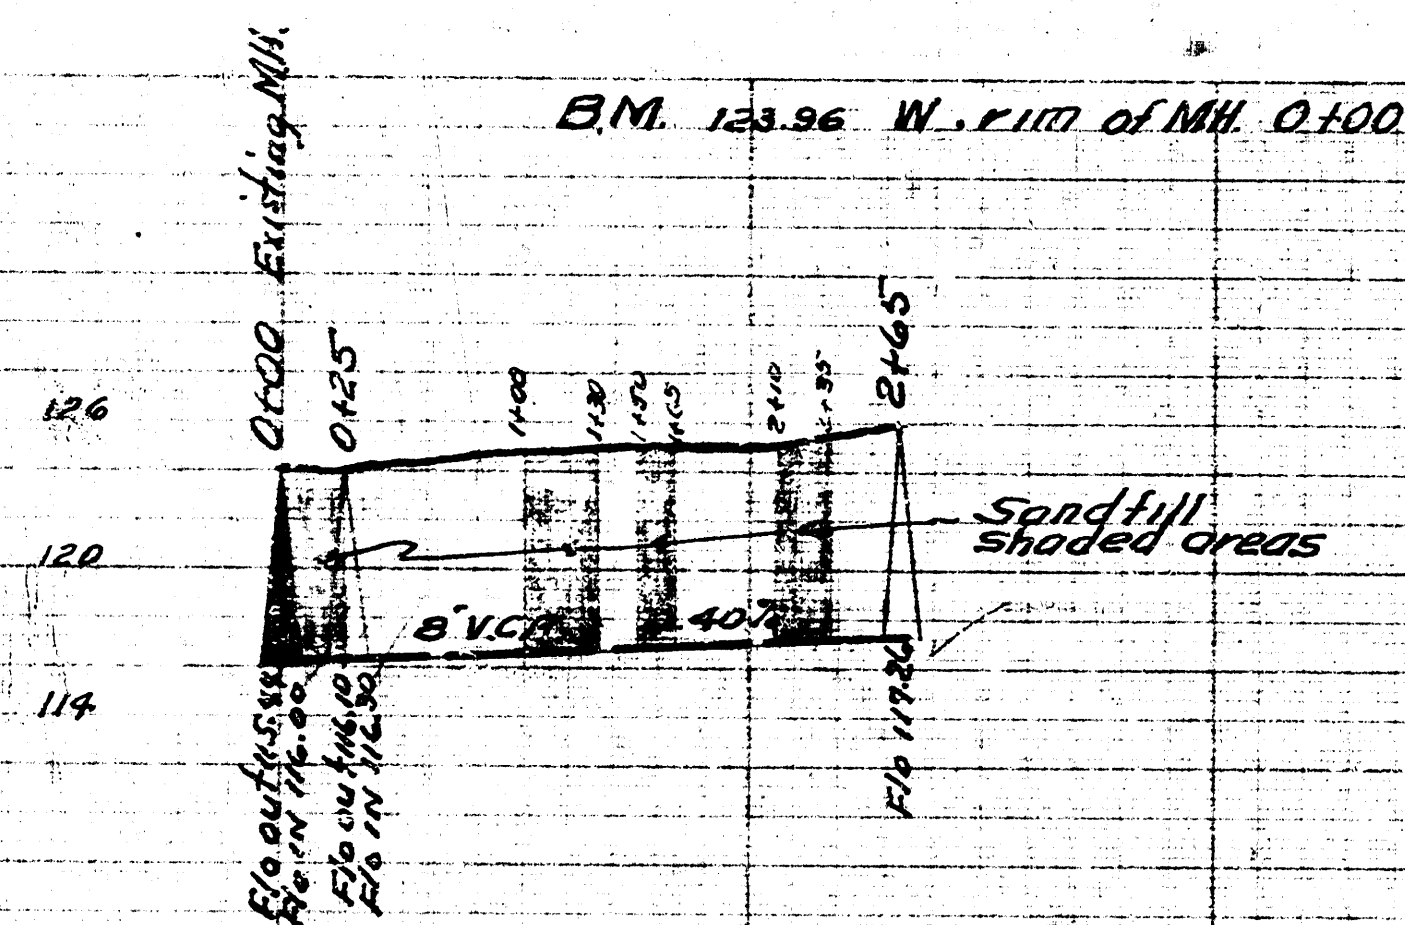

LAT. 24 DIST. E. SS. 12
CITY OF WICHITA KANSAS
B.E. SMITH CITY ENGINEER
Proj. No. C-23-20

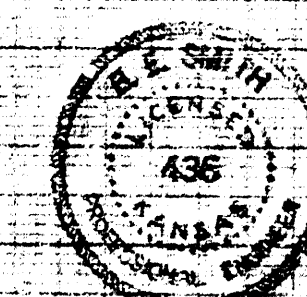

LAT. 14 DIST. T. SS. 20
CITY OF WICHITA KANSAS
B.E. SMITH CITY ENGINEER
Proj. No. C-24-7