

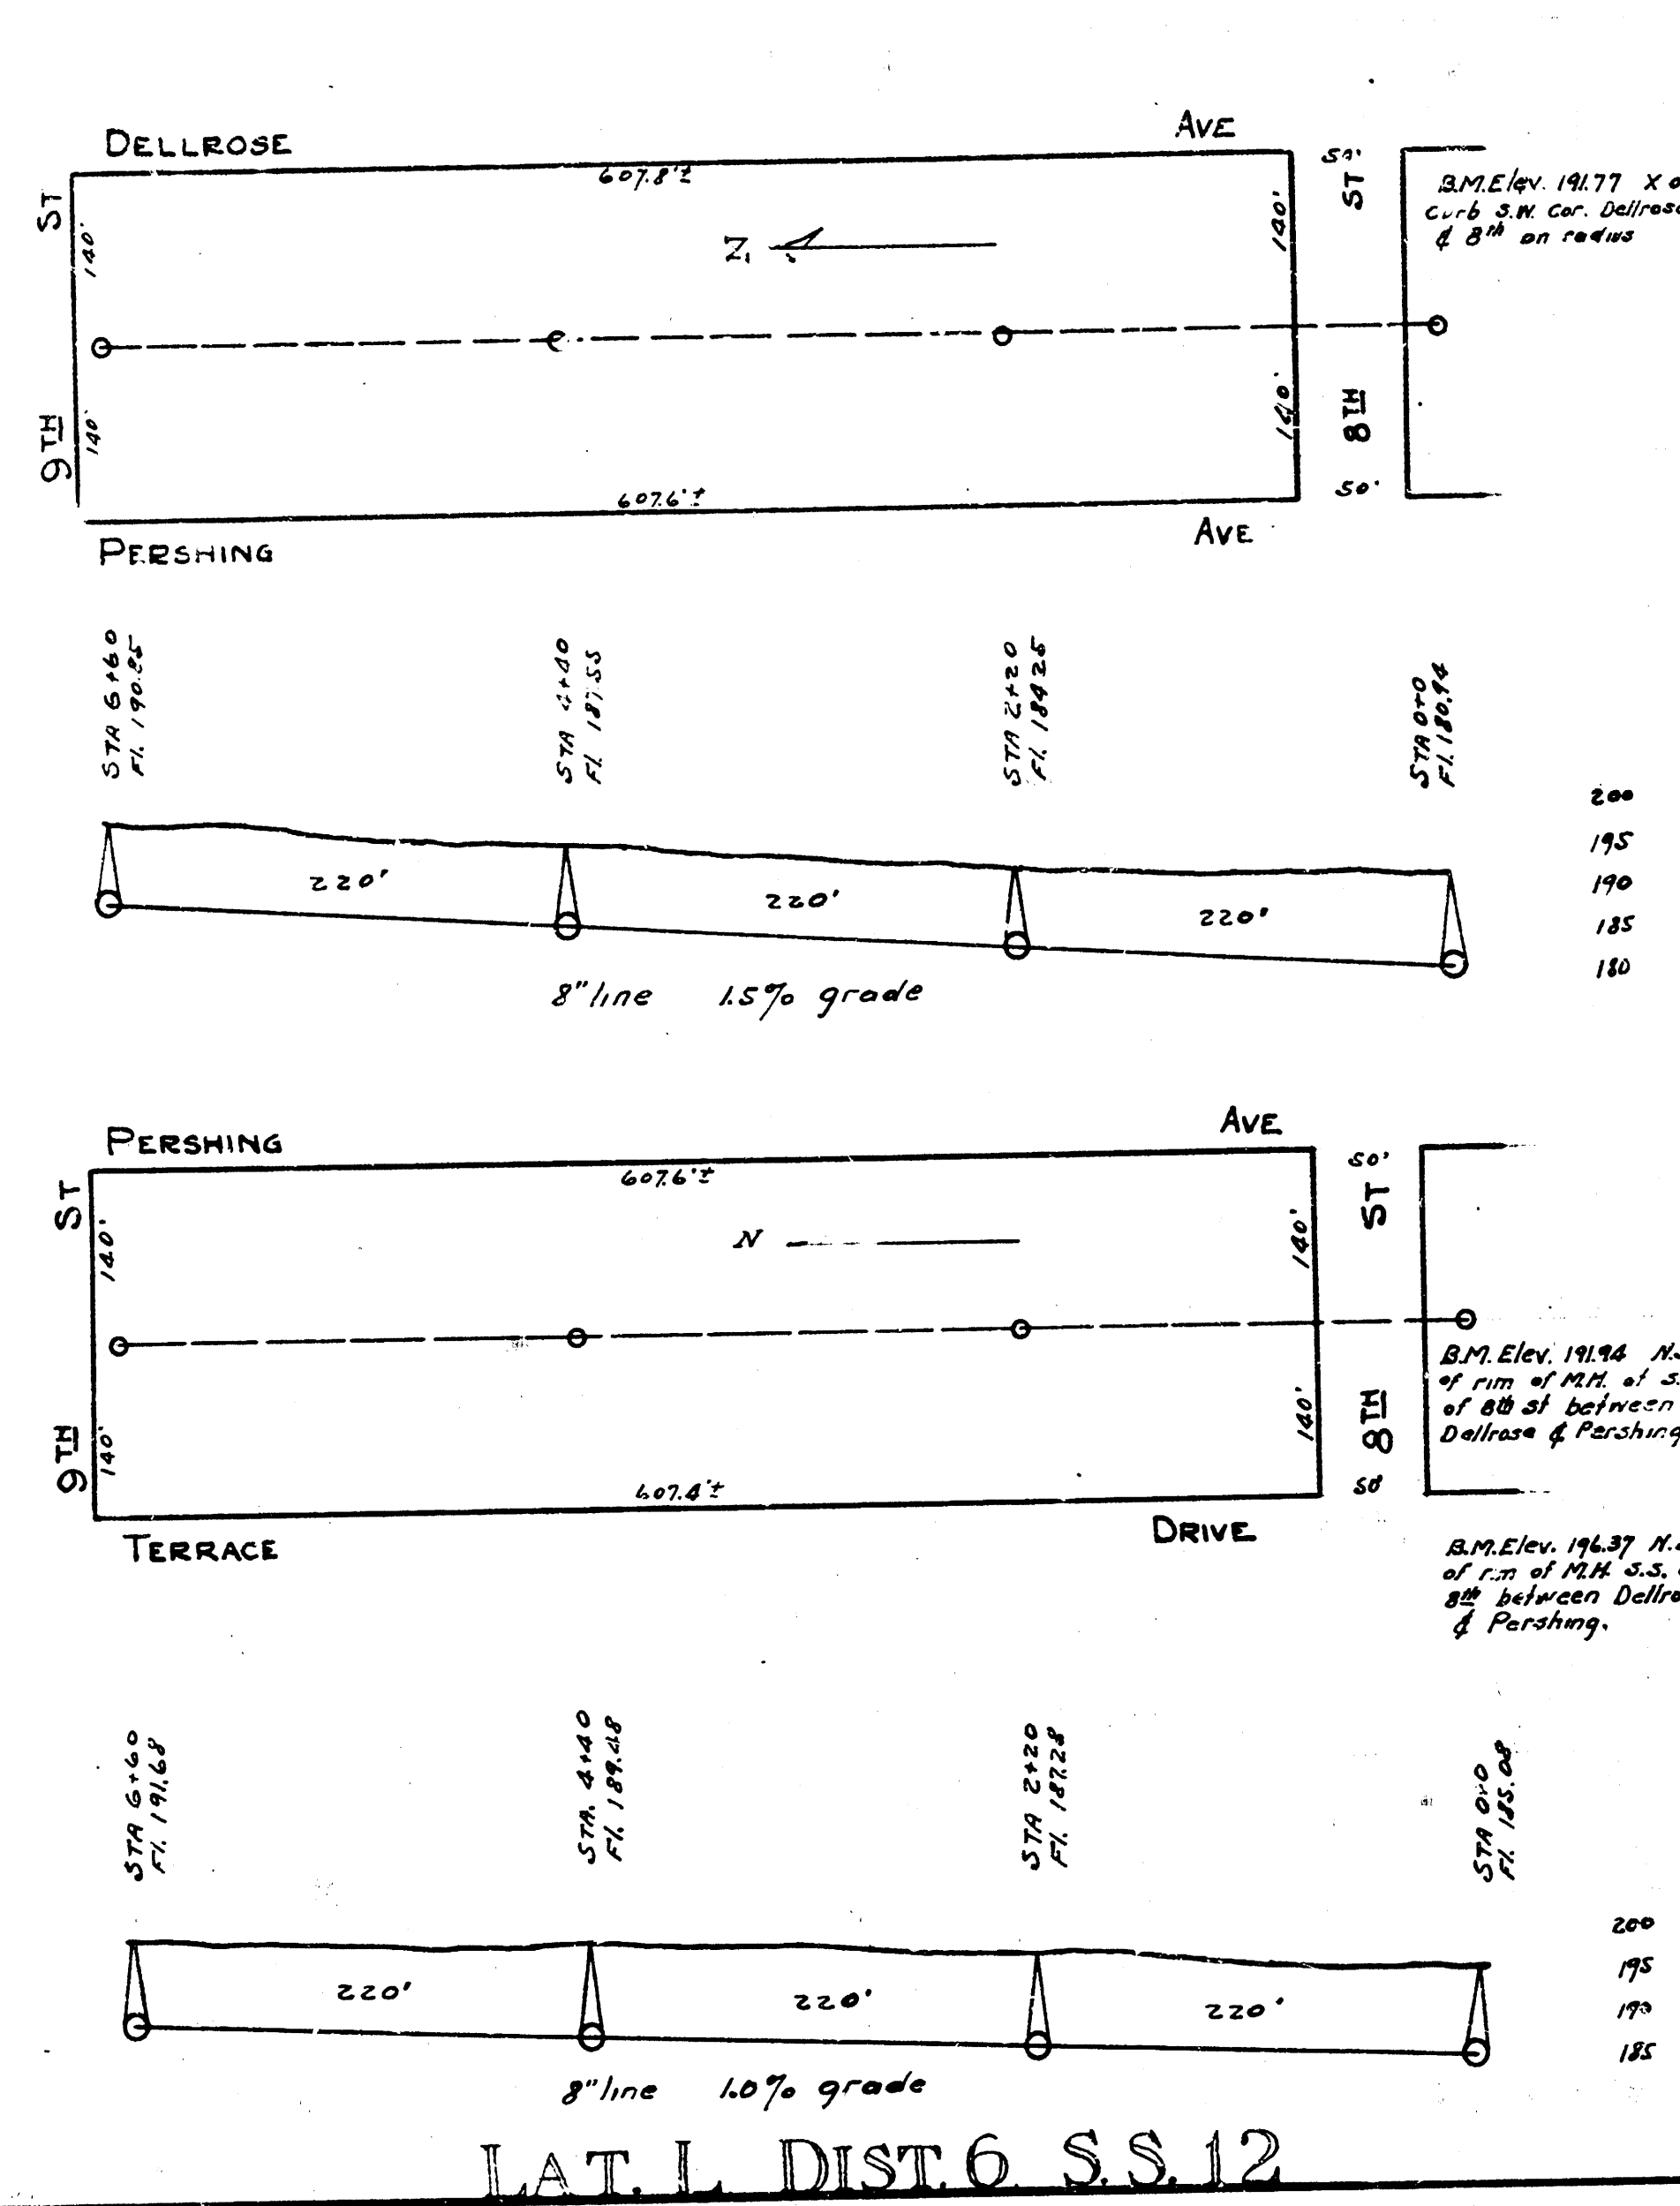


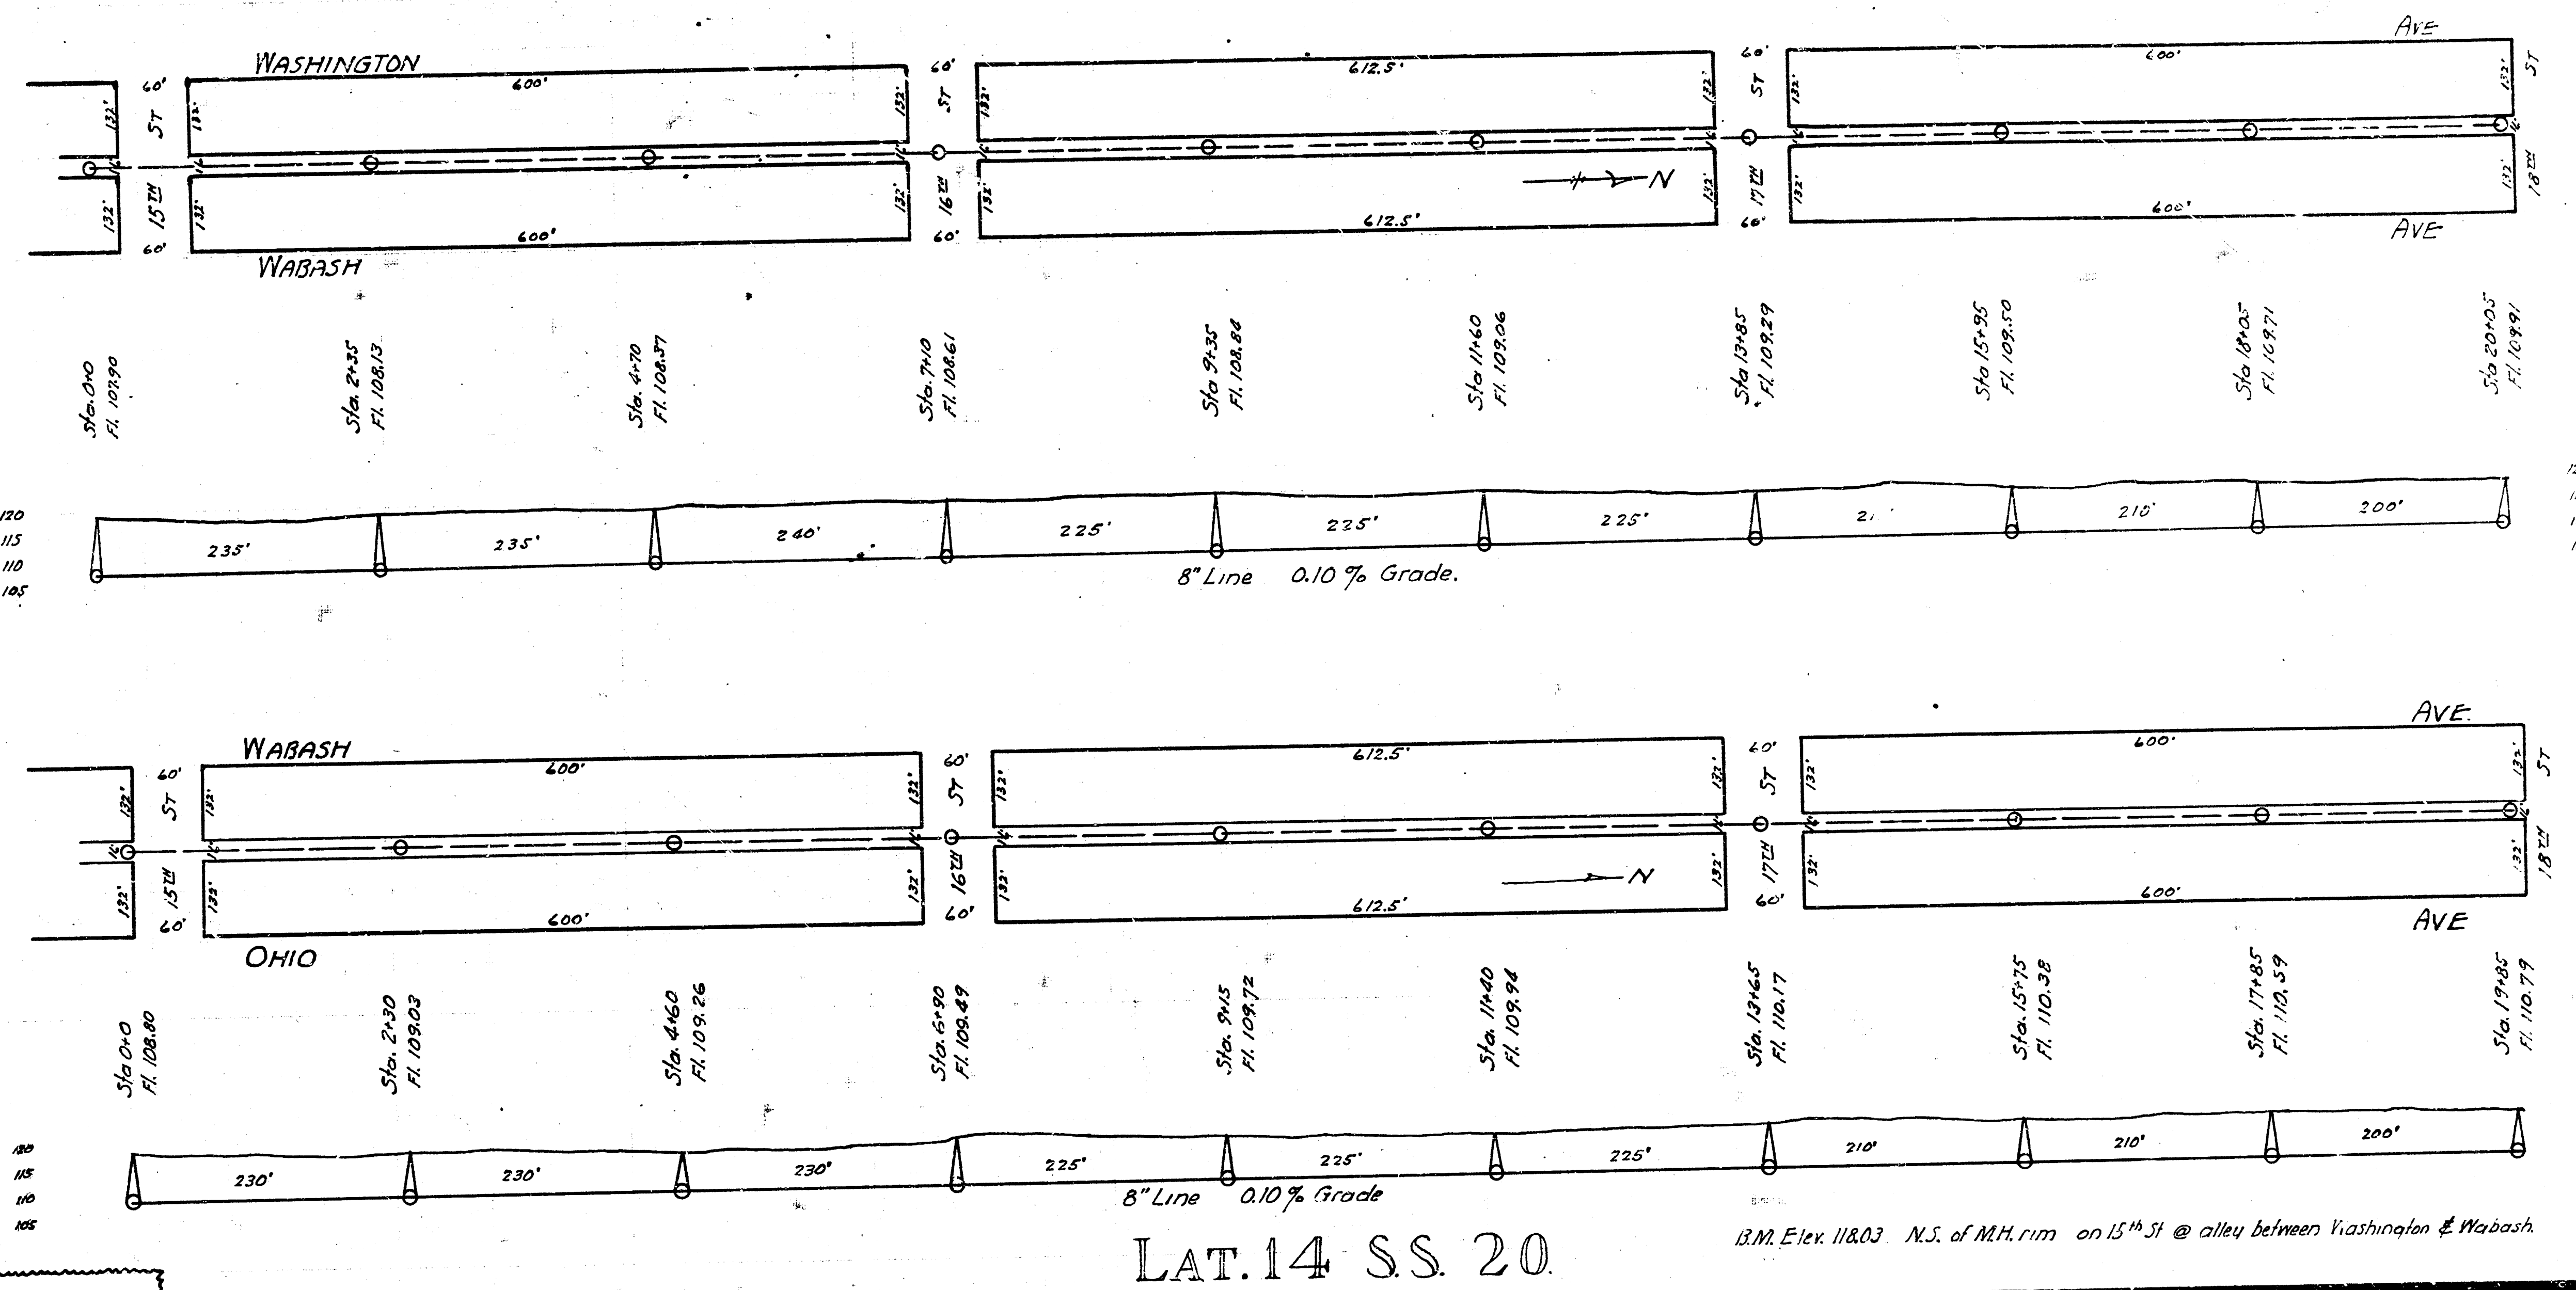



B.M. Elev. 109.26 Iron in
thimble c/c Smythe Ave
& S.S. of Maple St.

LAT G
S.S. 21

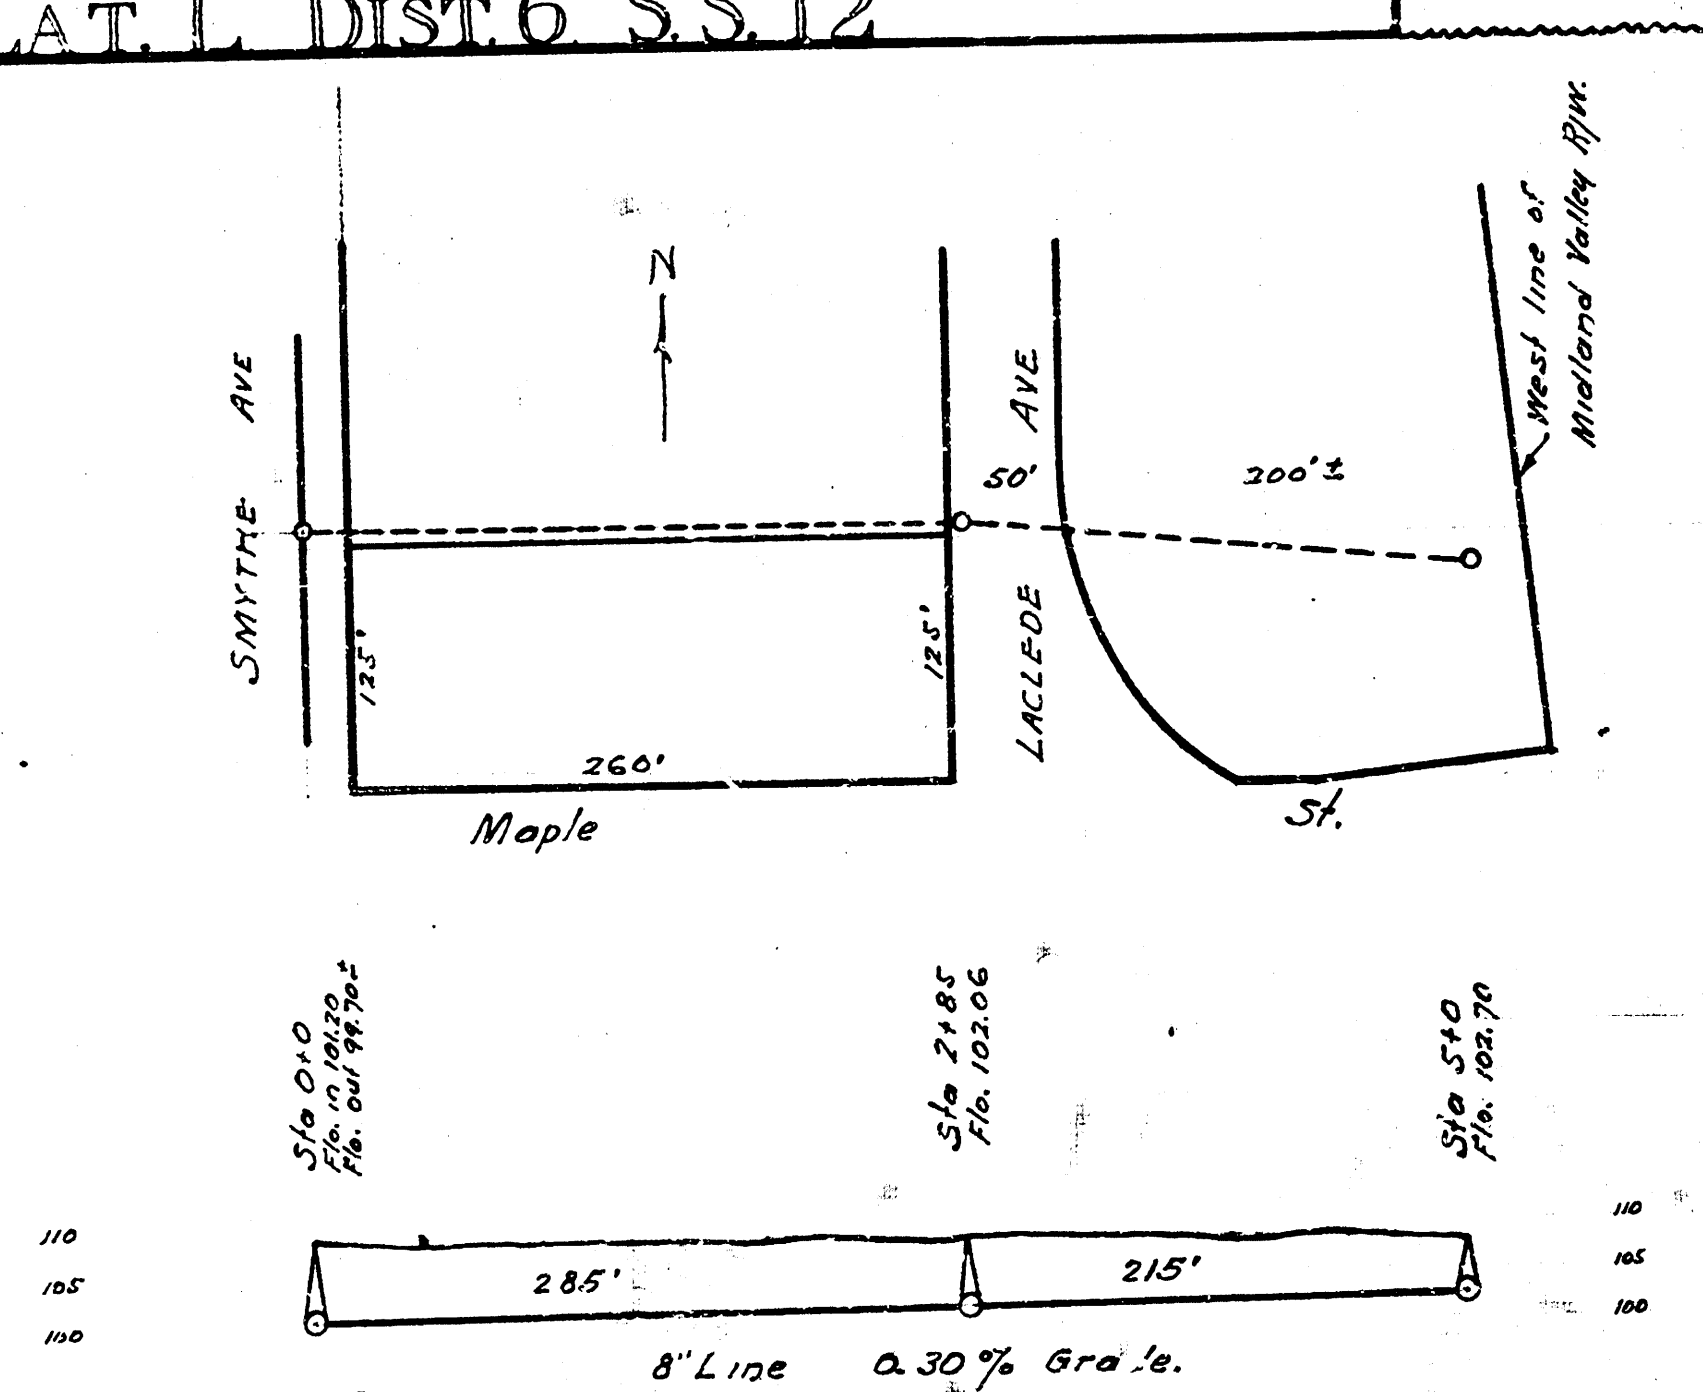

B.M. Elev. 118.03 N.S. of M.H. rim on 15th St @ alley between Washington & Wabash.

GORDON

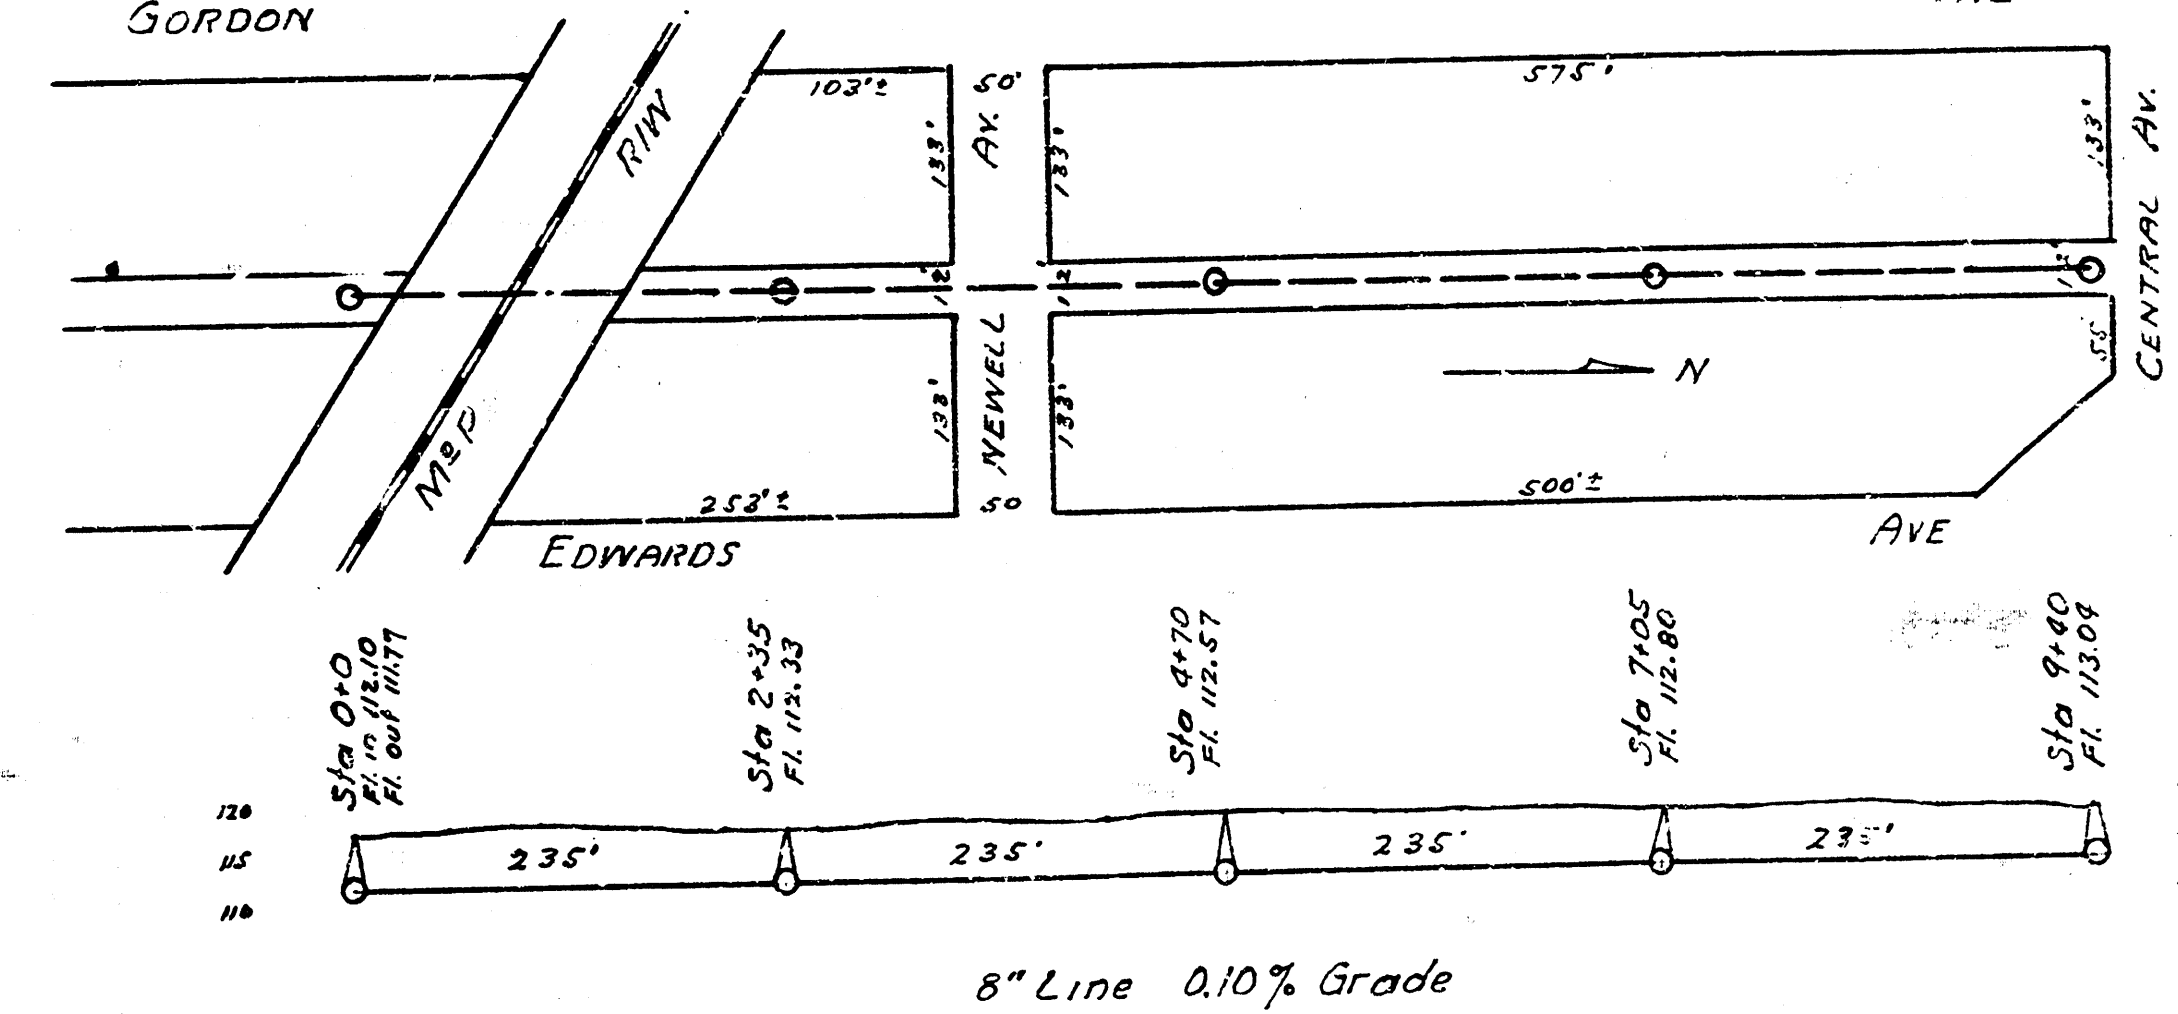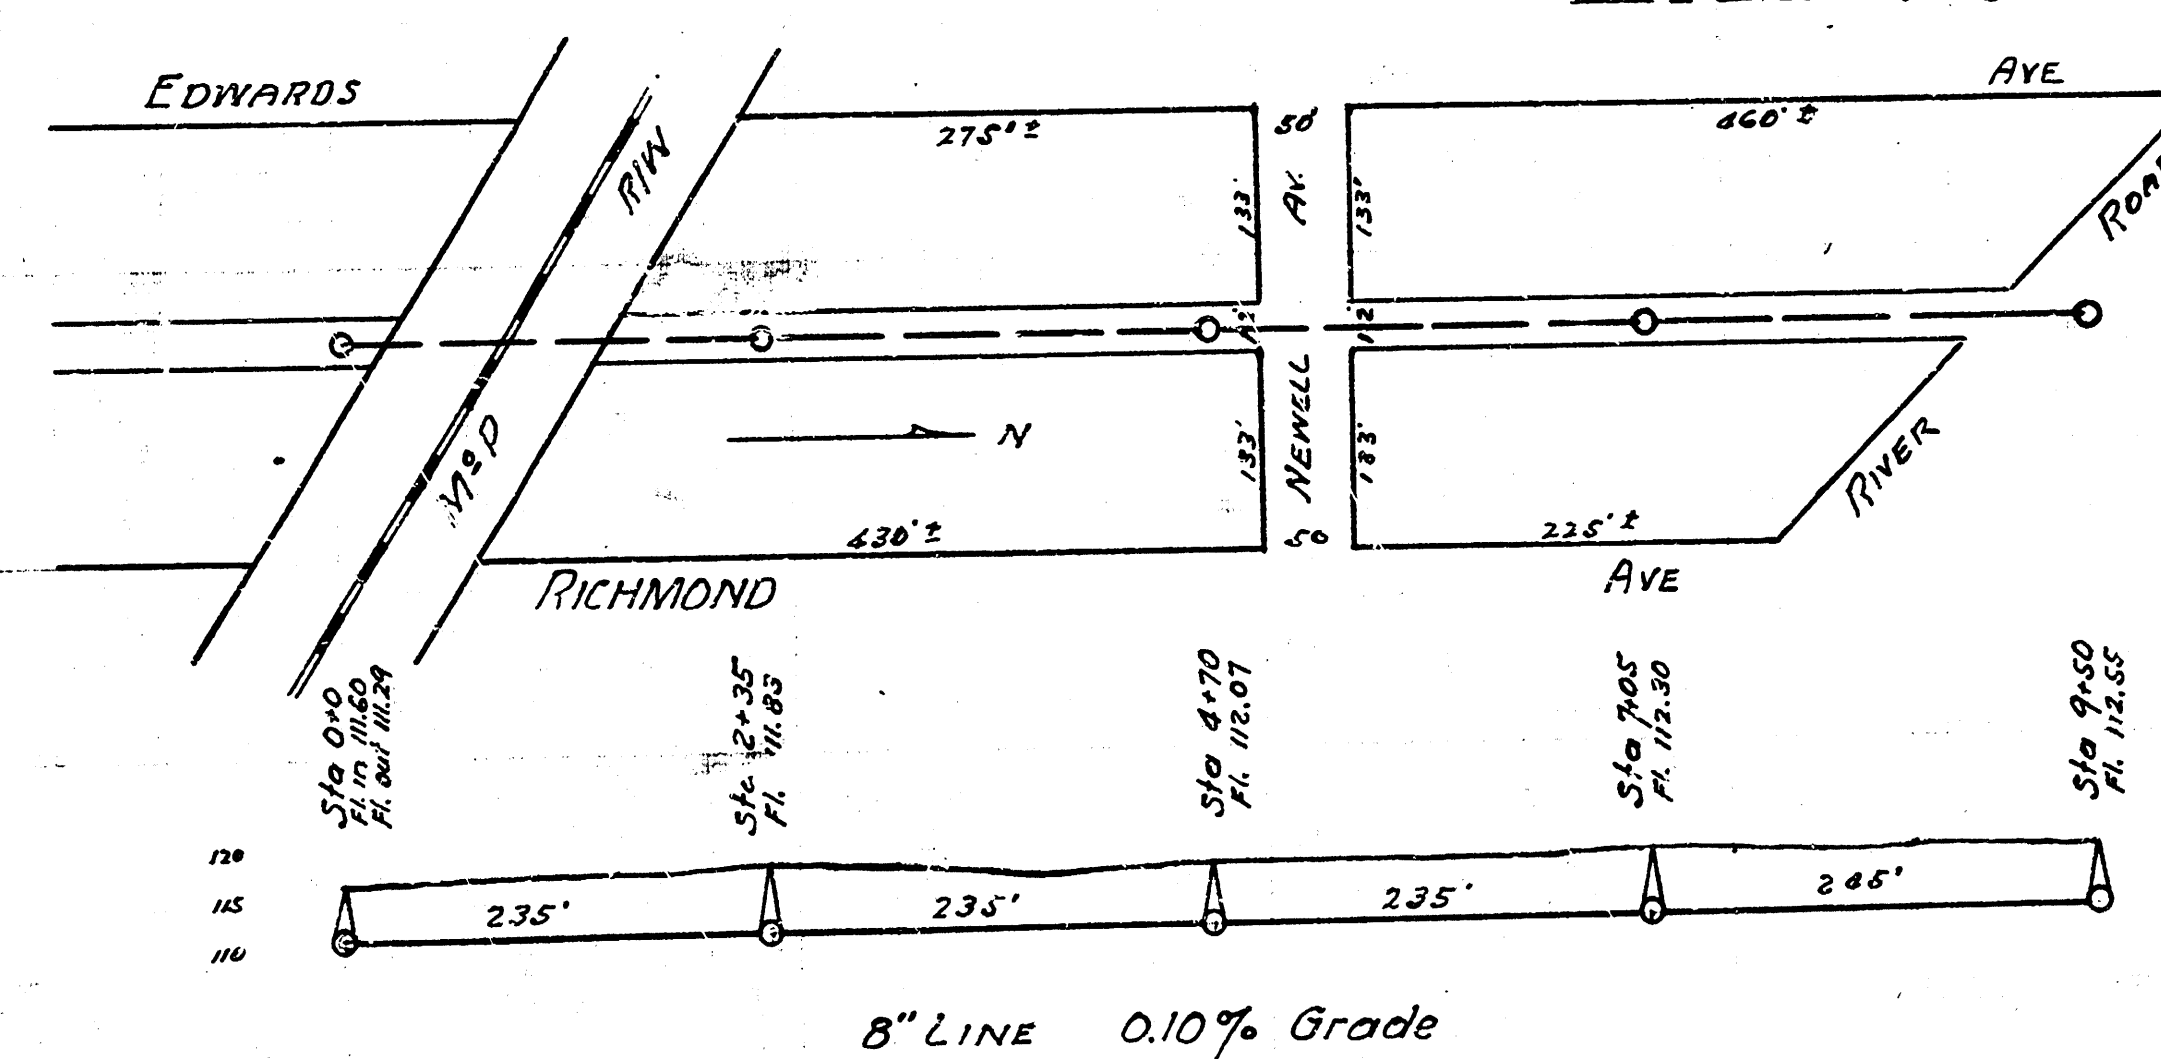

B.M. Elev. 117.76 'K' in Kensler c. Mt W. S.W. Edwards & 2nd
R.M. Elev. 116.99 Rim of M.H. E. of Edwards & R.W.
B.M. Elev. 119.52 On Tracks 1st Joint W. of Edwards