


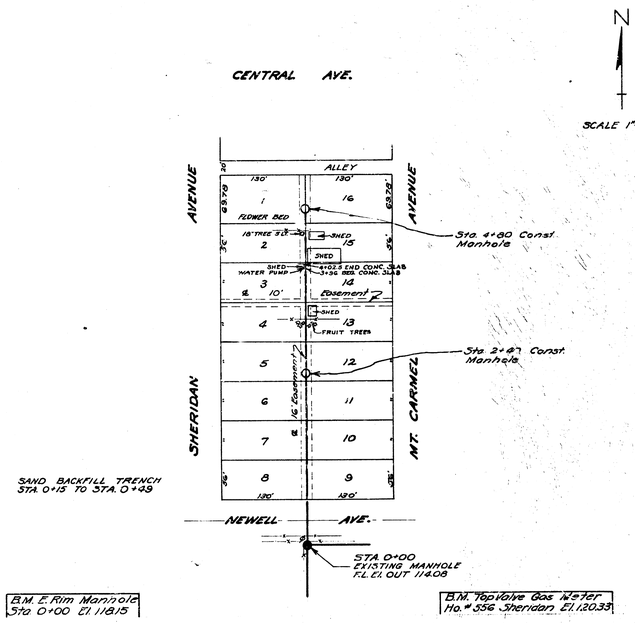


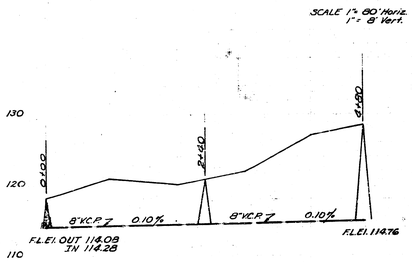

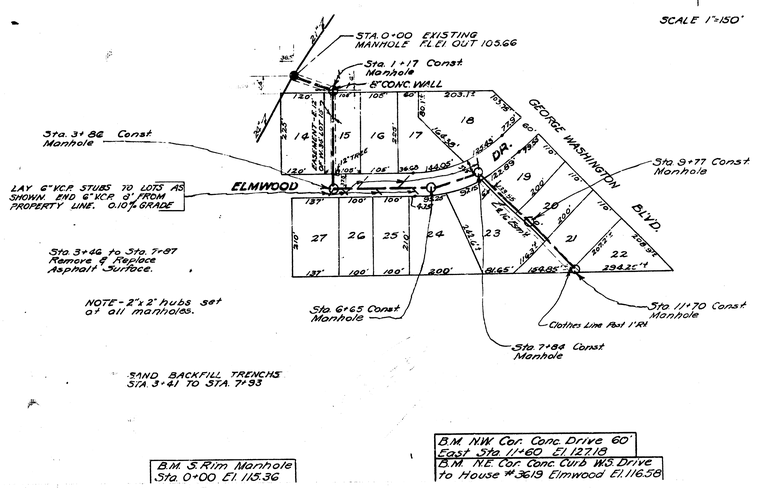

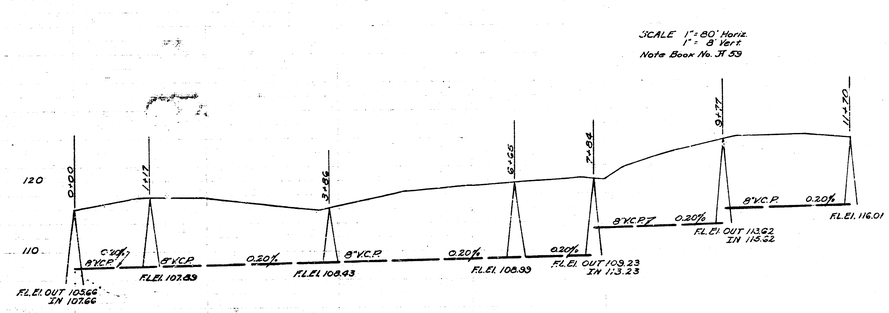

B.M. NW. Cor. Conc. Drive 60' East Sta. 11+60 El. 127.18
B.M. NE Cor. Conc. Curb W.S. Drive to House # 3619 Elmwood El. 116.58

B.M. S. Rim Manhole Sta. 0+00 El. 115.36

10/18/61
J.L.A.
Date
Drawn by
Checked by
Note Book No. # 1

LAT. 28 DIST. A MAIN 21
CITY OF WICHITA KANSAS
L.K. WHITE CITY ENGINEER
Proj. No. C21-22

LAT. 57 D.C.S. #12
CITY OF WICHITA KANSAS
L.K. WHITE CITY ENGINEER
Proj. No. C21-40