


WALKER AVE		MONROE AVE		RICHMOND AVE		WHEELER AVE	
248	249	248	249	248	249	248	249


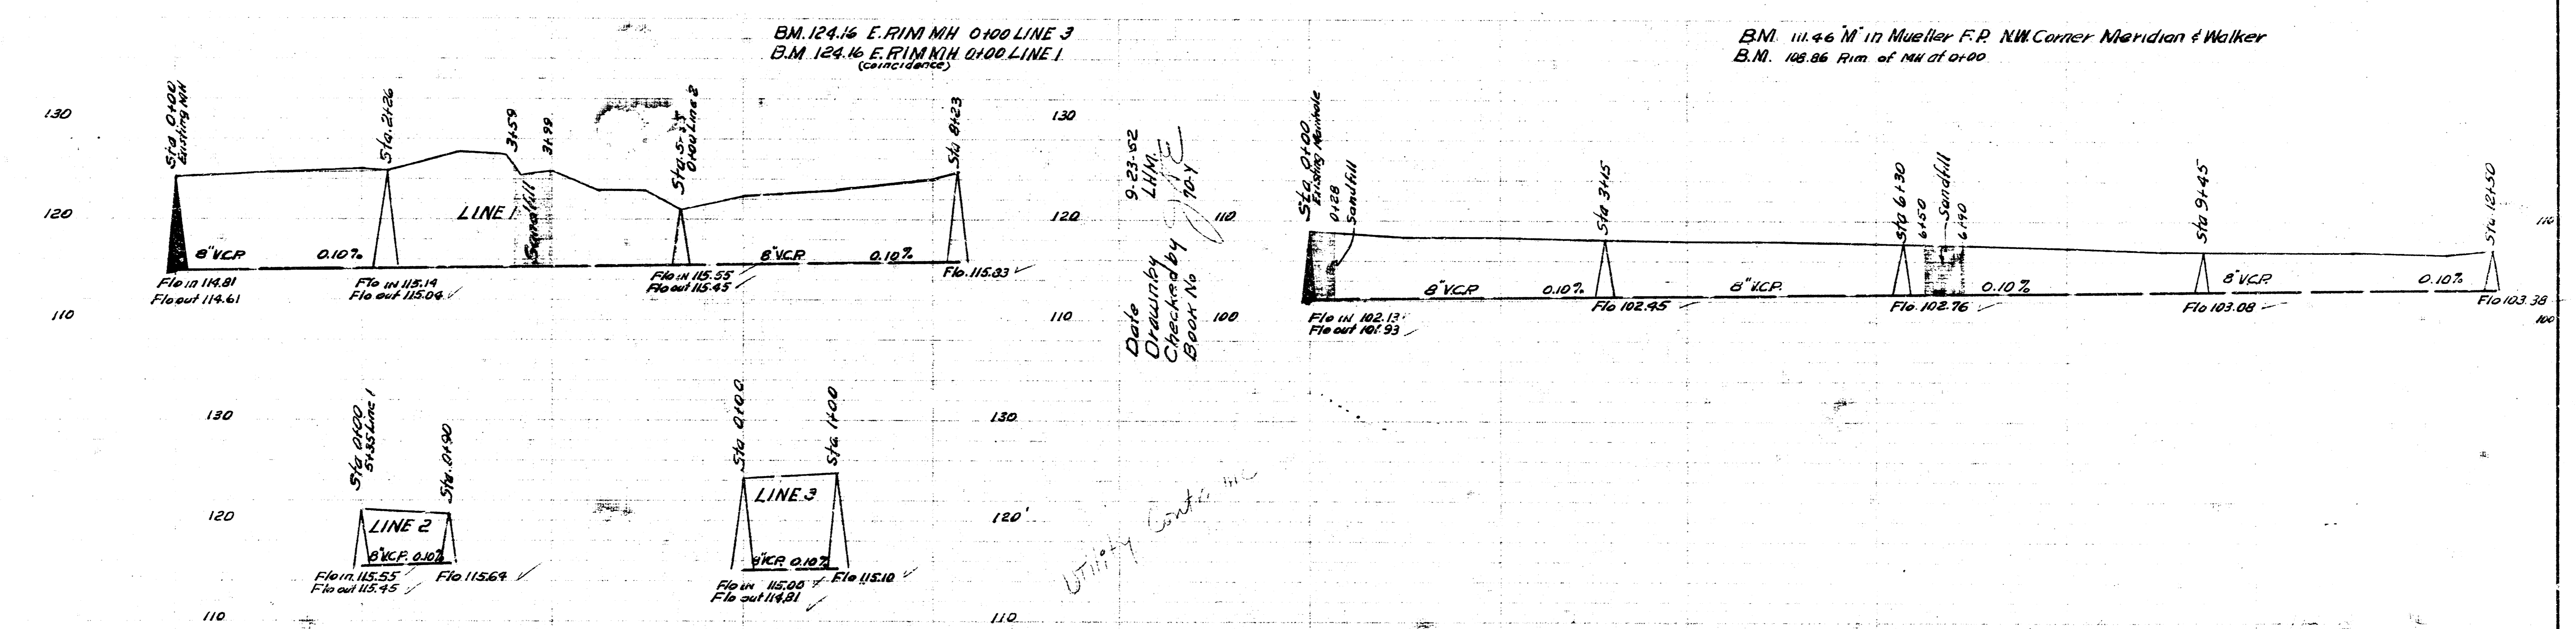

LAT. 3 DIST. R SS. 20
 CITY OF WICHITA KANSAS
 L. WHITE CITY ENGINEER
 Proj. No. C-22-71

LAT. 8 DIST. B SS. 21
 CITY OF WICHITA KANSAS
 L. WHITE CITY ENGINEER
 Proj. No. C-22-74