

LAT. 20, DIST. C, S.S. 20.

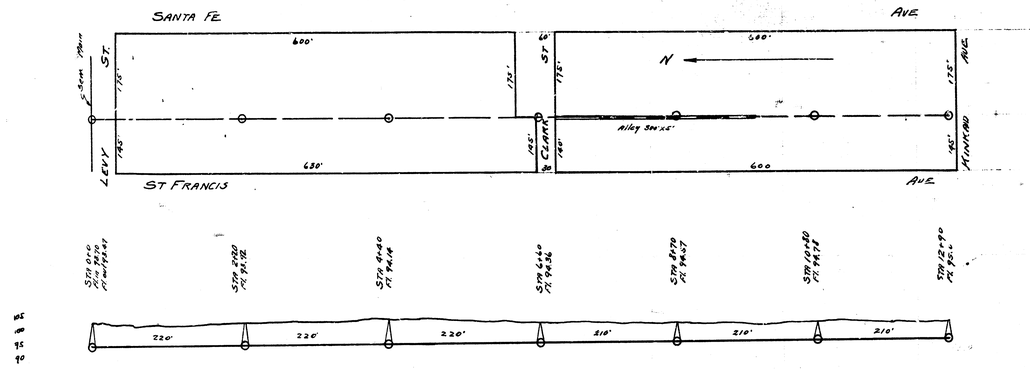

8" line .17% Grade

B.M. 102.01 U in Jones bk. 4 Wk. N. NE. Santa Fe + Levy.


LAT. 1, DIST. B, S.S. 20

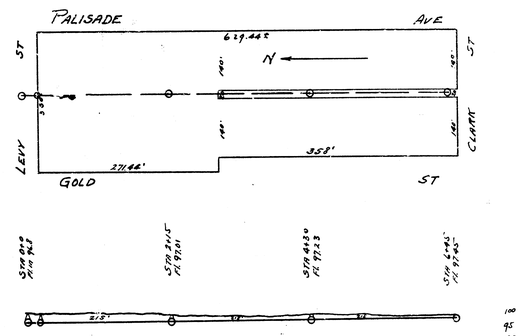


8" line .17% Grade

B.M. 99.93 G in GW.S. bk. wk. S. SW. Levy + Gold.

LAT. F, DIST. E, S.S. 21.

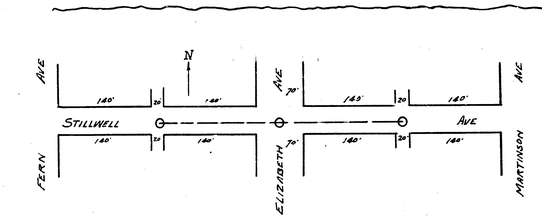


15" Line 0.08% grade

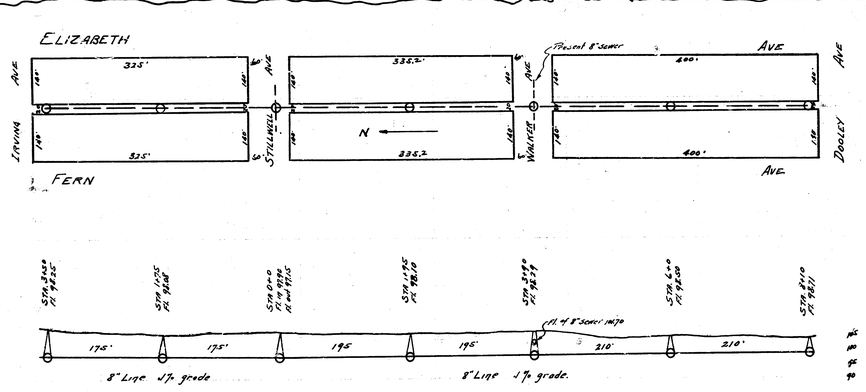

8" Line .17% grade

8" Line .17% grade.

LAT. 21, DIST. C, S.S. NO. 20.

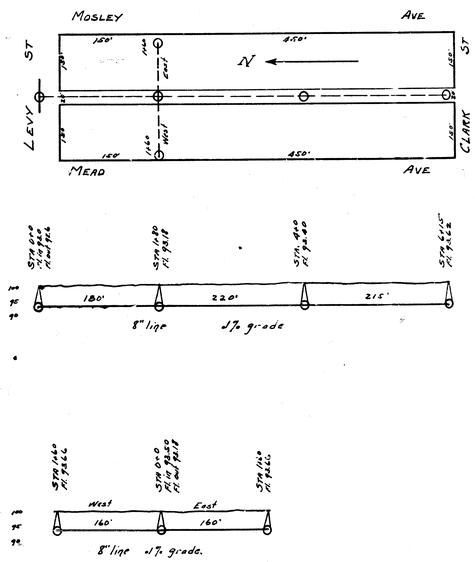

8" line .17% grade.