

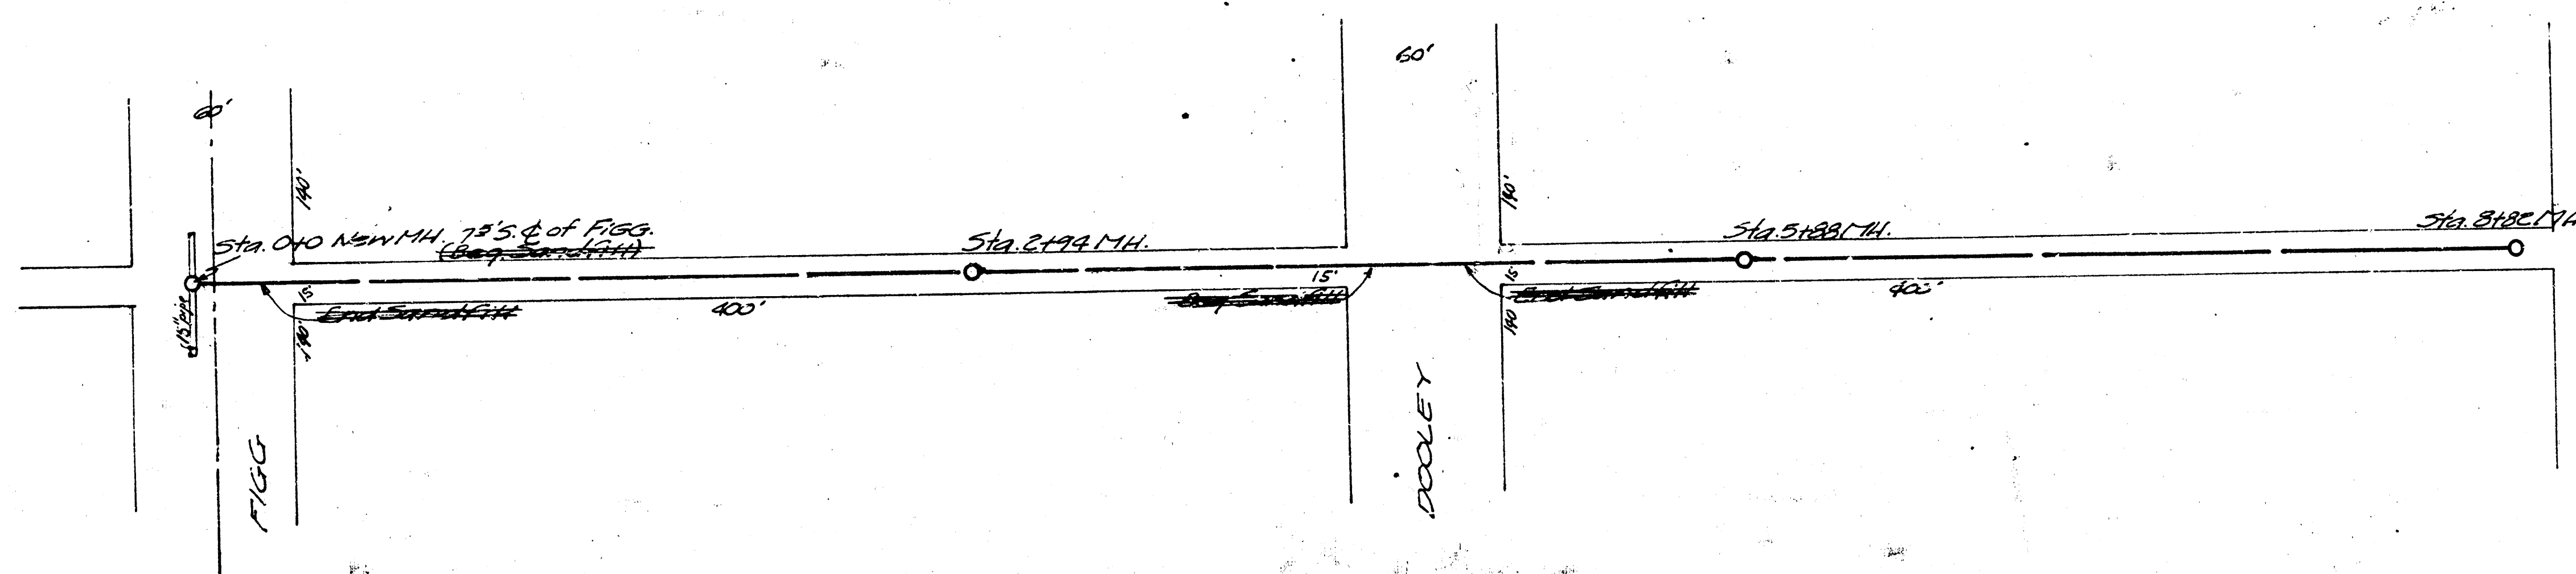


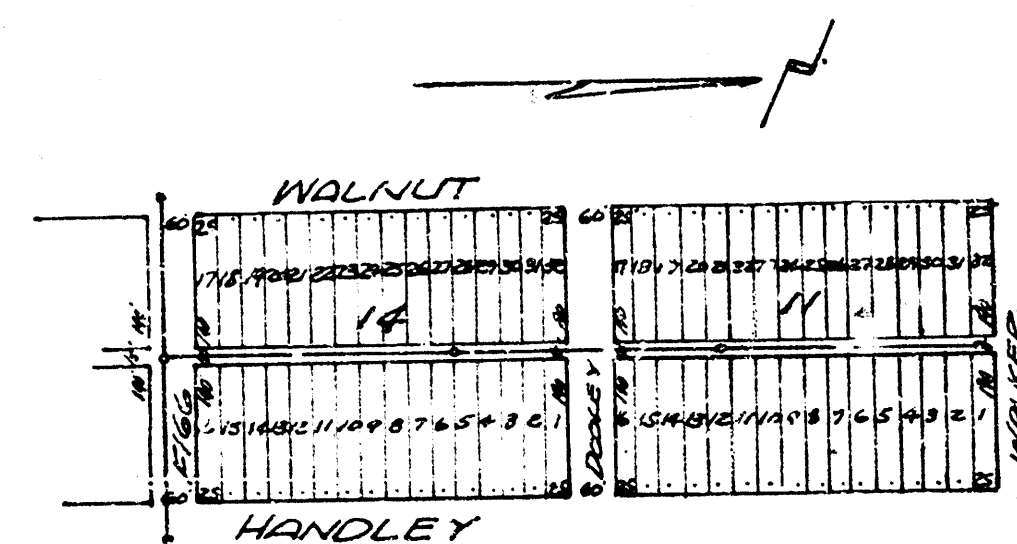

Scale: 1" = 40'
11/16" Claim 25/16"

87.13.91 S.W. Cor. Top. Step. Nos. 1240 So. Flag
Bn. 100.82 E. Bm. 141. @ Flag of WALNUT.
Scale: 1" = 4' Vertical
1" = 40' Horizontal

LAT. P. DIST. E, 55.21
Proj. No. C21-5

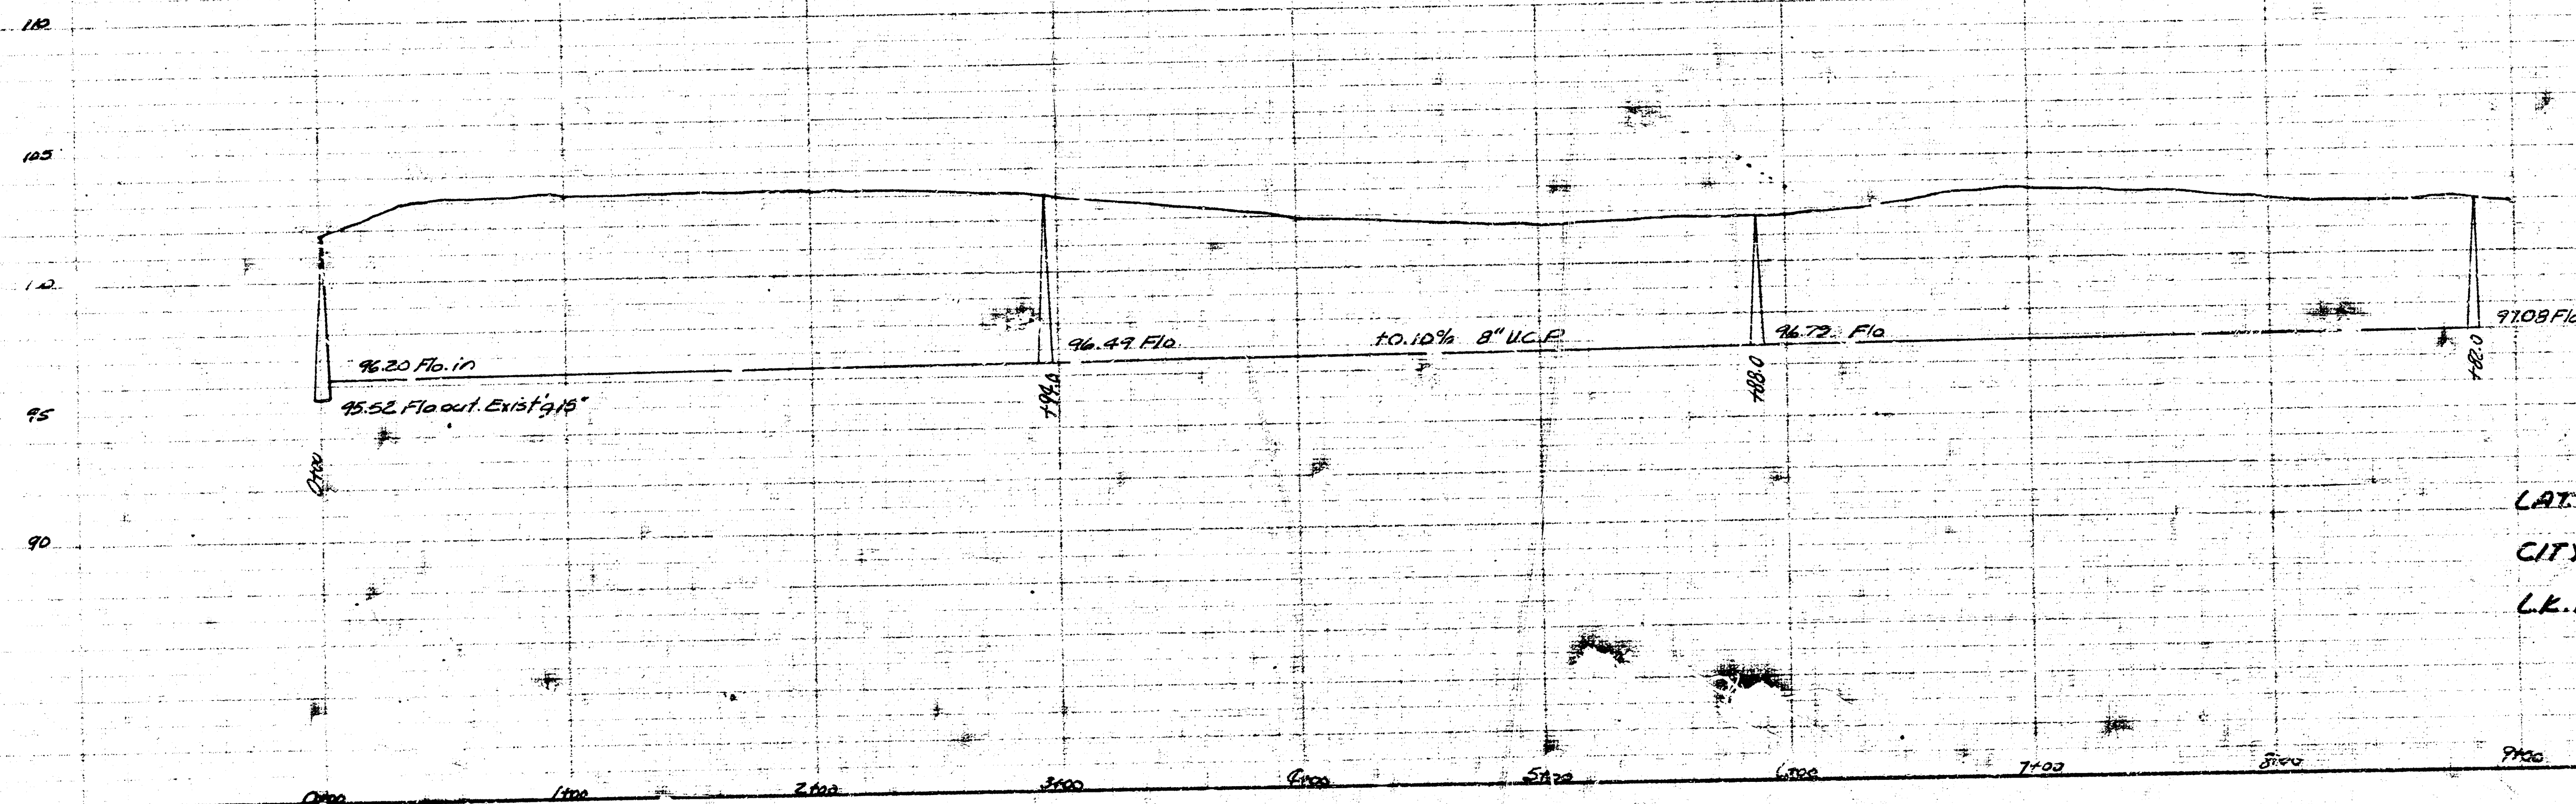

LAT. P. DIST. E, 55.21
CITY OF WICHITA, KANSAS
L.E. WHITE, CITY ENGINEER
Proj. No. C21-5
1951