




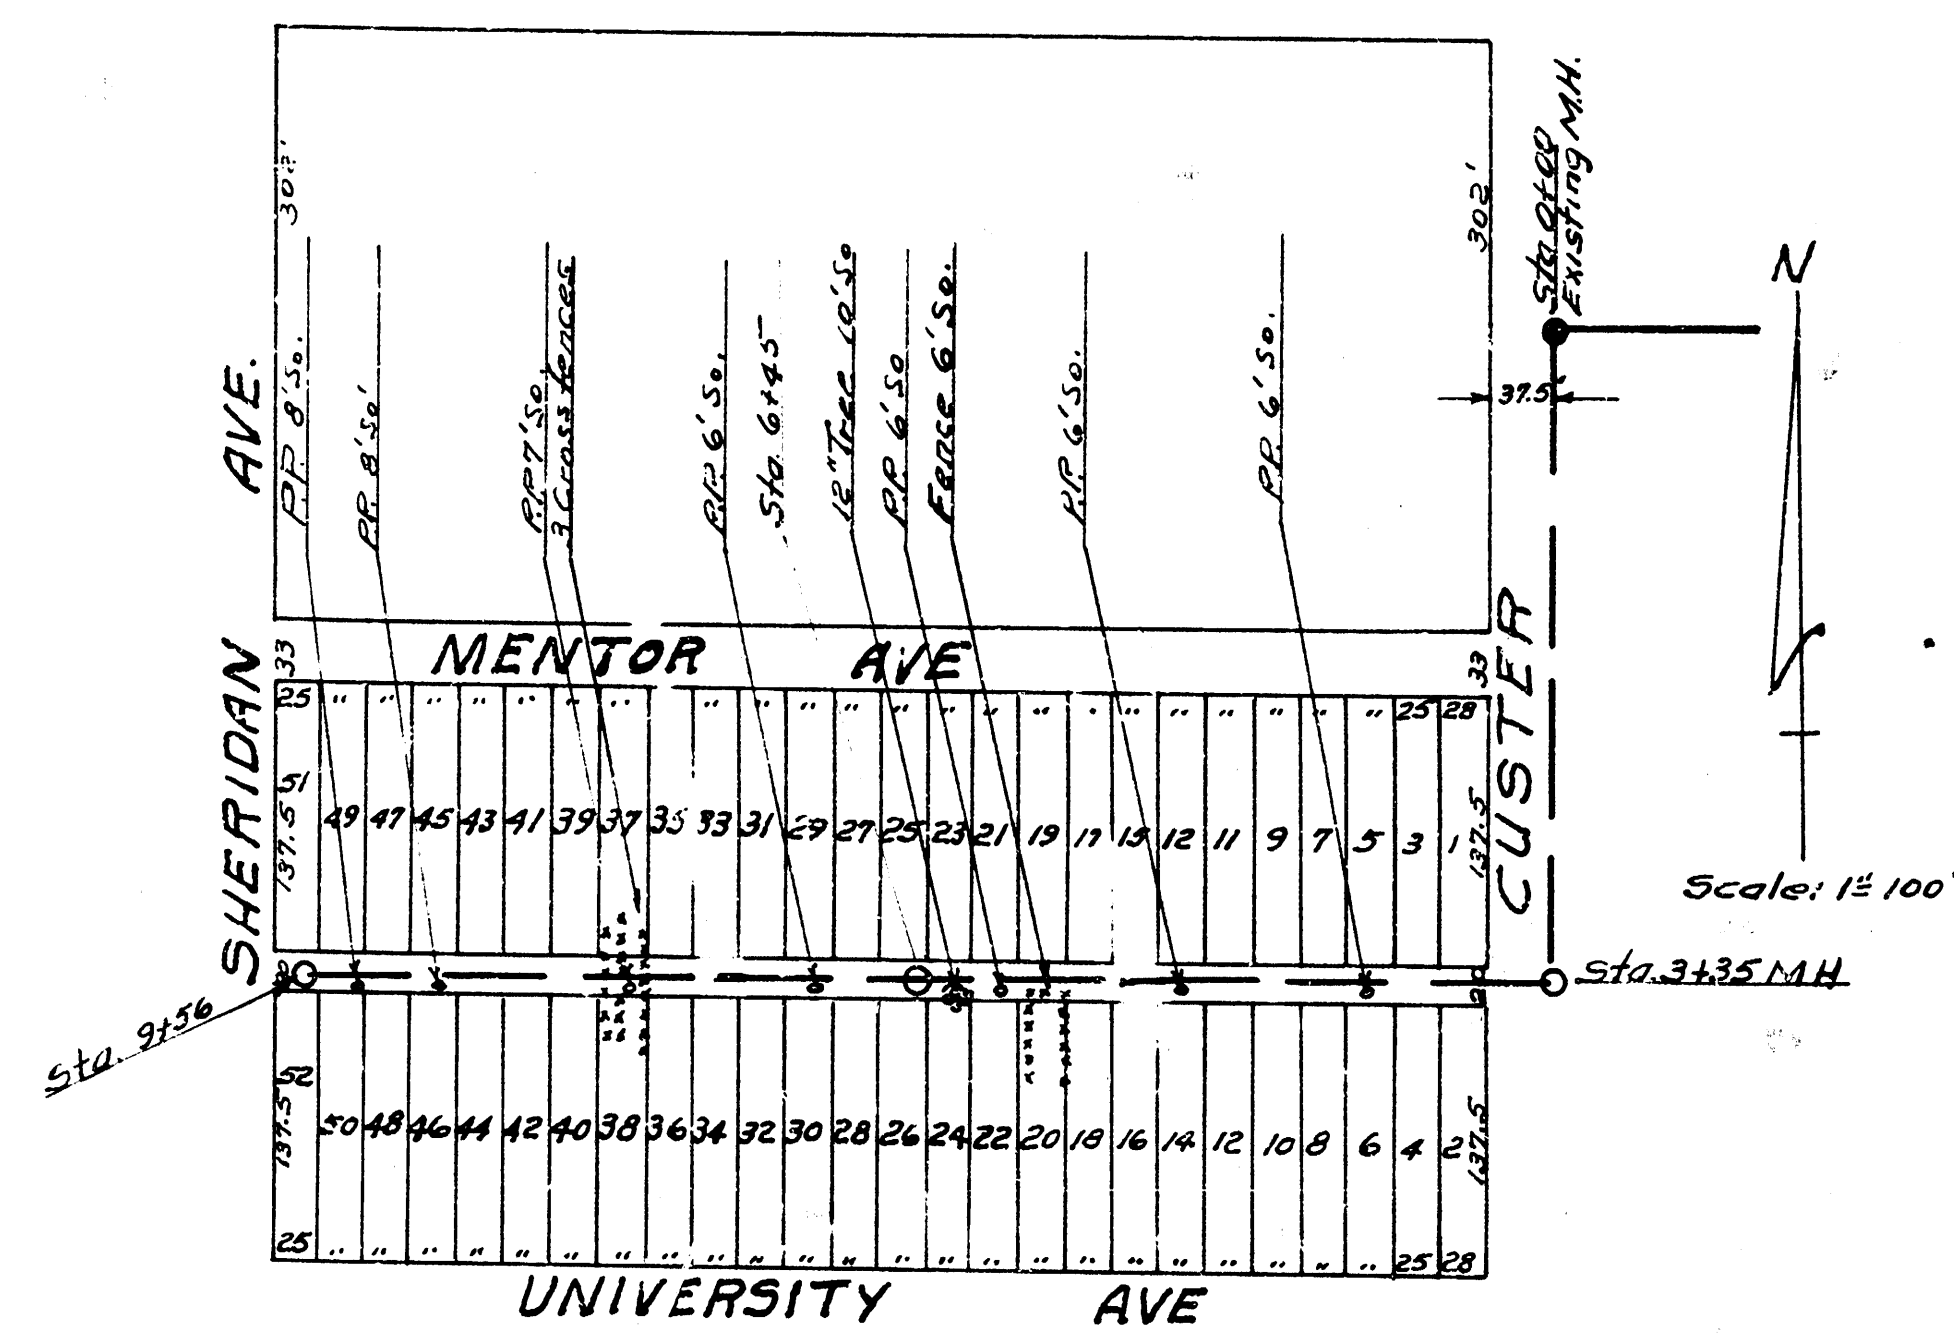


B.M. 114.18 Top MH 0+00 So. Rim.

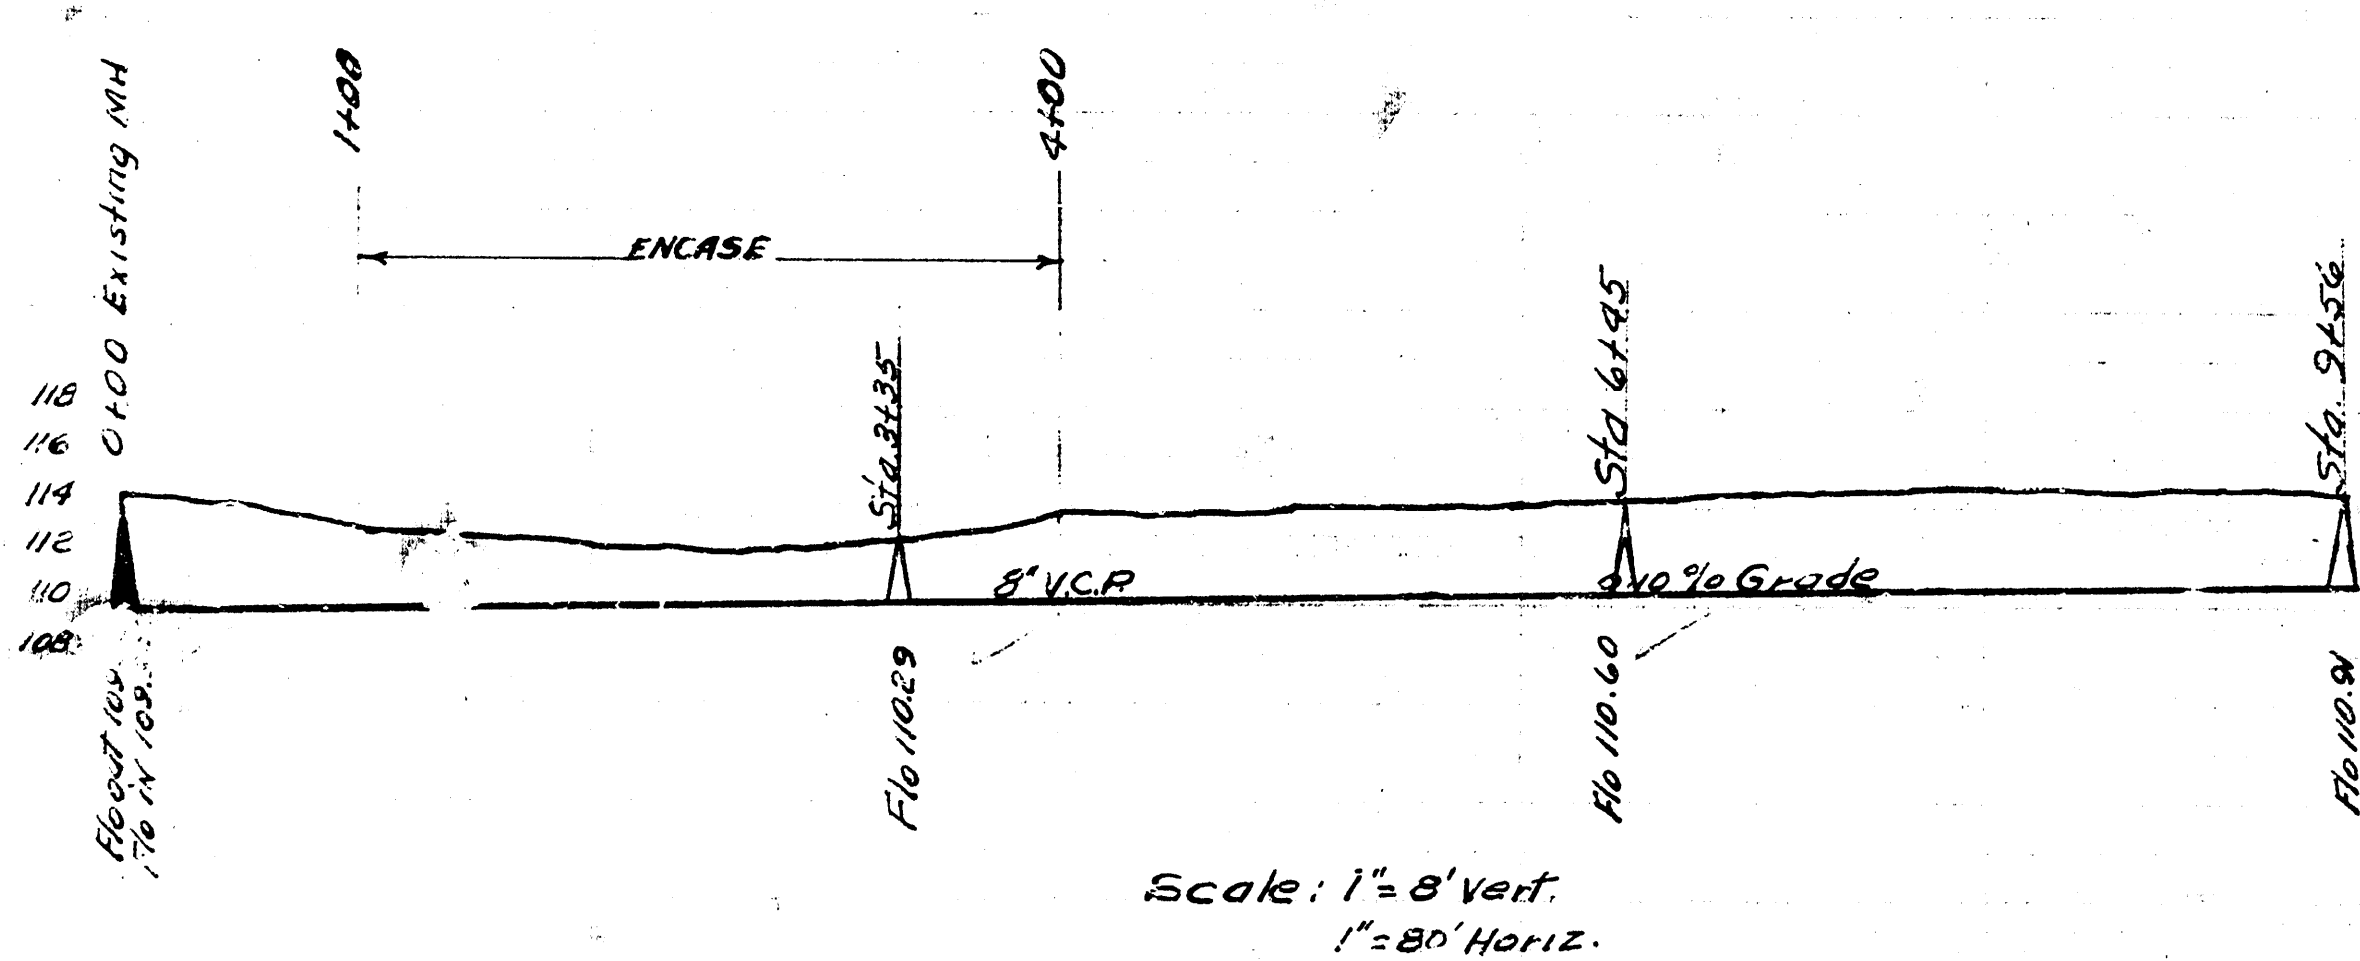

LAT 29 DIST A SS#21
CITY OF WICHITA KANSAS
L.K. WHITE CITY ENGINEER
Proj No. C-21-55

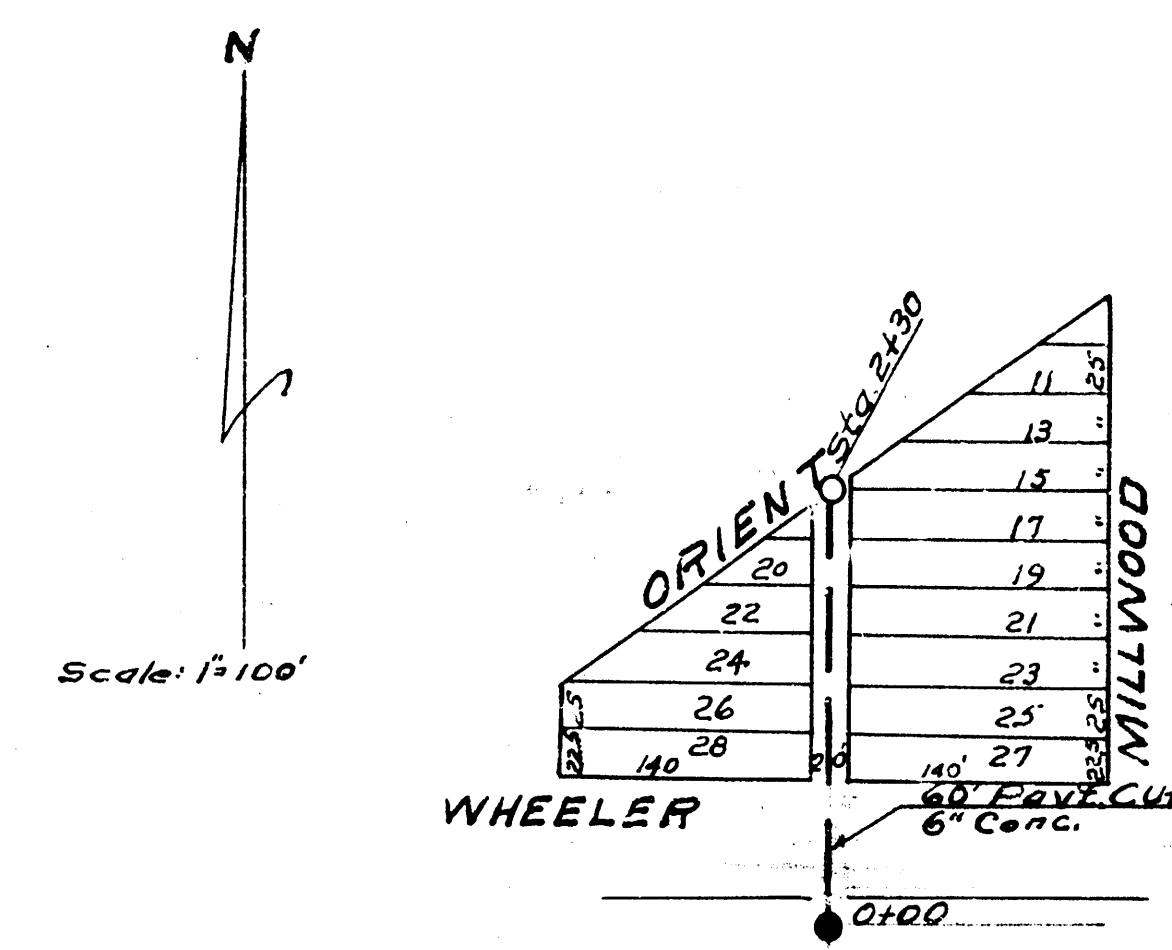

B.M. 104.40 So. Rim M.H. 0+00

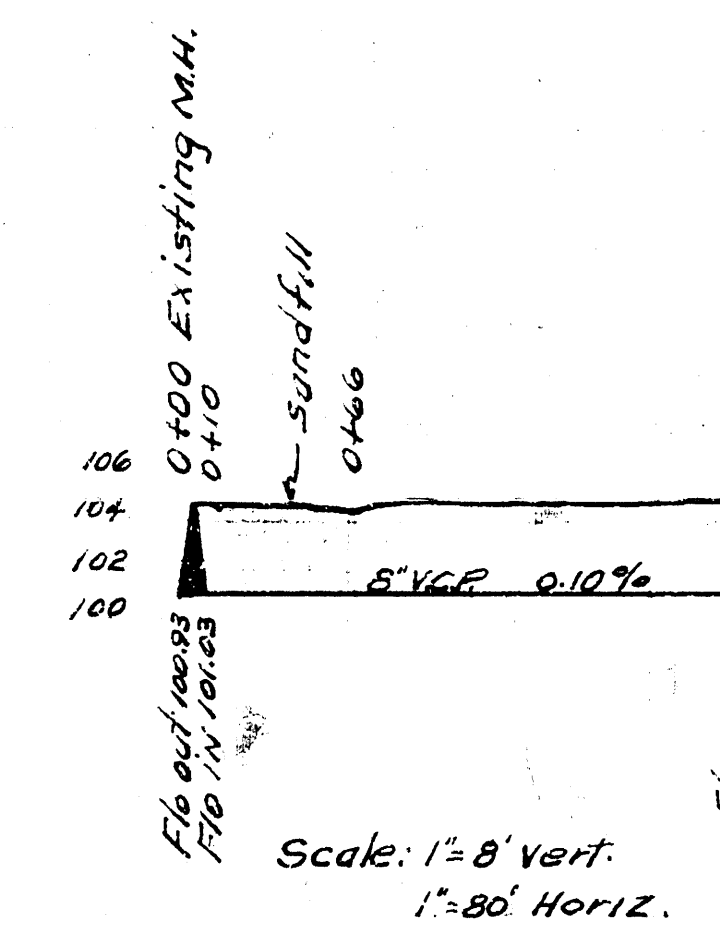

LAT. T. DIST. E. SS#21
CITY OF WICHITA KANSAS
L.K. WHITE CITY ENGINEER
Proj No. C-21-67

Date: 8-4-52
Drawn by: L.M.C.I.
Checked by: G-1

Date: 8-4-52
Drawn by: L.M.C.I.
Checked by: G-1