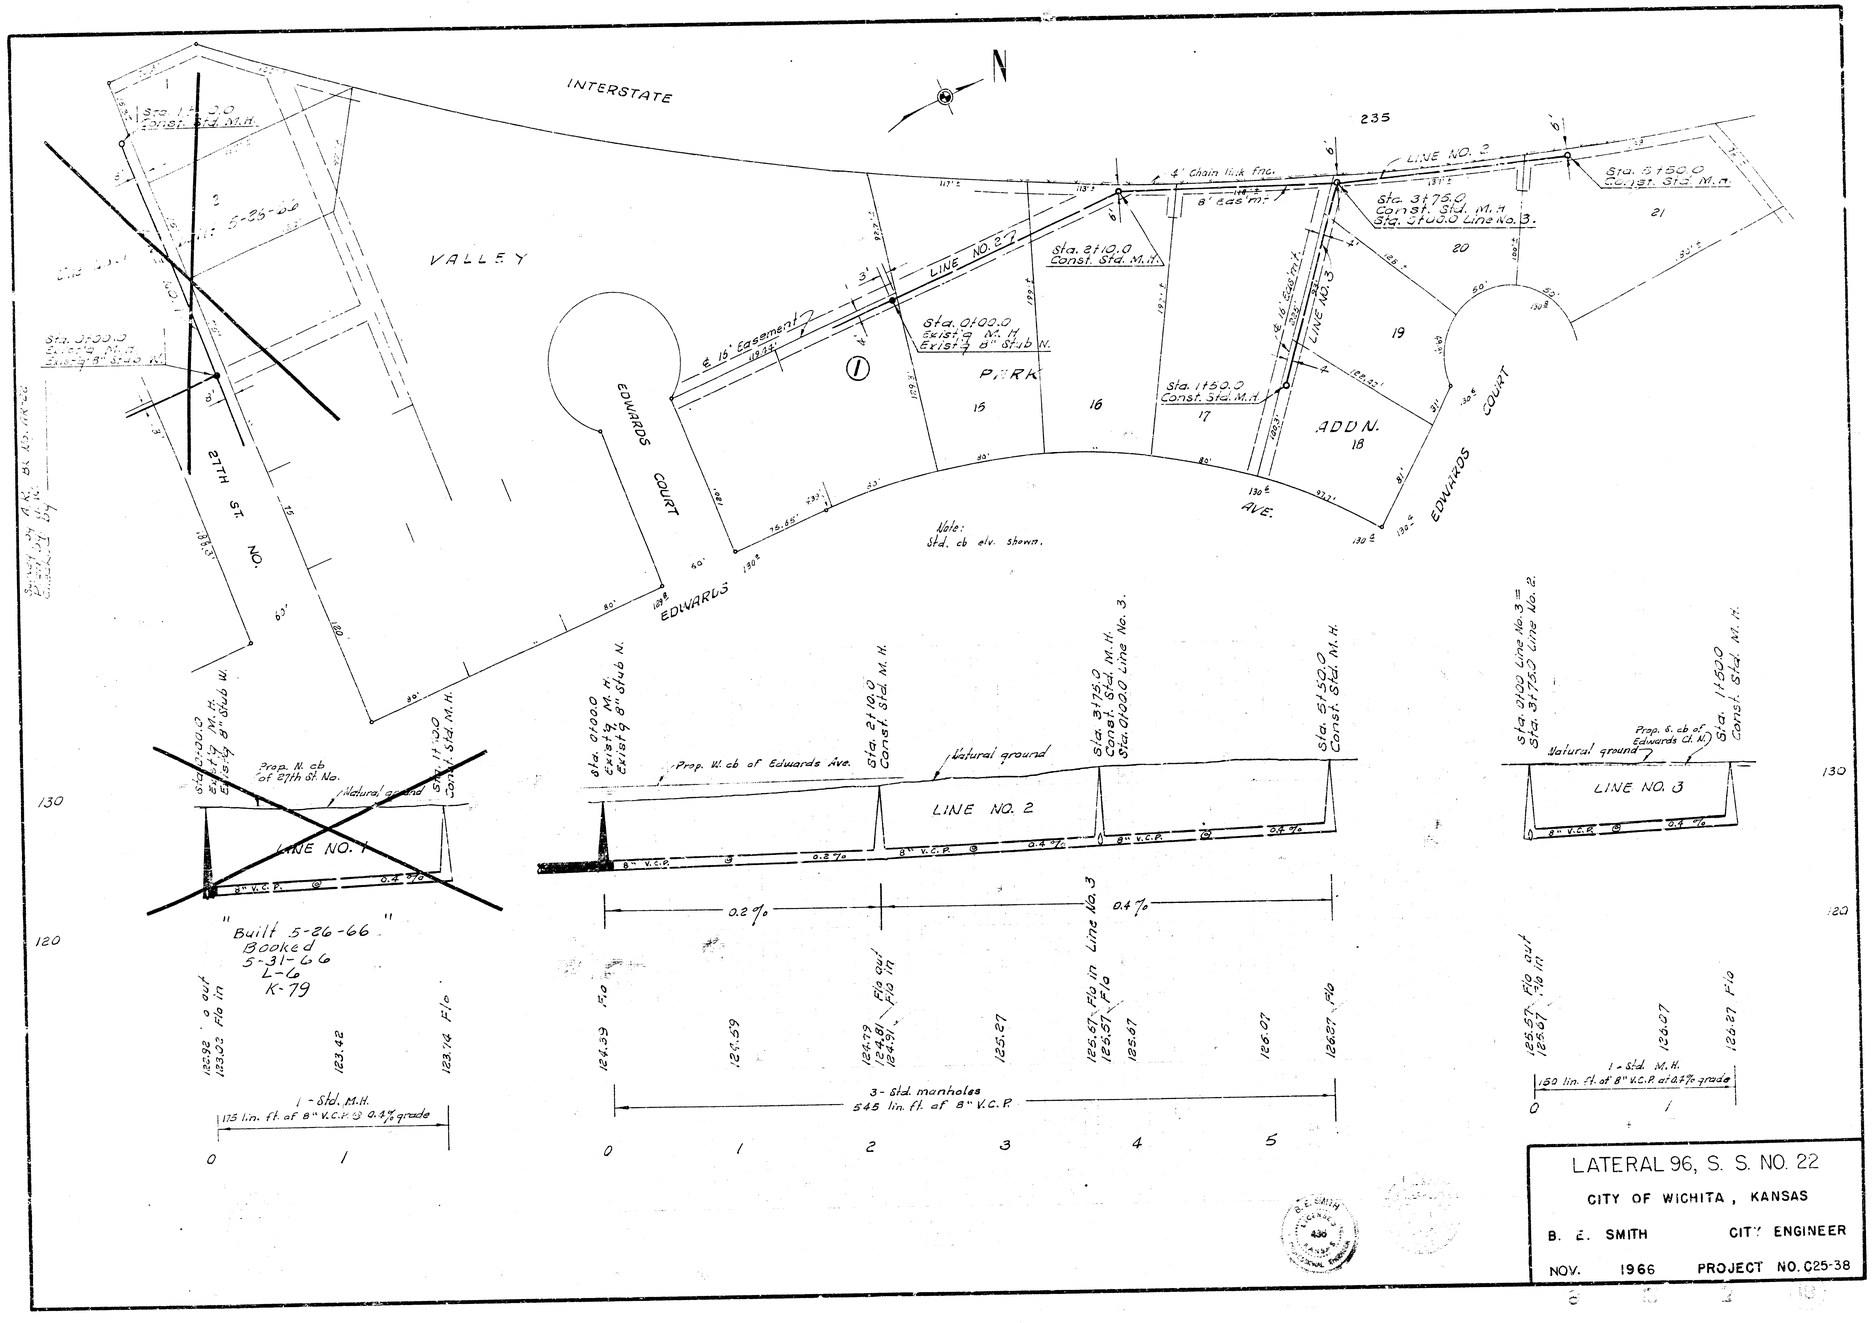
INTERSTATE
N
VALLEY
PARK
ADDN.
EDWARDS COURT
EDWARDS AVE.
27TH ST. NO.
LINE NO. 1
LINE NO. 2
LINE NO. 3
4' Chain link fnc.
8' Eas'm't.
6' Eas'm't.
Sta. 1+50.0 Const. Std. M.H.
Sta. 3+75.0 Const. Std. M.H. Sta. 5+00.0 Line No. 3.
Sta. 2+10.0 Const. Std. M.H.
Sta. 0+00.0 Exist'g M.H. Exist'g 8" Stub N.
Sta. 1+50.0 Const. Std. M.H.
Sta. 5+50.0 Const. Std. M.H.
Sta. 0+00.0 Exist'g M.H. Exist'g 8" Stub W.
Sta. 1+00.0 Const. Std. M.H.
Prop. N. cb of 27th St. No.
Natural ground
Prop. W. cb of Edwards Ave.
Prop. E. cb of Edwards Ct. N.
8" V.C.P. @ 0.4 %
0.2 %
0.4 %
"Built 5-26-66"
Booked
5-31-66
L-6
K-79
Note:
Std. cb elv. shown.
1 - Std. M.H.
115 lin. ft. of 8" V.C.P. @ 0.4% grade
3 - Std. manholes
545 lin. ft. of 8" V.C.P.
150 lin. ft. of 8" V.C.P. at 0.4% grade
LATERAL 96, S. S. NO. 22
CITY OF WICHITA, KANSAS
B. E. SMITH CITY ENGINEER
NOV. 1966 PROJECT NO. C25-38