





606.11
604.8

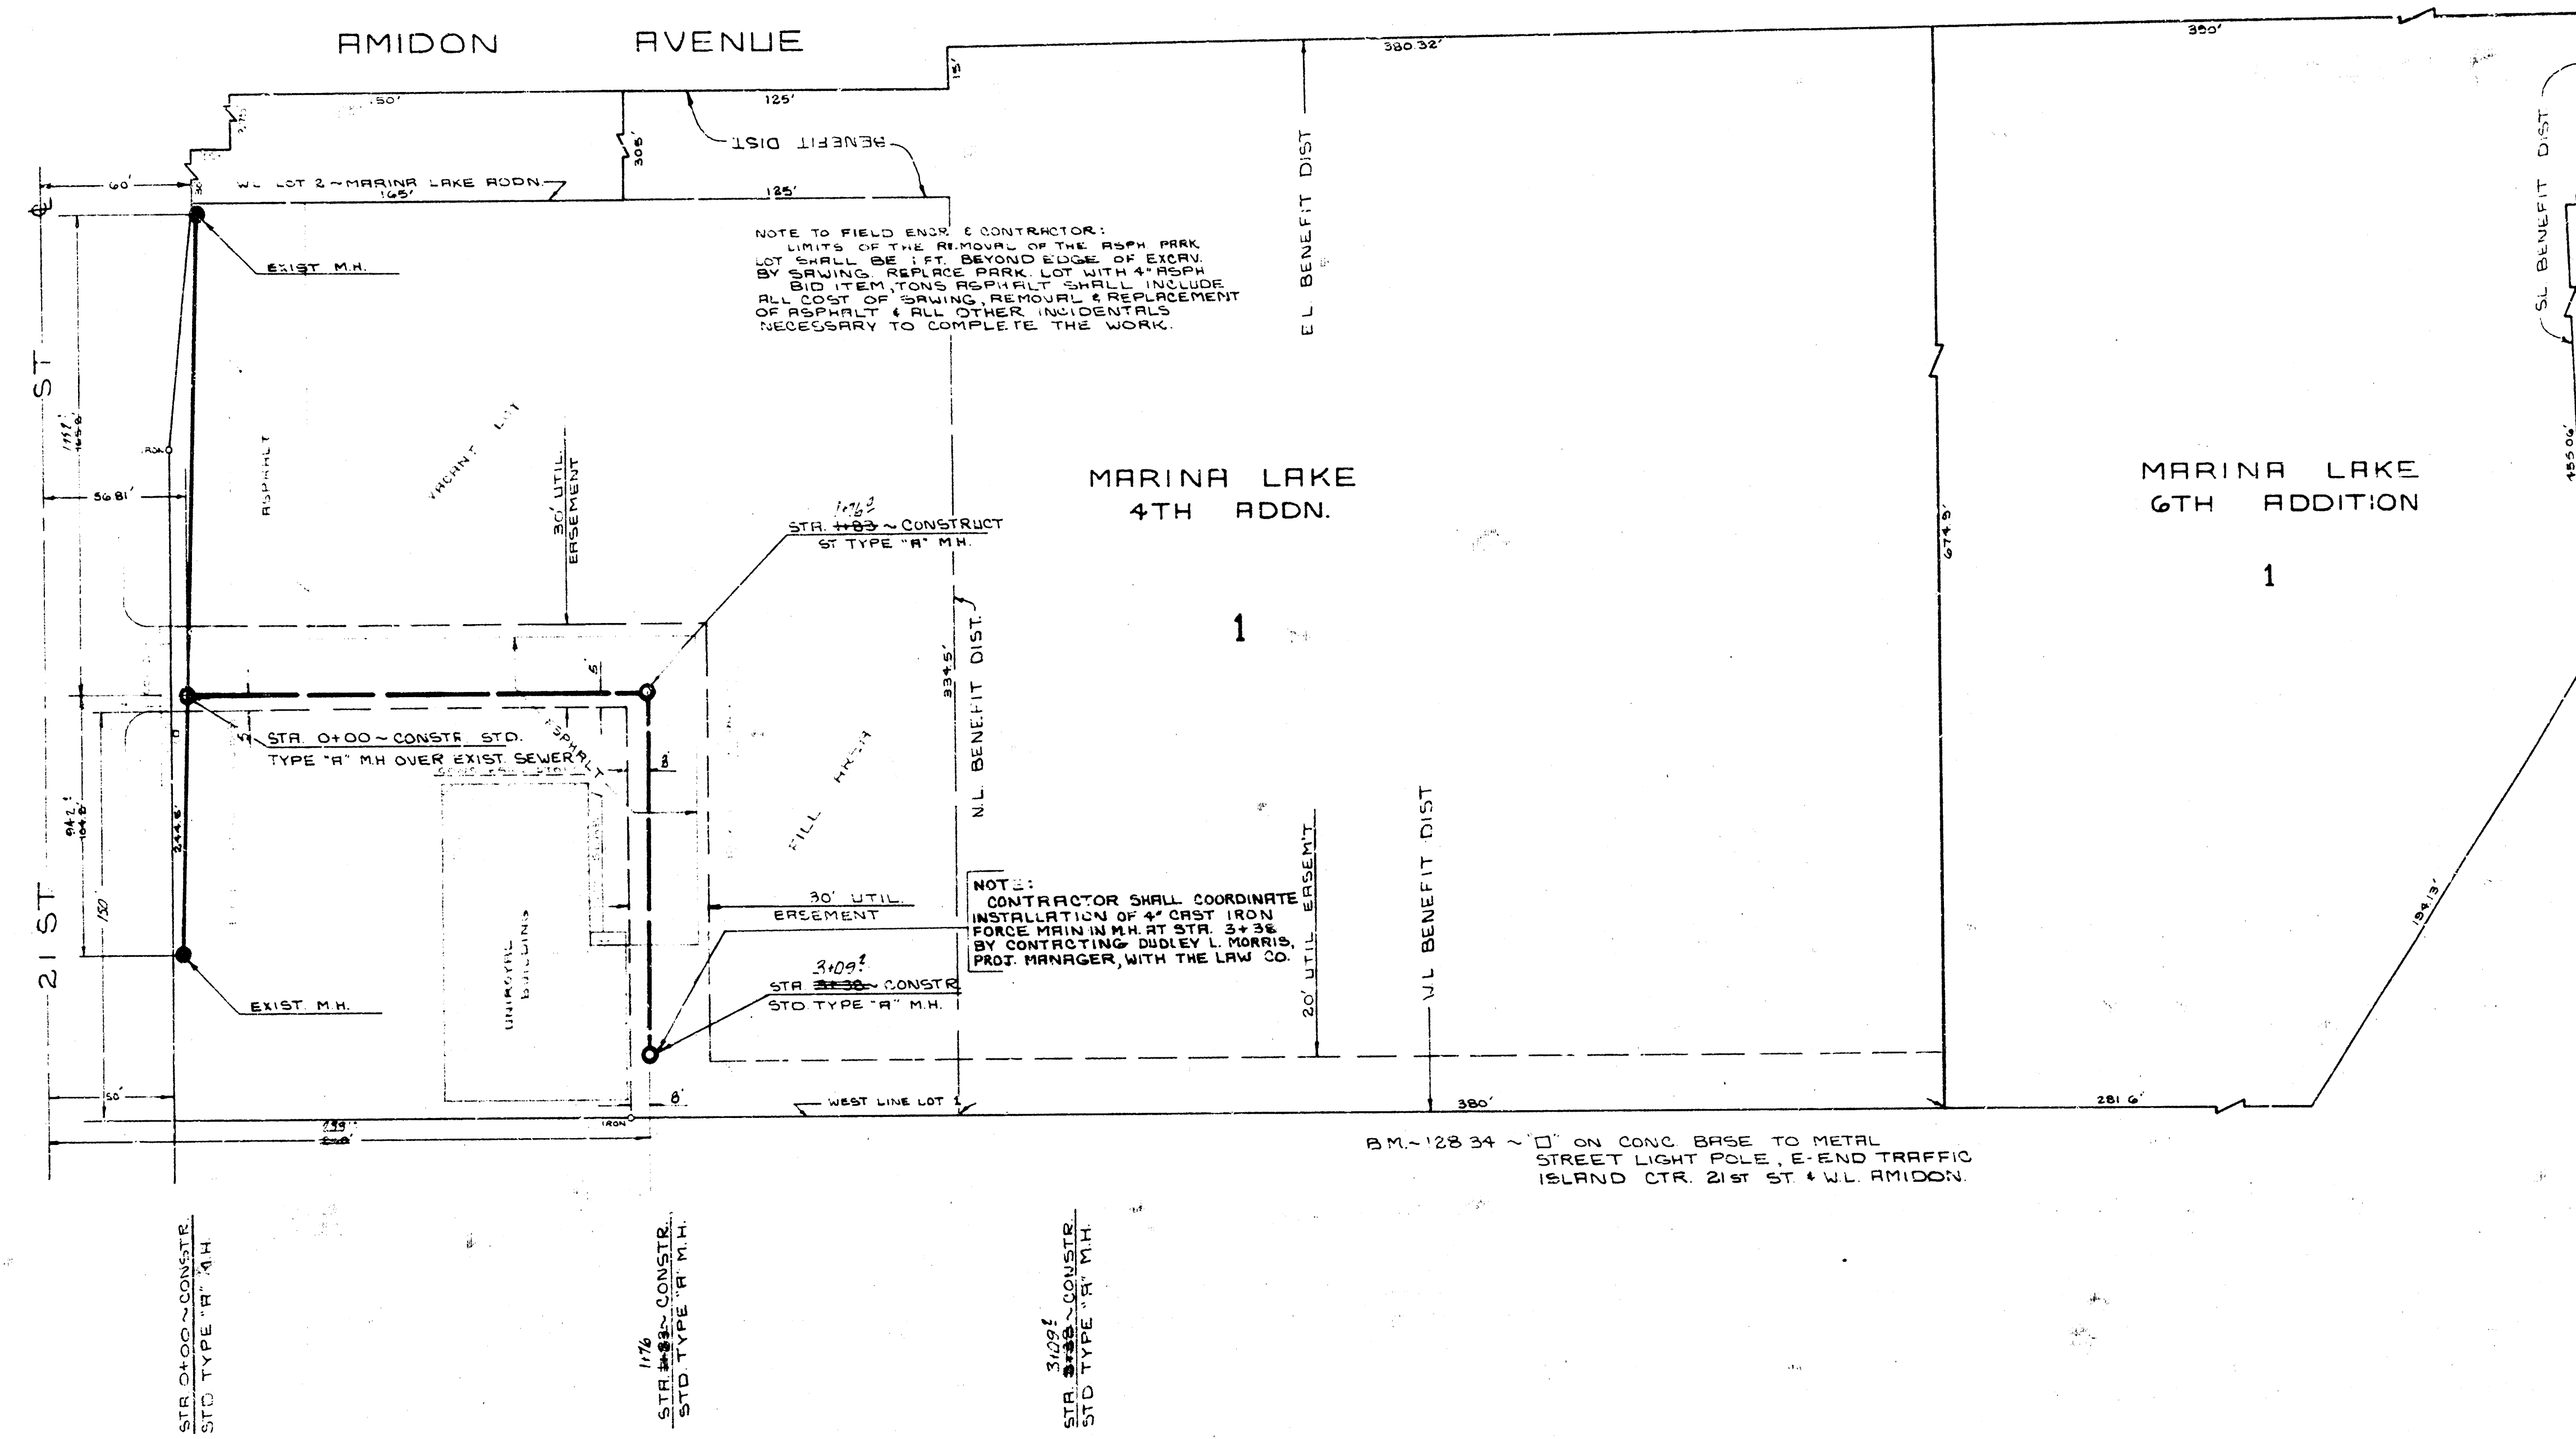

N
SCALE
VERTICAL ~ 1\"/>

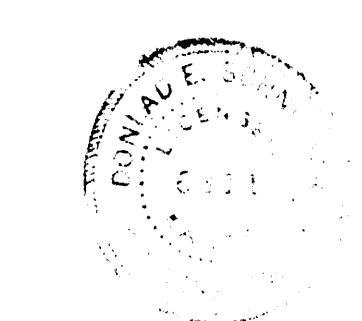

130
125
120
115
110

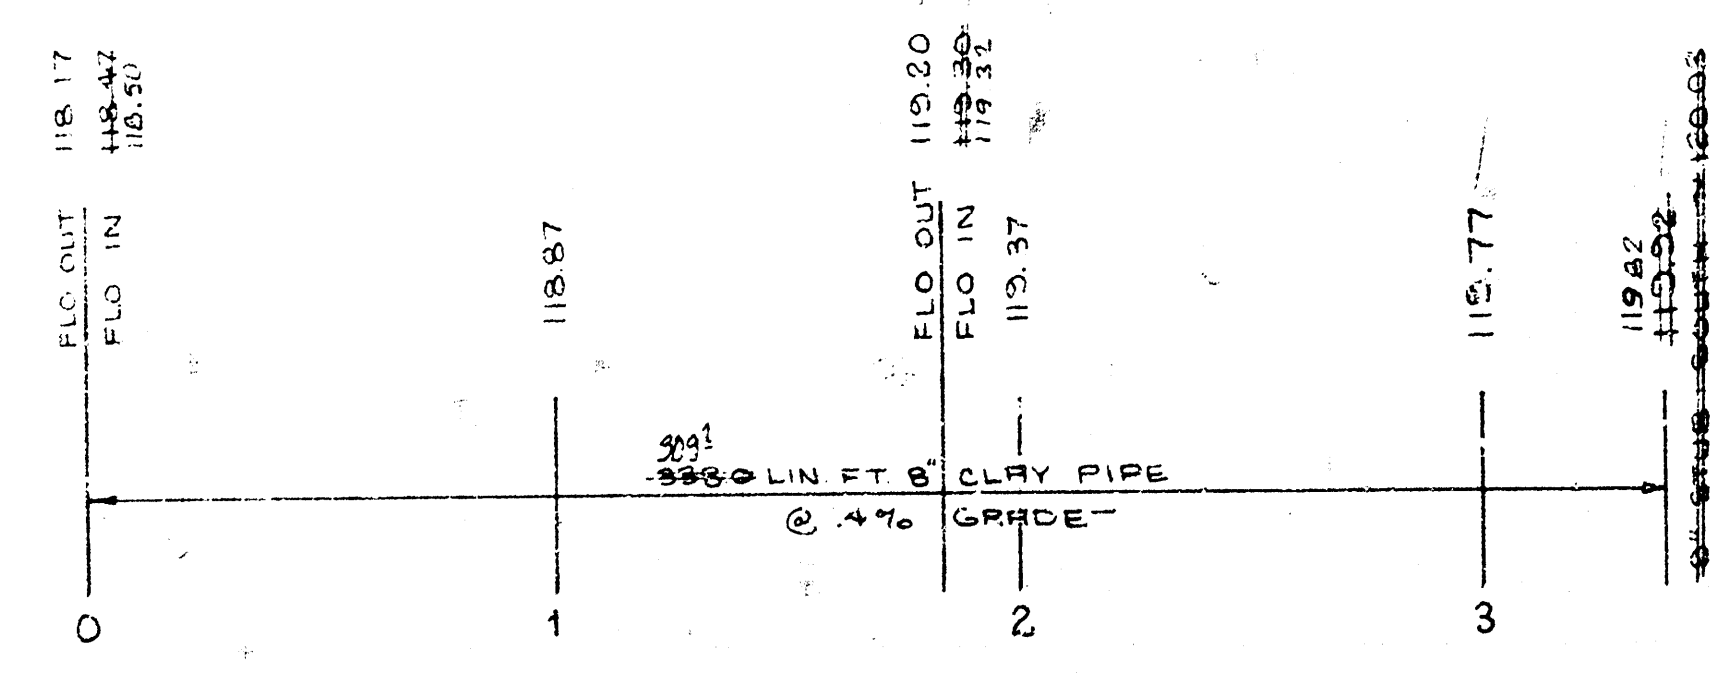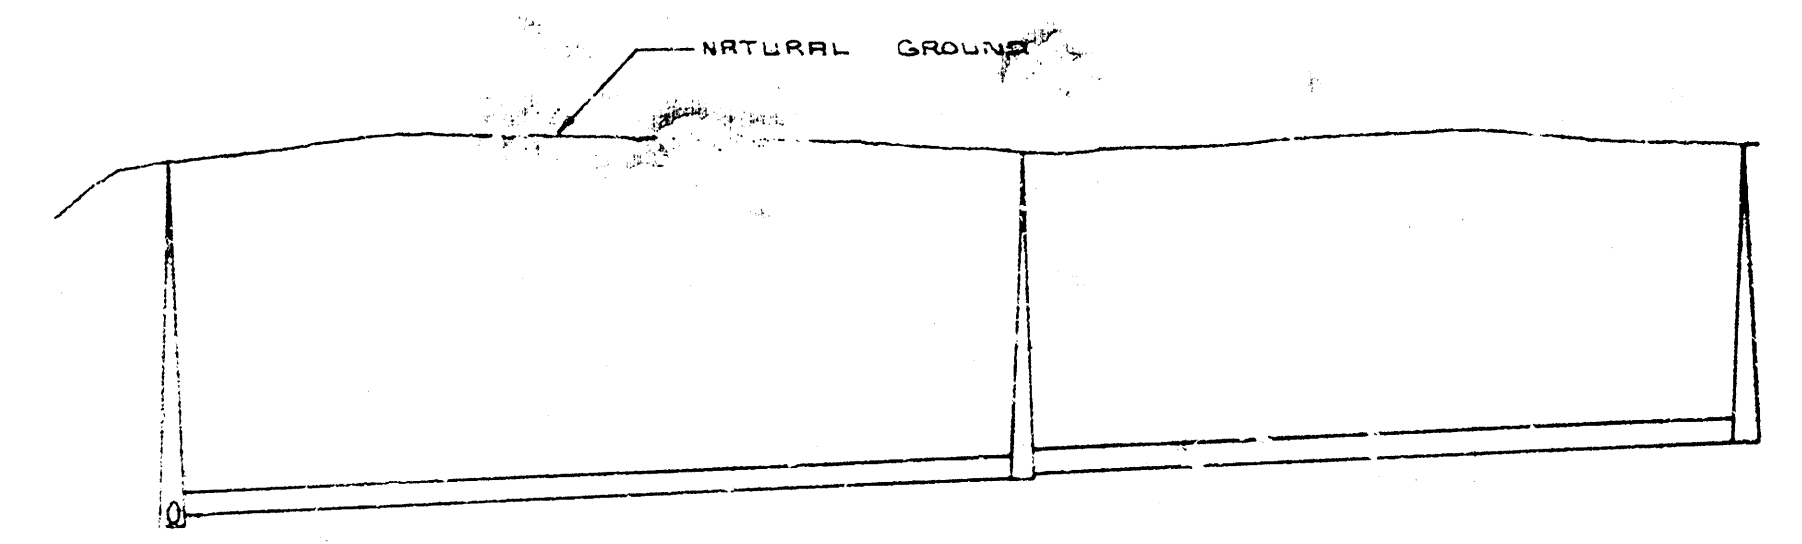

13 JUL 72
LAT 117 SS 22
CITY OF WICHITA
R.W. LINN CITY ENGINEER
DATE Aug. 1972 PROJECT NO. DBKL571029