

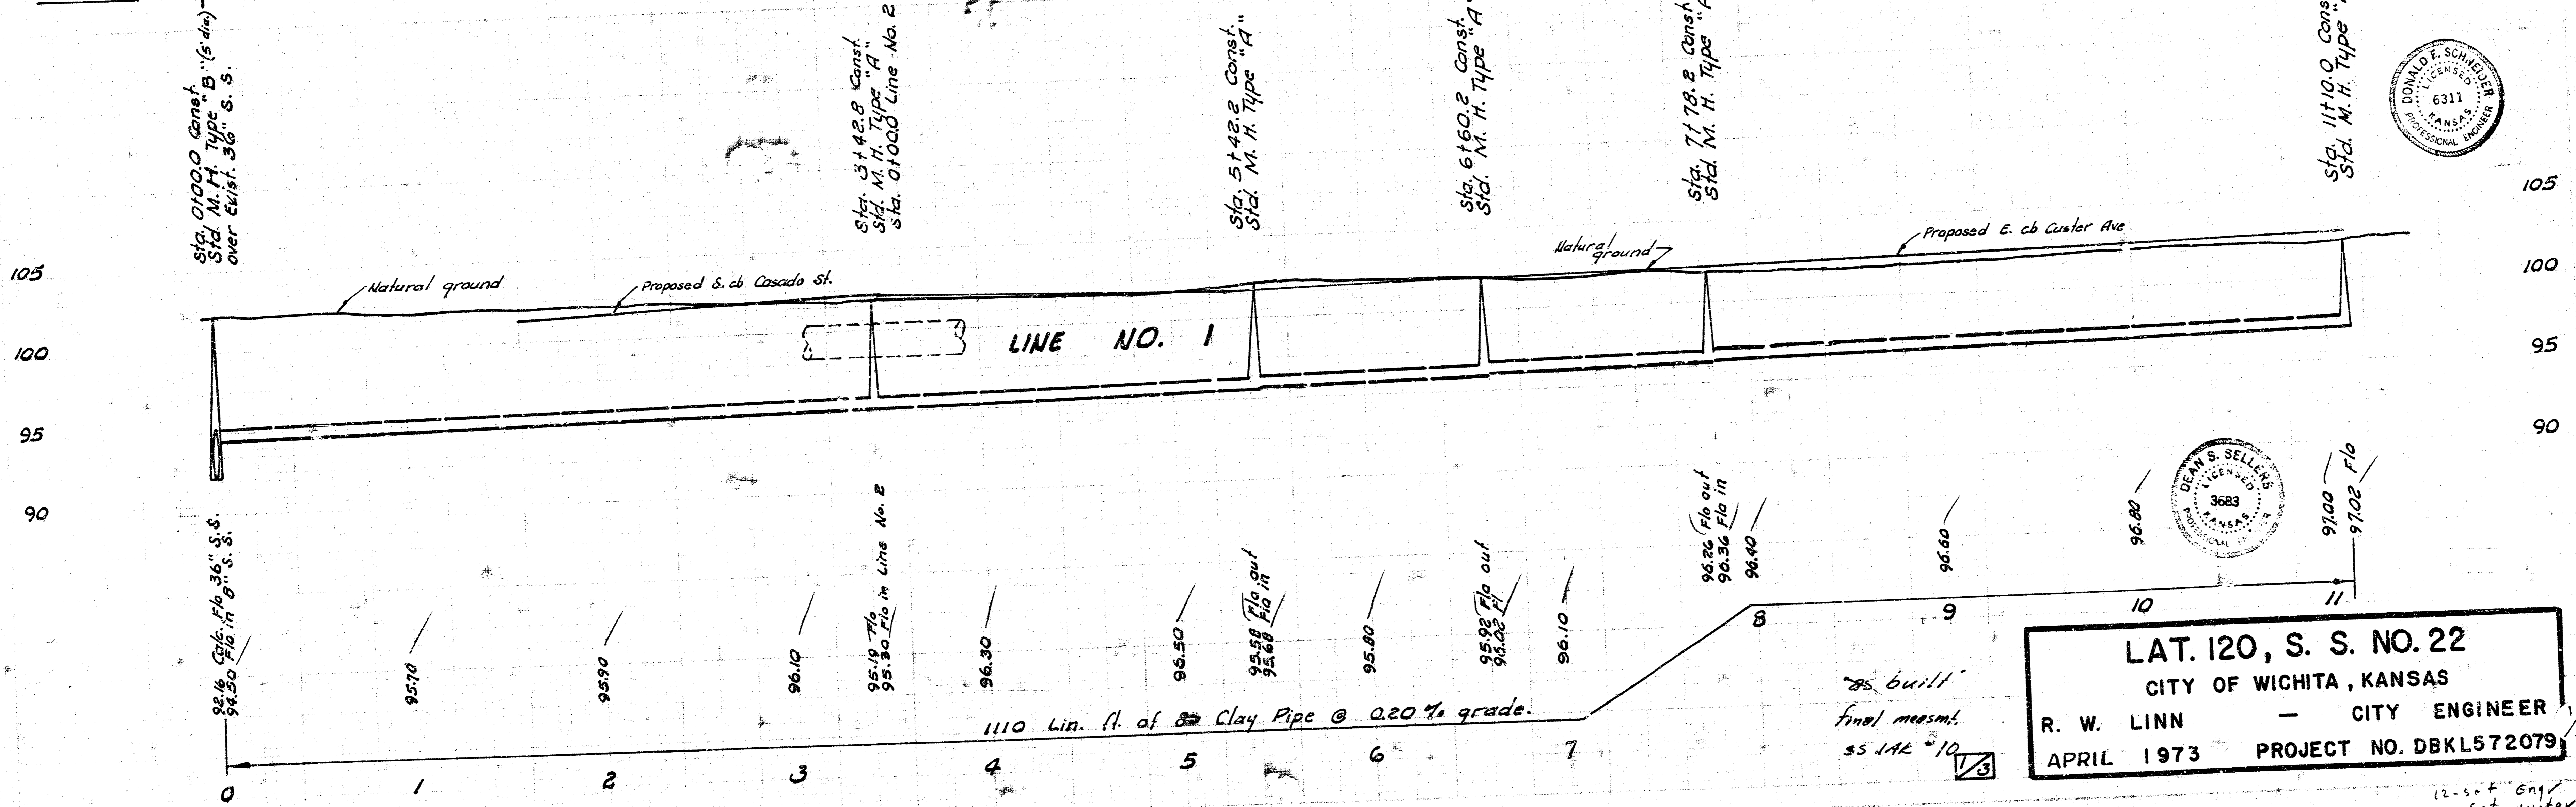


5/27/73  
AP-48

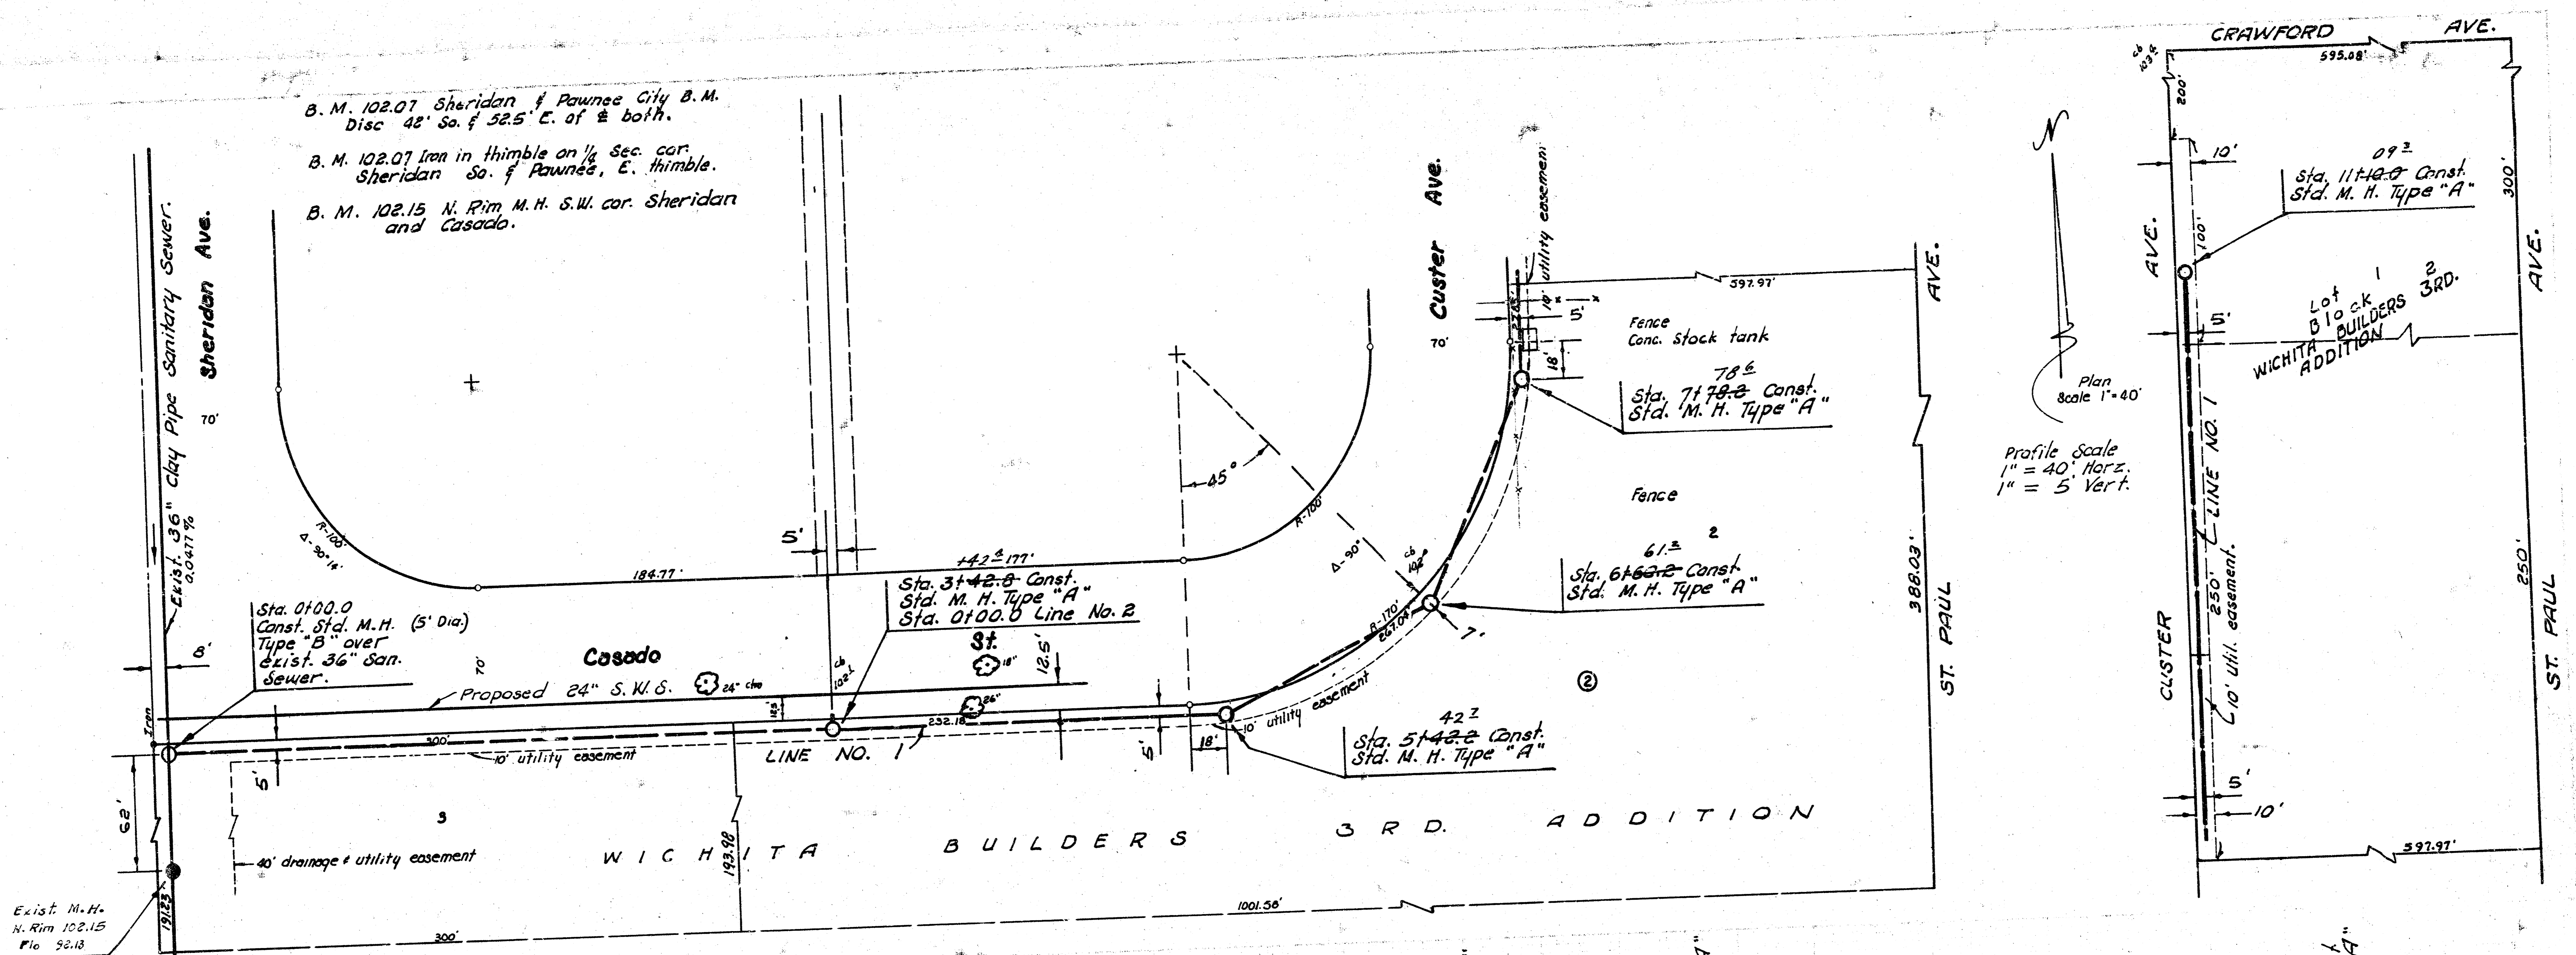

LAT. 120, S. S. NO. 22  
CITY OF WICHITA, KANSAS  
R. W. LINN - CITY ENGINEER  
APRIL 1973 PROJECT NO. DBKL572079

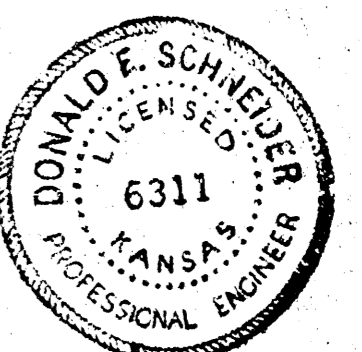

FILMED FROM THE BEST  
AVAILABLE COPY....