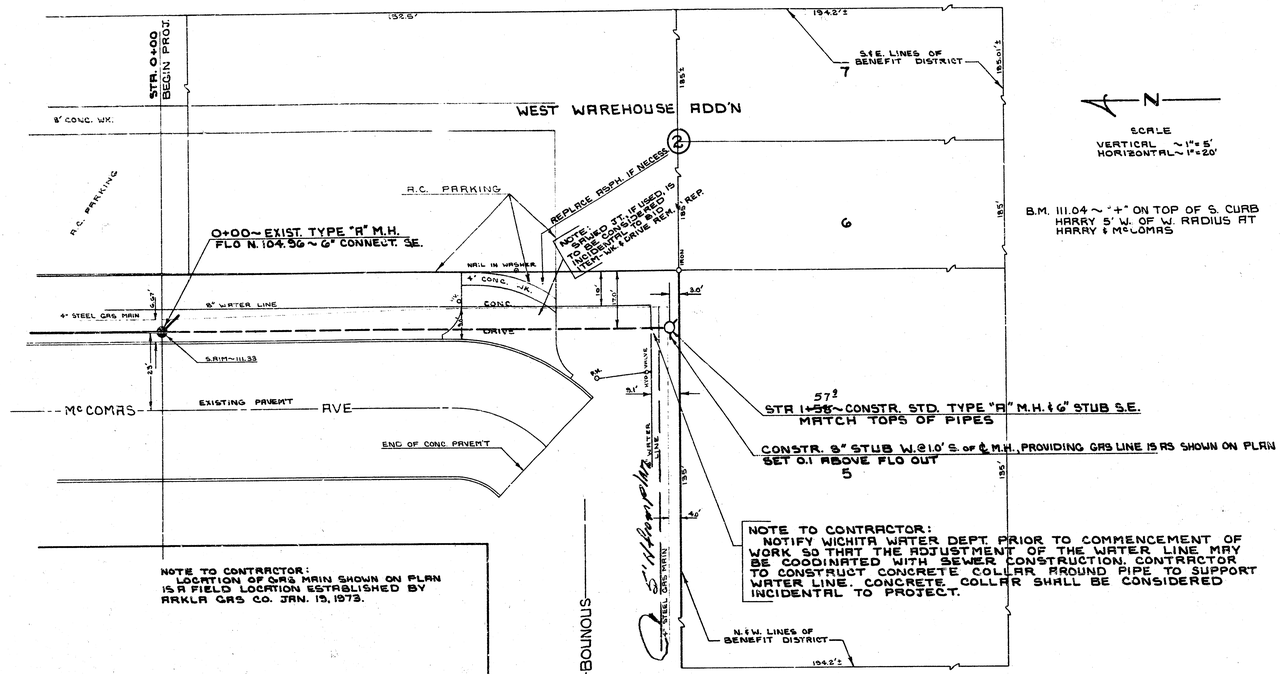


CAUTION
UNDERGROUND CABLES
Phone ... before you dig
Telephone Co. ...

LARRY W. LAURSEN LICENSED 6363 KANSAS PROFESSIONAL ENGINEER

DENIS SELLERS 3603 KANSAS PROFESSIONAL ENGINEER

"As Built" Final Measurements SS. J.K.#9

LAT 119 ~ S.S.# 22
CITY OF WICHITA
R.W. LINN ~ CITY ENGINEER
DATE JAN. 1973 PROJ. NO. D'3KL572076

10 - Engr
1 - water

14 4 4 1/1 (12)