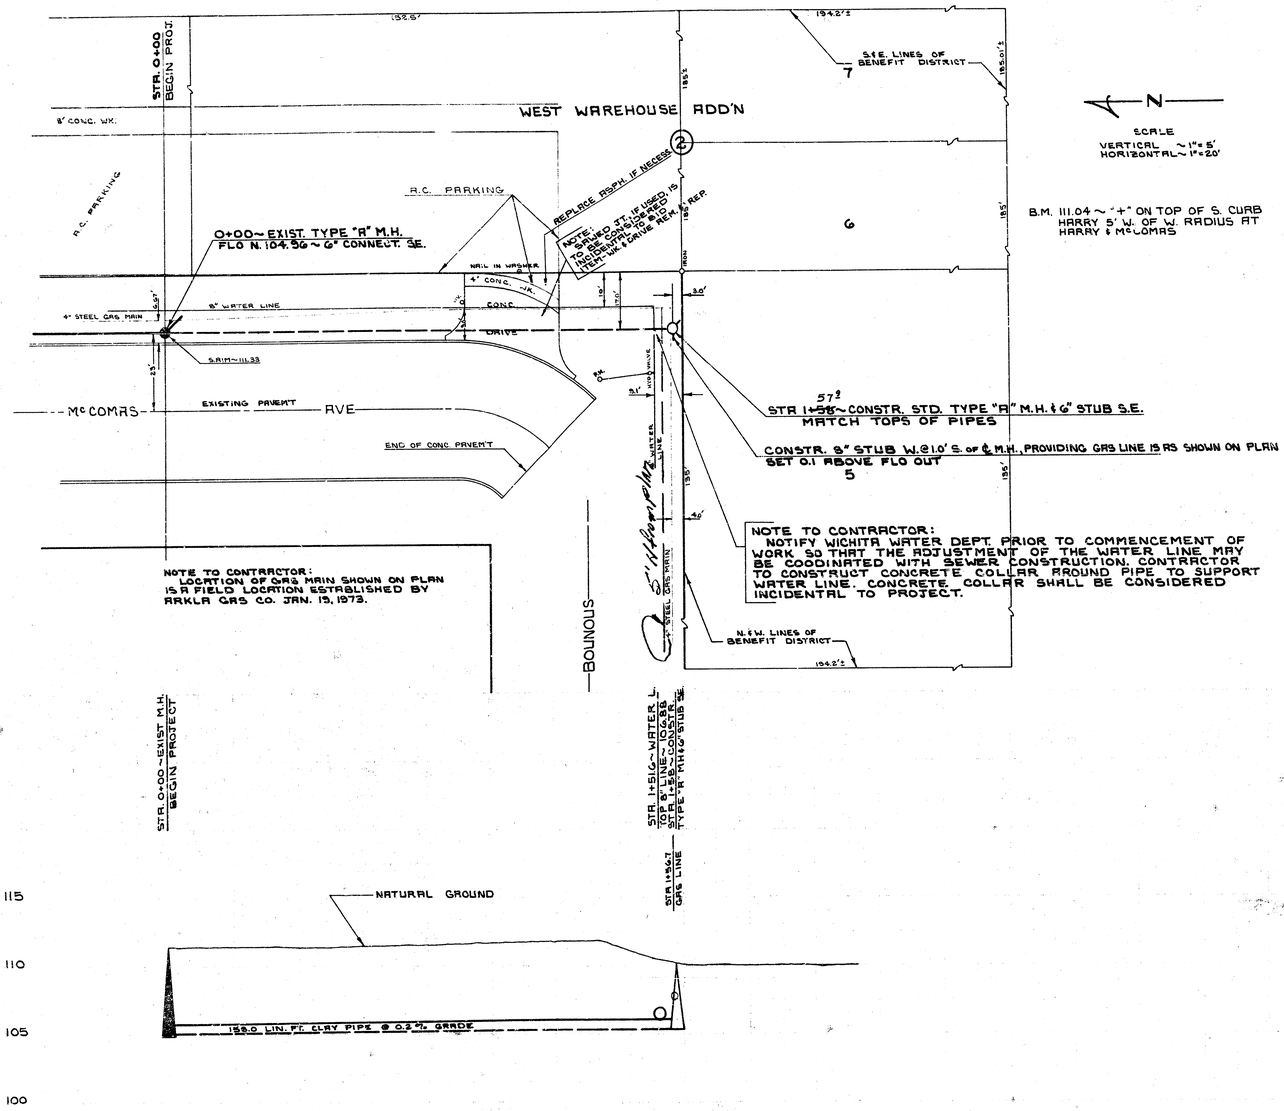

DLK-TATE

DLK-123

CAUTION
UNDERGROUND
CABLES

LARRY W. LAURSEN
LICENSED
6363
KANSAS
PROFESSIONAL ENGINEER

"As Built" Final Measurements SS. J.K. #9

LAT 119 ~ S.S.# 22

CITY OF WICHITA

R.W. LINN ~ CITY ENGINEER

DATE JAN. 1973 PROJ. NO. D'3KL572076

10 - Engr
1 - water

1/1

(12)