B. M. 102.07 Sheridan & Pawnee City B.M. Disc 42' So. & 32.5' E. of ℄ both.

B. M. 102.07 Iron in thimble on ½ Sec. cor. Sheridan So. & Pawnee, E. thimble.

B. M. 102.15 N. Rim M.H. S.W. cor. Sheridan and Casado.

Sheridan Ave.

Exist. 36" clay Pipe Sanitary Sewer.

Custer Ave.

Casado St.

Sta. 0+00.0 Const. Std. M.H. (5' Dia) Type "B" over Exist. 36" San. Sewer.

Proposed 24" S. W. S.

Sta. 3+42.8 Const. Std. M. H. Type "A" Sta. 0+00.0 Line No. 2

Sta. 5+42.2 Const. Std. M. H. Type "A"

Sta. 6+60.2 Const. Std. M. H. Type "A"

Sta. 7+78.2 Const. Std. M. H. Type "A"

Sta. 11+10.0 Const. Std. M. H. Type "A"

LINE NO. 1

10' utility easement

40' drainage & utility easement

WICHITA BUILDERS 3RD. ADDITION

ST. PAUL AVE.

CRAWFORD AVE.

Lot 9 Blk 1 WICHITA BUILDERS 3RD. ADDITION

Fence

Conc. Stock Tank

Plan Scale 1"=40'

Profile Scale 1" = 40' Horz. 1" = 5' Vert.

Sta. 01000 Const. Std. M.H. Type "B" (5' dia) over Exist. 36" S. S.

Sta. 3+42.8 Const. Std. M. H. Type "A" Sta. 01000 Line No. 2

Sta. 5+42.2 Const. Std. M. H. Type "A"

Sta. 6+60.2 Const. Std. M. H. Type "A"

Sta. 7+78.2 Const. Std. M. H. Type "A"

Sta. 11+10.0 Const. Std. M. H. Type "A"

Natural ground

Proposed S. cb Casado St.

Natural ground

Proposed E. cb Custer Ave.

LINE NO. 1

92.46 Cplt. Flo 36" S.S.
94.50 Flo in 8" S.S.

95.10

95.90

96.10

95.19 Flo
95.39 Flo in Line No. 2

96.30

96.50

95.59 Flo out
95.69 Flo in

95.80

95.98 Flo out
96.08 Flo in

96.10

96.26 Flo out
96.36 Flo in

96.40

96.60

96.80

97.00 - 97.02 Flo

1110 Lin. ft. of 8" Clay Pipe @ 0.20% grade.

0 1 2 3 4 5 6 7 8 9 10 11

105 100 95 90

"As built" final measmt. 33 JAL "10

V/3

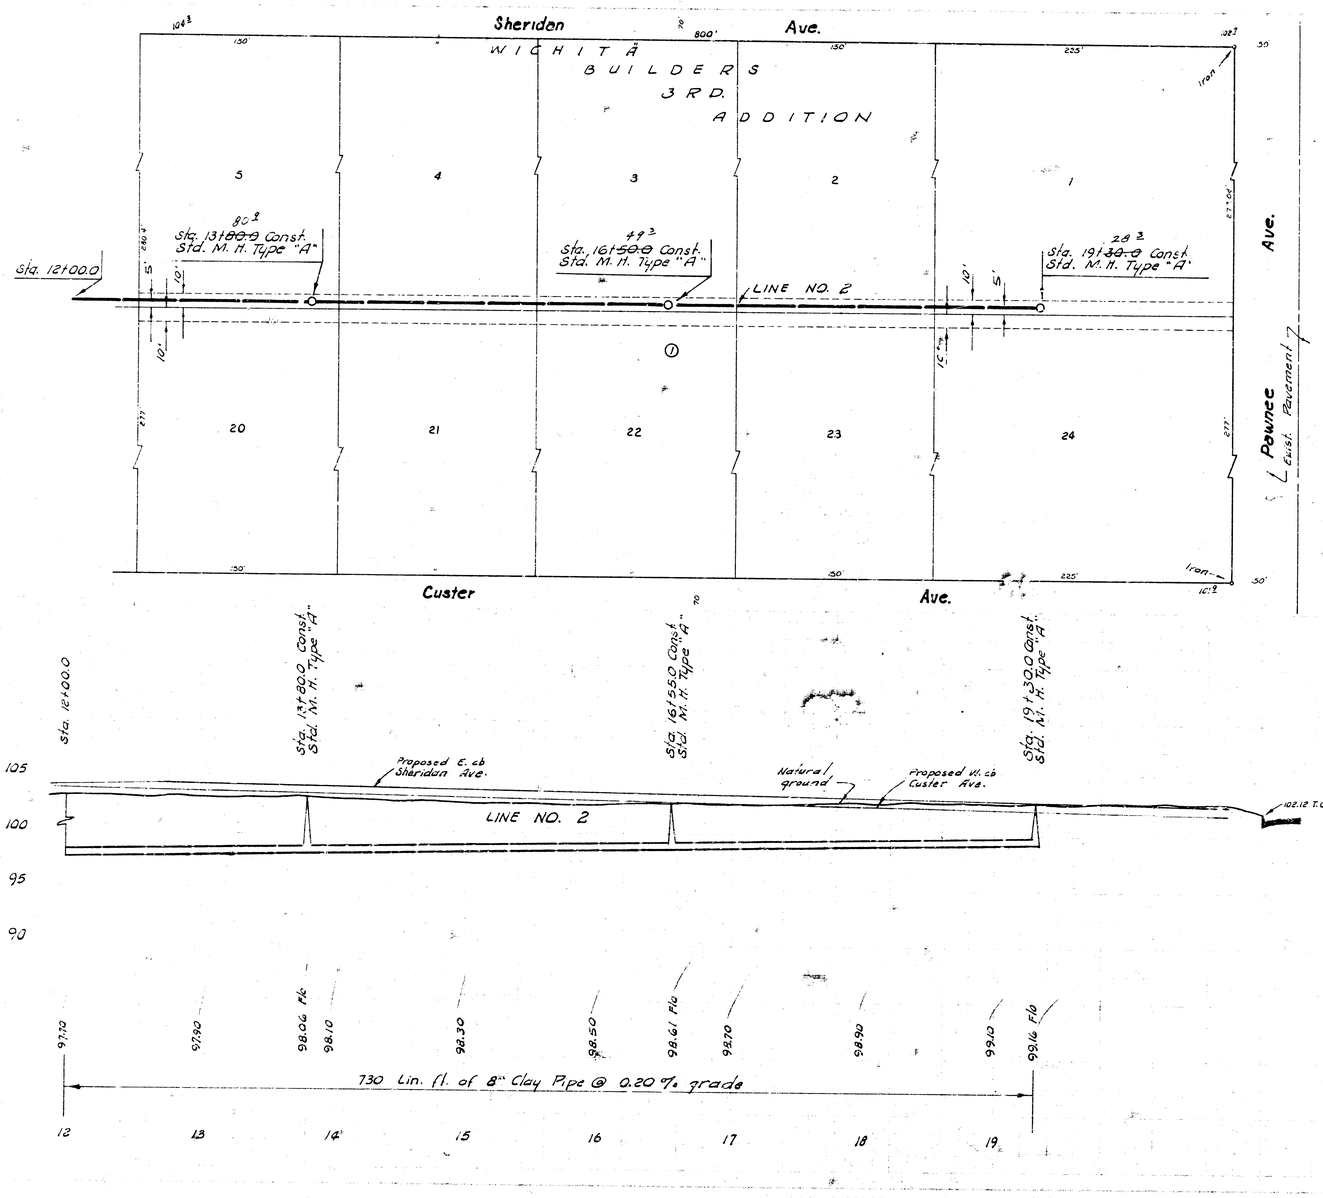
LAT. 120, S. S. NO. 22

CITY OF WICHITA, KANSAS

R. W. LINN — CITY ENGINEER

APRIL 1973 PROJECT NO. DBKL572079


Sheridan Ave.
WICHITA BUILDERS 3RD. ADDITION
Scale 1"=50'
Casado St.
Custer Ave.
Sta. 0100.0 Line No. 2 = Sta. 3142.8 Line No. 1
Proposed 24" S.W.S.
10' utility easement
LINE NO. 2
Sta. 2175.0 Const. Std. M.H. Type "A"
75 ft
Sta. 5150.0 Const. Std. M.H. Type "A"
48 ft
Sta. 8130.0 Const. Std. M.H. Type "A"
29 ft
Sta. 11100.0 Const. Std. M.H. Type "A"
00 ft
Sta. 12100.0
Sta. 0117.5 Proposed 24" S.W.S.
Natural ground
Proposed W. cb Custer Ave.
Proposed E. cb Sheridan Ave.
1200 Lin. ft. of 8" Clay Pipe @ 0.20% grade.
LAT. 120, S. S. NO. 22
PROJECT NO. DBKL572079


Sheridan Ave.
WICHITA BUILDERS 3RD. ADDITION
800'
5
4
3
2
1
20
21
22
23
24
Sta. 12+00.0
8C 2
Std. M. H. Type "A"
LINE NO. 2
Custer Ave.
Exist. Pavement
Sta. 12+00.0
Proposed E. cb Sheridan Ave.
Natural ground
Proposed W. cb Custer Ave.
102.12 T.C.
LINE NO. 2
105
100
95
90
97.70
97.90
98.06 F/C
98.10
98.30
98.50
98.61 F/C
98.70
98.90
99.16 F/C
730 Lin. fl. of 8" Clay Pipe @ 0.20% grade
12
13
14
15
16
17
18
19
Scale 1" = 40
N
LAT. 120 , S. S. NO. 22
PROJECT NO. DBKL572079