
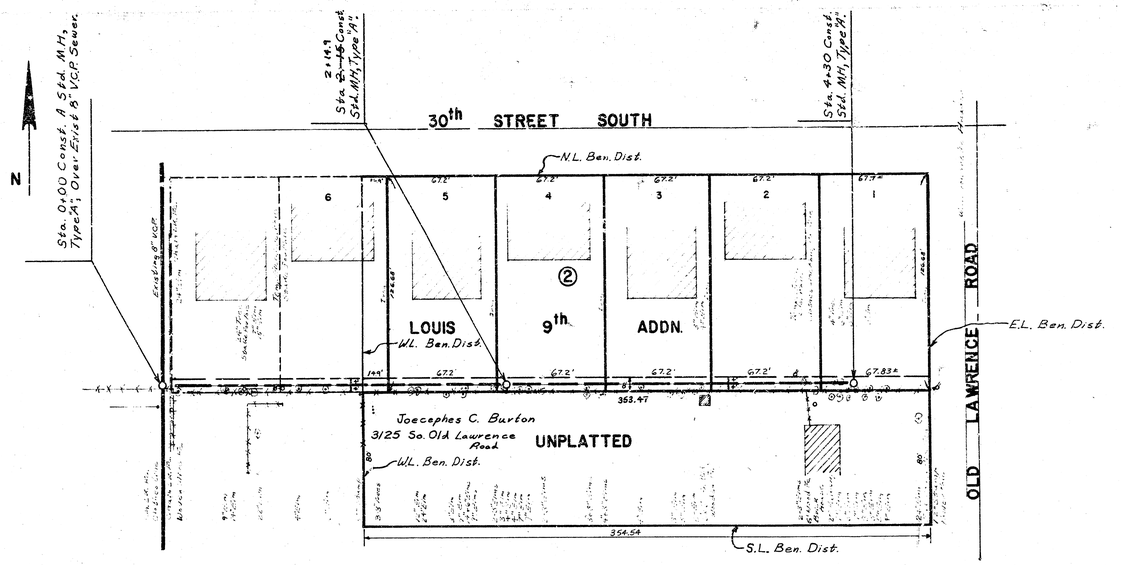


BM #1 96.70 S.W. Cor. 1st Concrete Step, 210 W. 30th Street South.

Plan Scale: 1" = 40'
Profile Scale: Horizontal 1" = 40'
Vertical 1" = 5'

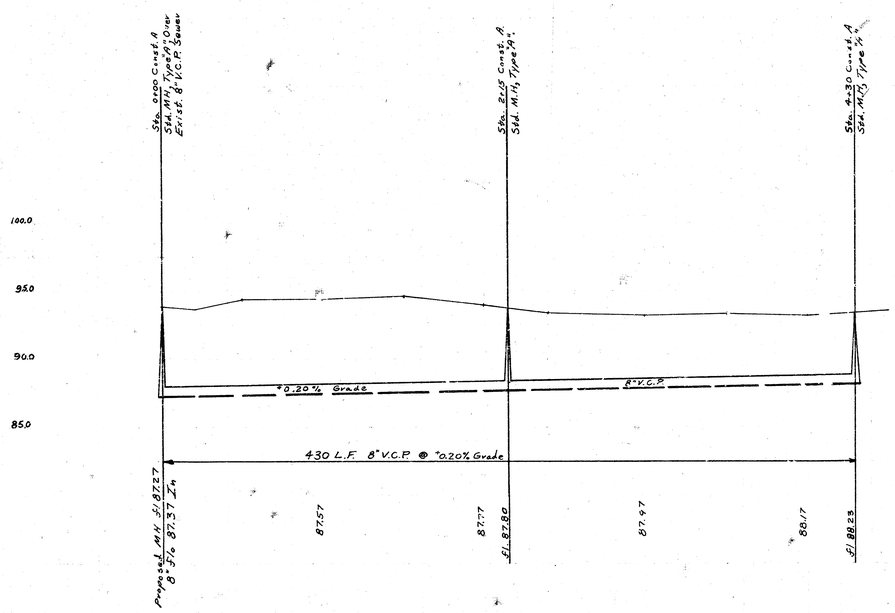

"As Built" Final Measmt. SS Jk #9

LAT. 122 S.S. NO. 22
CITY OF WICHITA, KANSAS
R.W. LINN CITY ENGINEER
DATE: JULY 1973
SHEET: 1 OF 1
PROJECT NO. DBKL 573031

DEAN S. SELLERS LICENSED 3683 KANSAS PROFESSIONAL ENGINEER

1/1

14 2 5 18 Engr Water