
B. M. 115.54 "M" in Mueller F. P.
S.E. West & McCormick

B. M. 113.25 S.W. cor. wk S.E.
Kessler & McCormick.

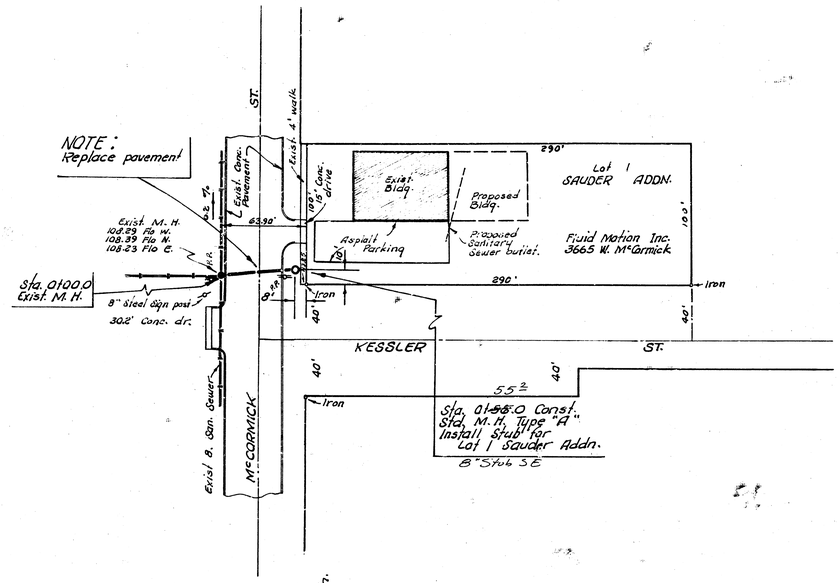

N

Plan Scale 1" = 40'
Profile Scale 1" = 40' Hor. E.
1" = 5' Vert.

DONALD E. SCHNEIDER
LICENSED
6311
KANSAS
PROFESSIONAL ENGINEER

"As Built" Final Mylars SS Jk #6

LAT. 125, S. S. NO. 22 1/1
CITY OF WICHITA, KANSAS
R. W. LINN — CITY ENGINEER
MAR. 1974 PROJECT NO. DBKL574004

14 e 3 10 1-Engr 1-Water