

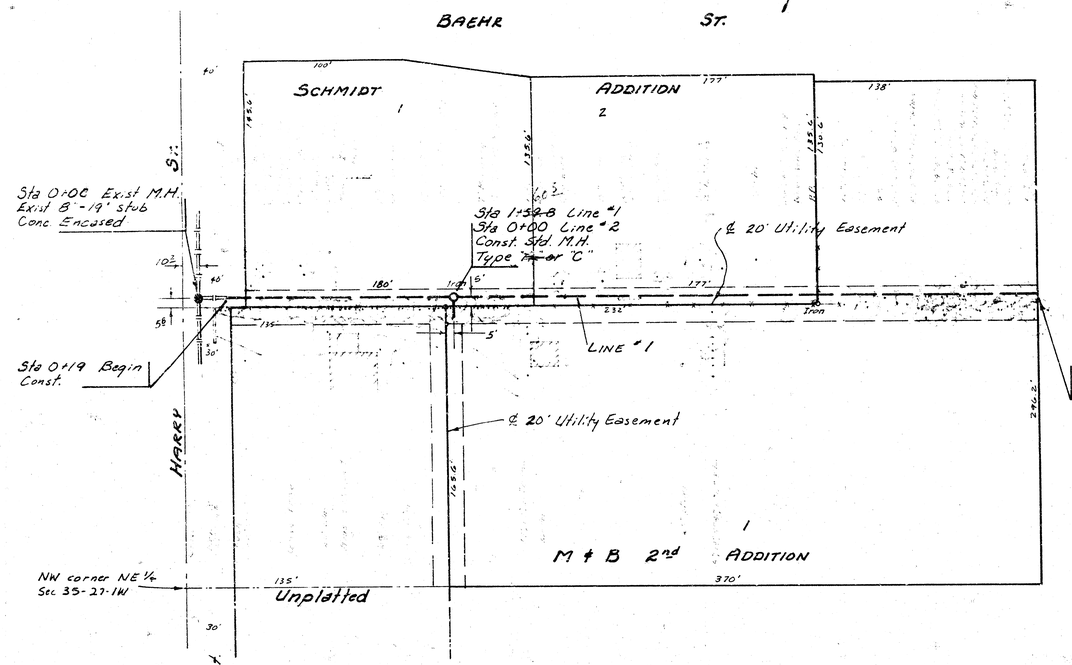


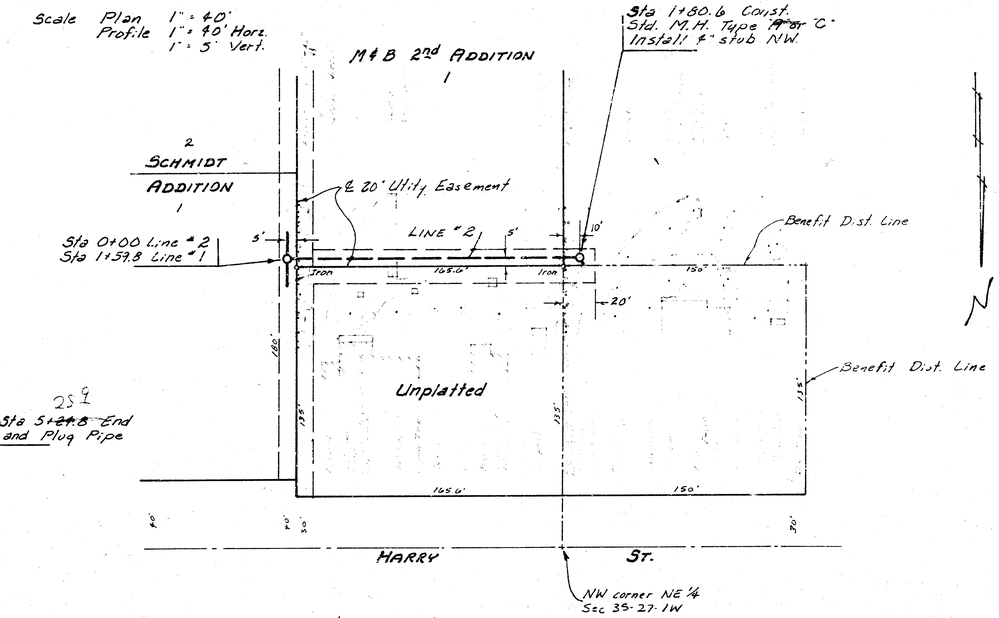

B.M. 111.42 City Std. 52' E & 24' N of ℄'s West St. & Harry.

B.M. 114.06 R.R. Spike N-face P.P. S-Side Harry, S. of 1/4 Sec. Iron at Anna.

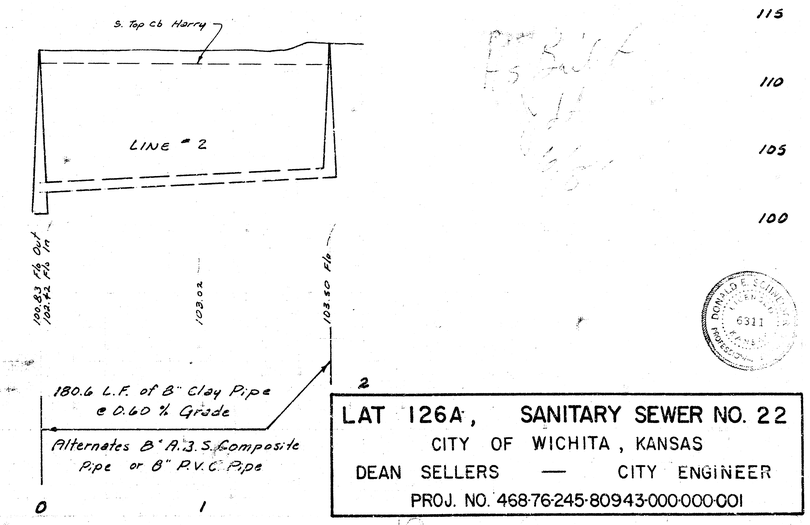

LAT 126A, SANITARY SEWER NO. 22
CITY OF WICHITA, KANSAS
DEAN SELLERS — CITY ENGINEER
PROJ. NO. 468-76-245-80943-000-000-001