

B.M. 103.52 City B.M. Disc Top East End South Handrail R.C.B.C. Sheridan & 31st

B.M. 99.93 City Std Disc. 6' N. & 2' E. of S.E. R/W Corner of Sheridan & 31st

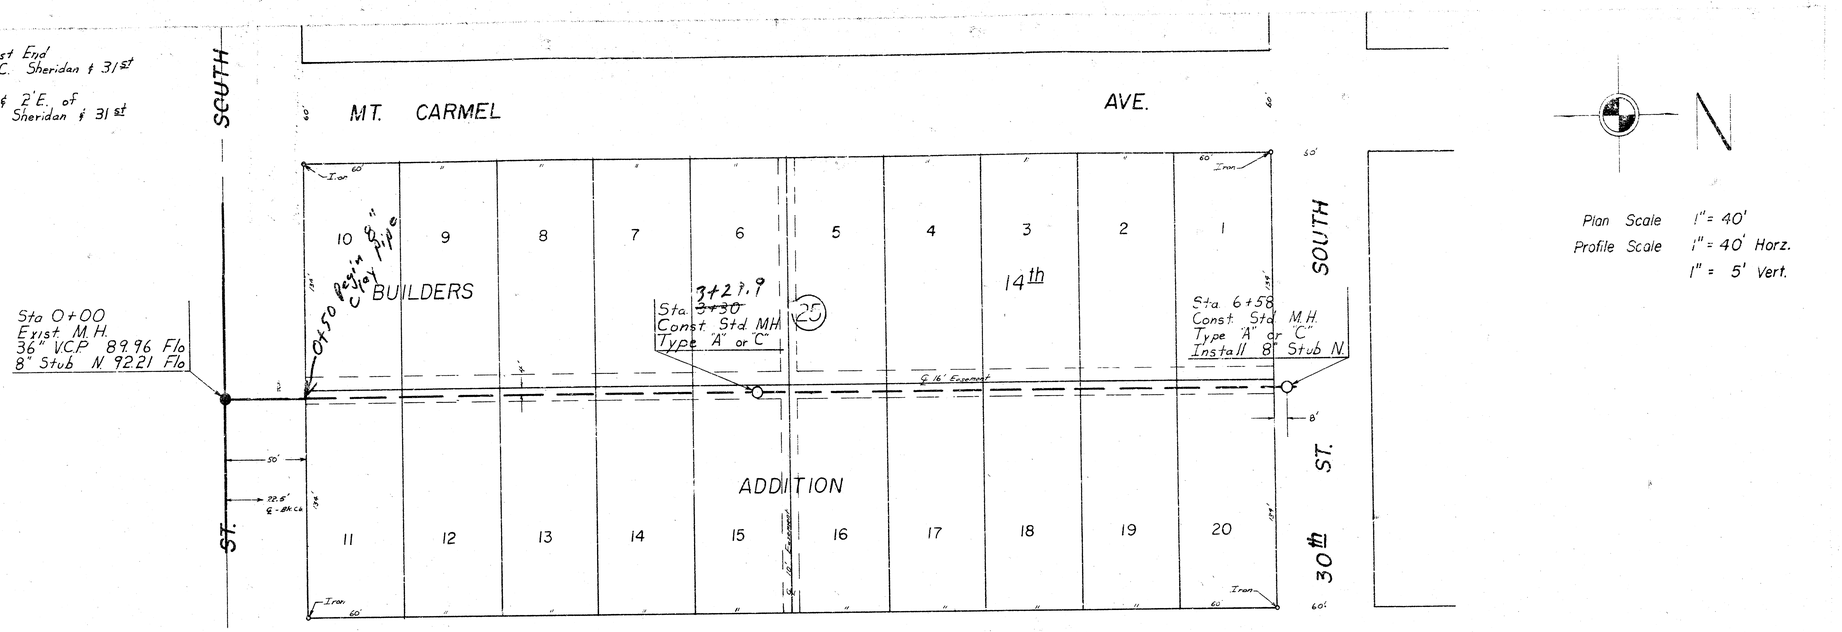

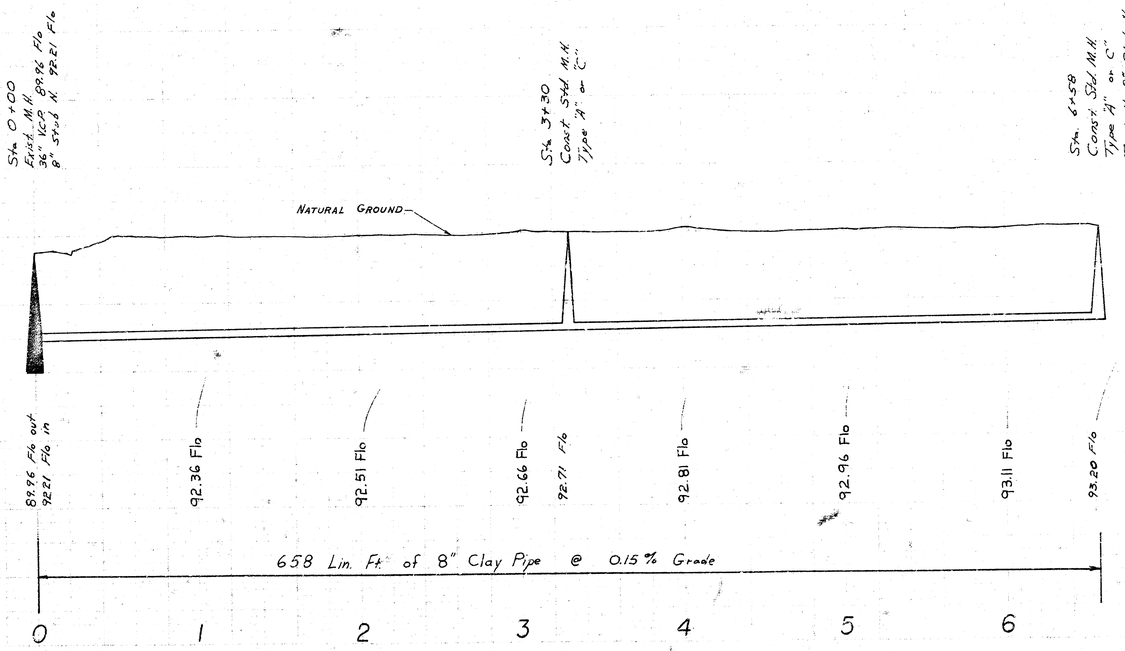

Plan Scale 1" = 40'
Profile Scale 1" = 40' Horz.
1" = 5' Vert.

DONALD E. SCHNEIDER LICENSED 6311 KANSAS PROFESSIONAL ENGINEER

As built 8-29-75

LAT. 131 S.S. NO. 22
CITY OF WICHITA, KANSAS
R. W. LINN — CITY ENGINEER
PROJECT NO. DBKL575031

14 8 5 5 1