



B.M. 99.93 City Std. Disc 6" N & 2' E. of  
SE. RW. Corner of Sheridan & 31st St. S.

B.M. 103.52 City B.M. Dis. Top East End  
South Hendrail RCBC Sheridan & 31st

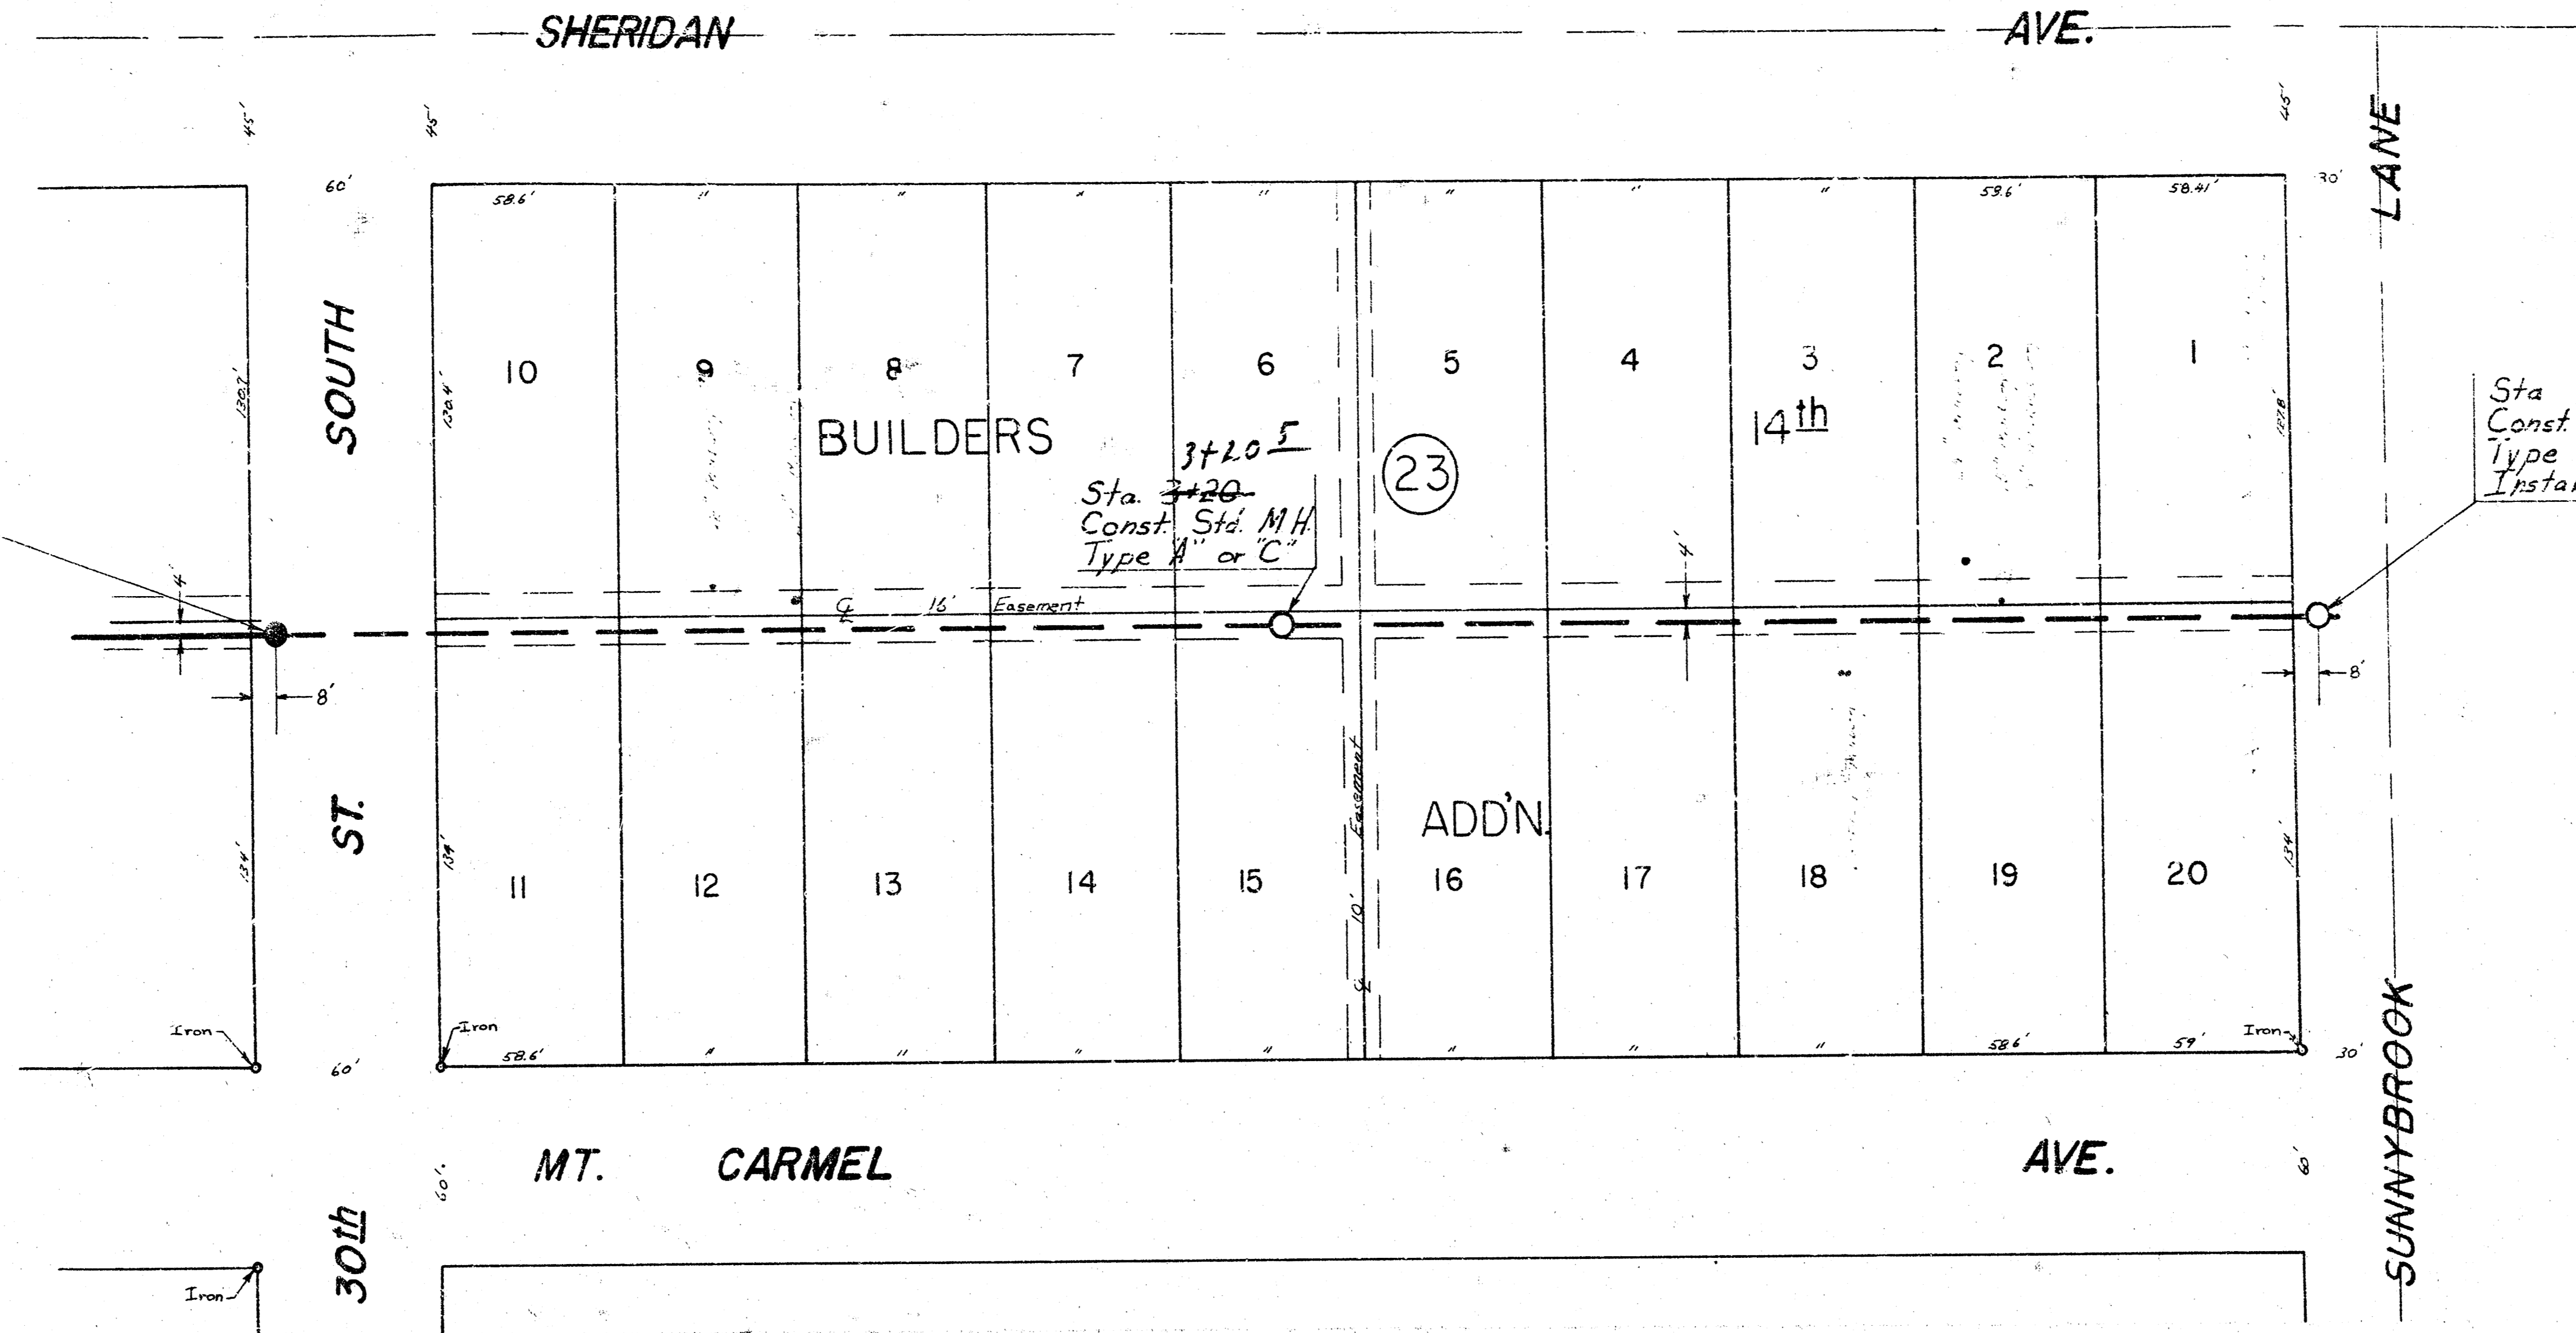

Plan Scale 1" = 40'  
Profile Scale 1" = 40' Horiz.  
1" = 5' Vert.

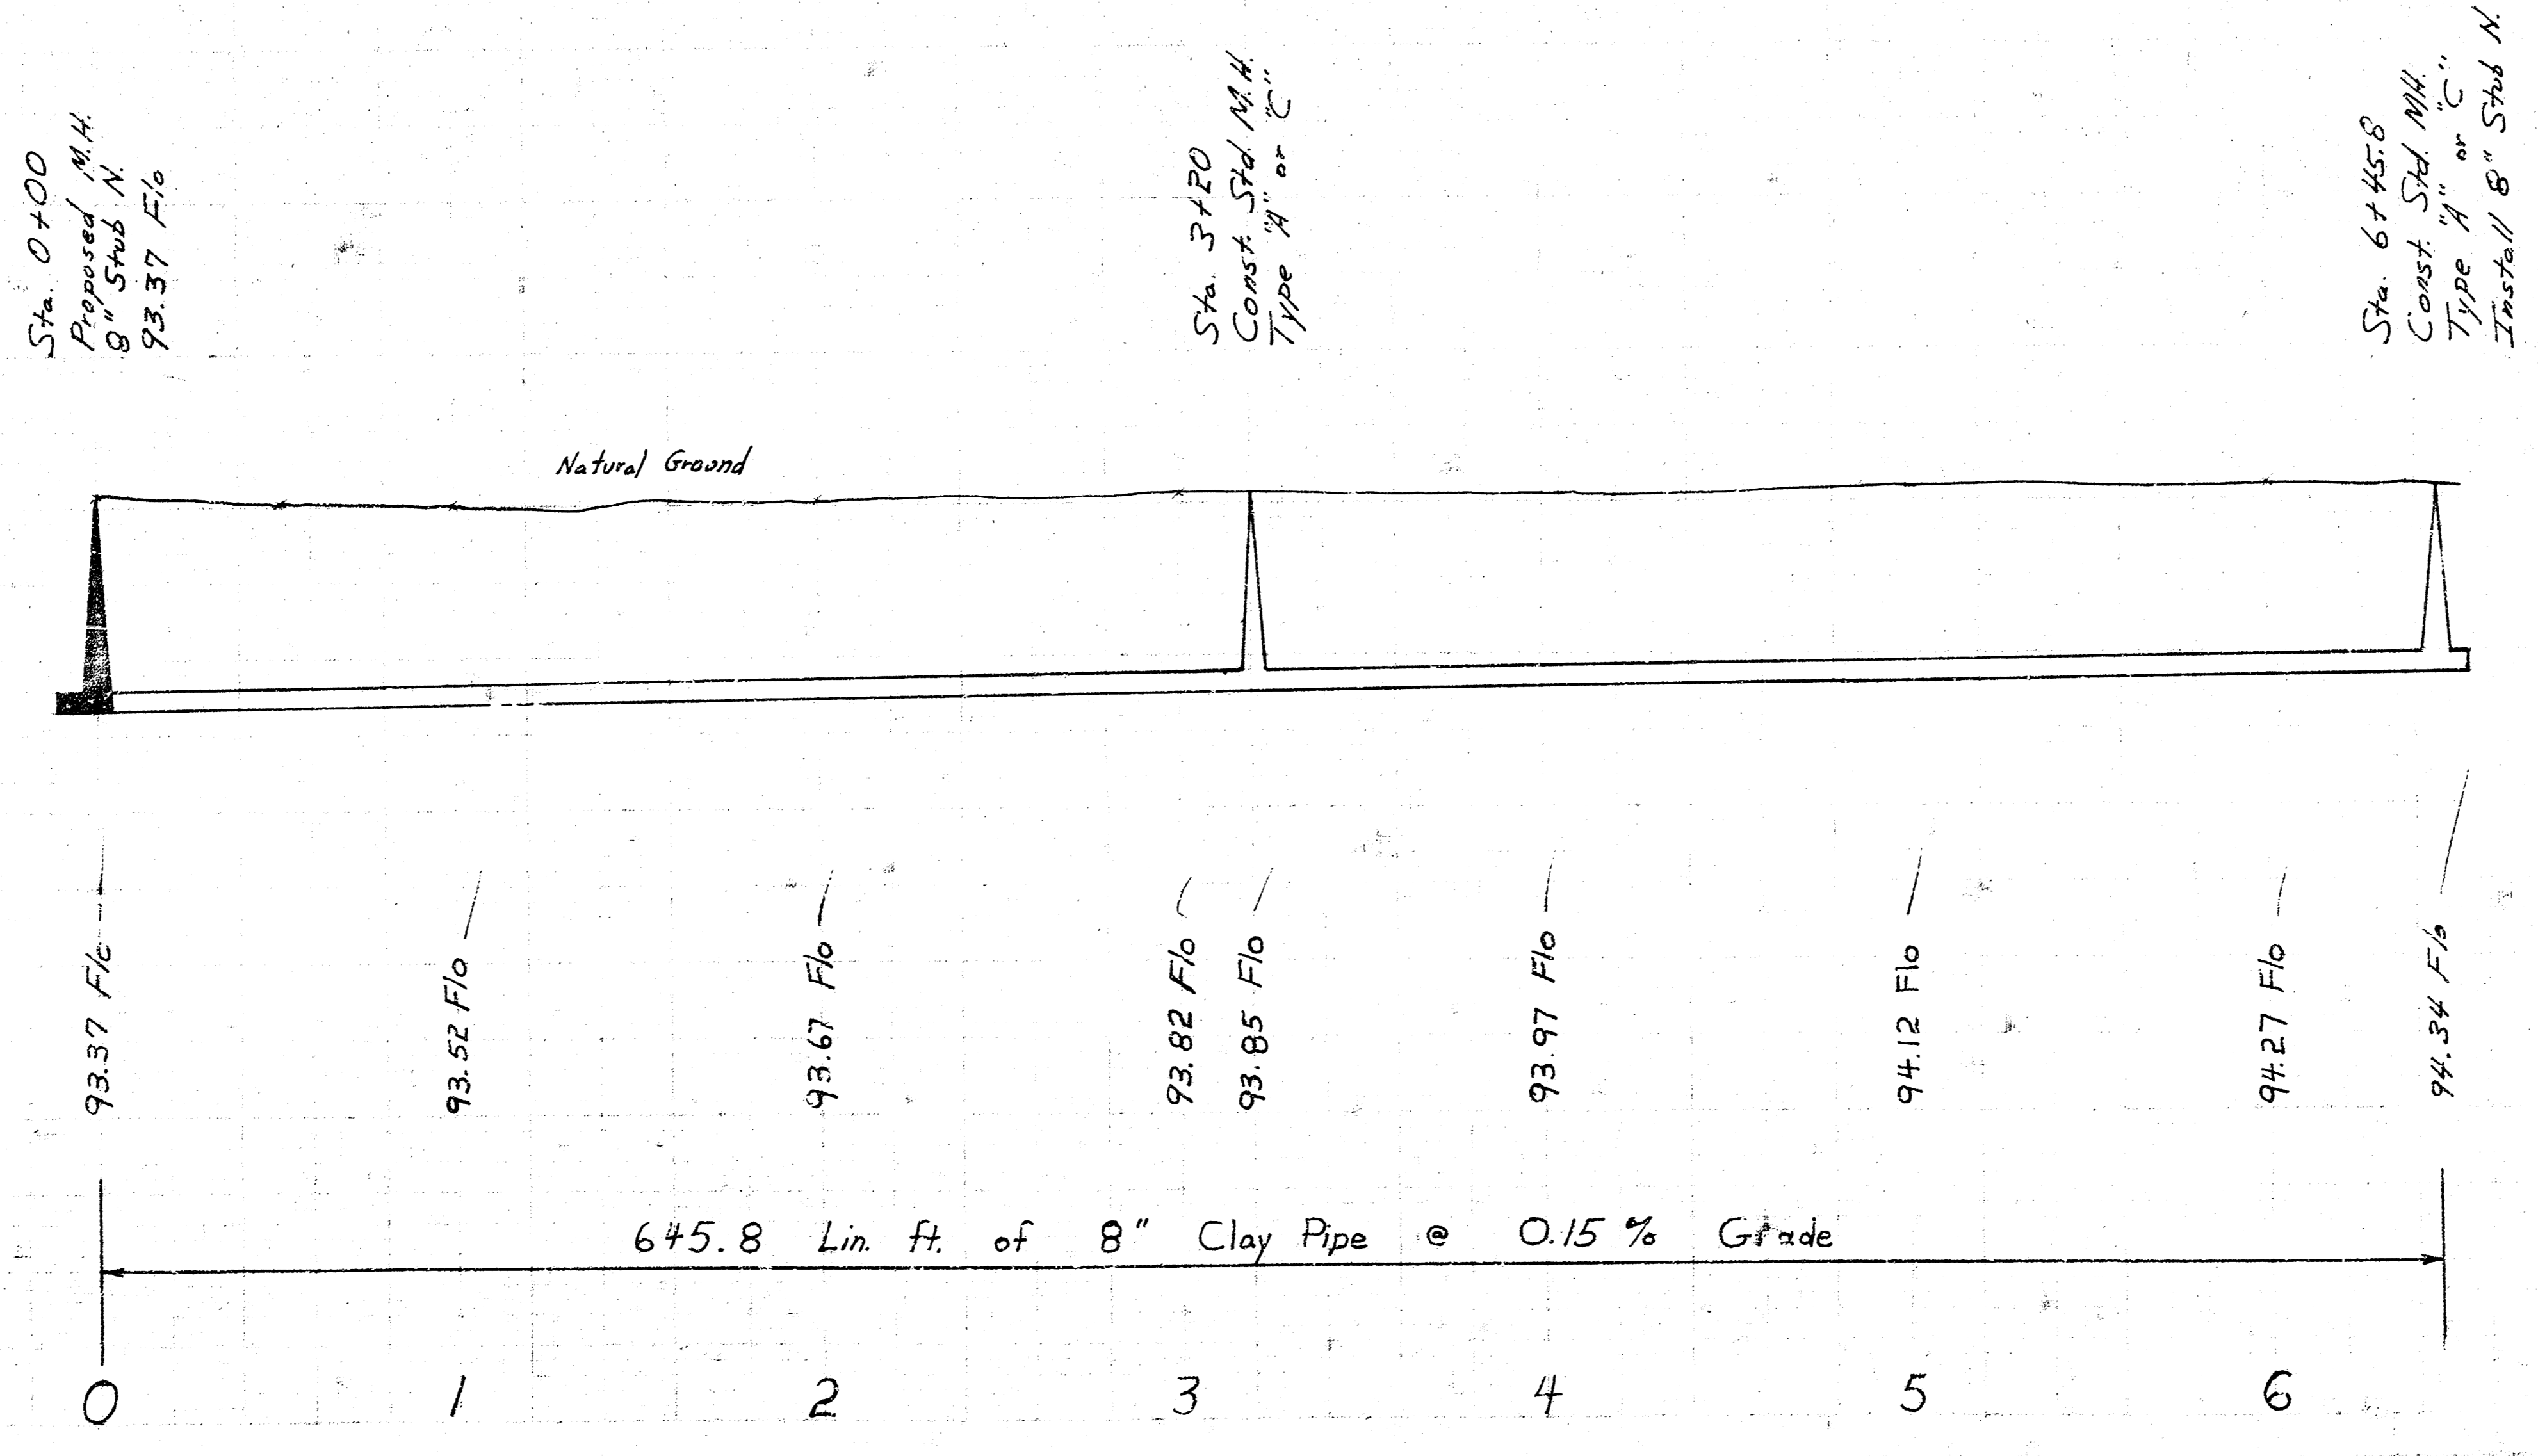

LAT. 133 S.S. NO. 22  
CITY OF WICHITA, KANSAS  
R. W. LINN CITY ENGINEER  
PROJECT NO. DBKL 575033

14 8 5 2 1/4