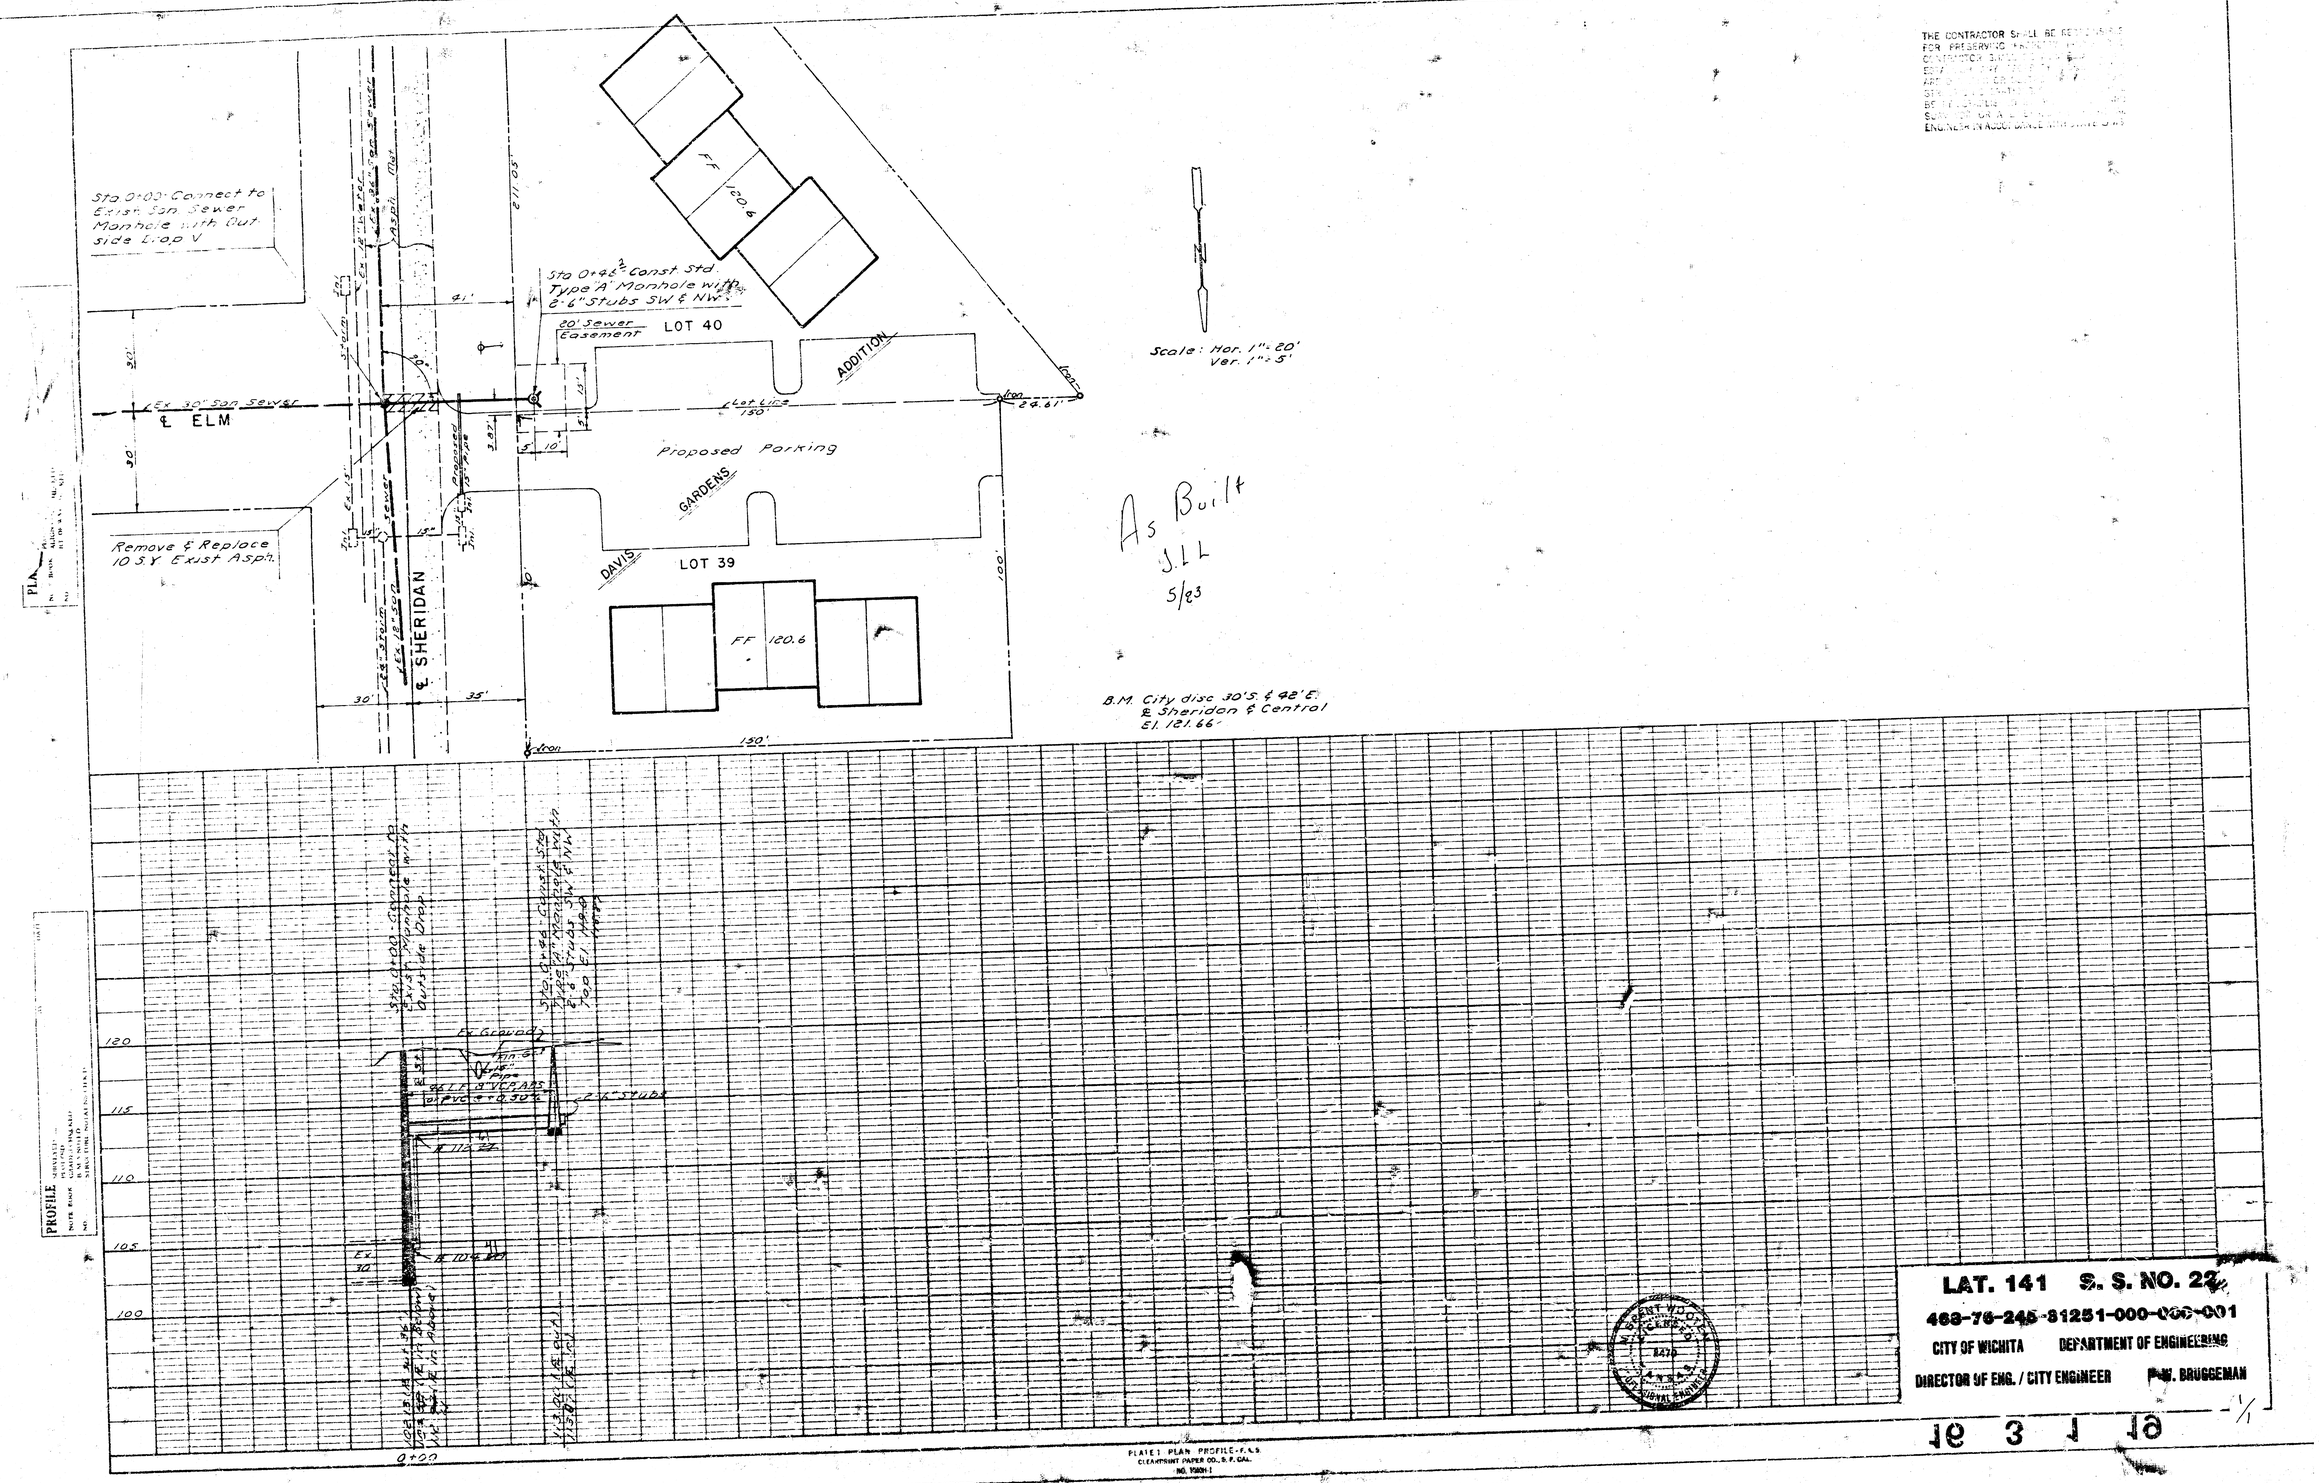

THE CONTRACTOR SHALL BE RESPONSIBLE FOR PRESERVING PROPERTY ... CONTRACTOR SHALL ... ENGINEER IN ACCORDANCE WITH STATE LAWS

LAT. 141 S. S. NO. 22

468-76-245-81251-000-000-001

CITY OF WICHITA DEPARTMENT OF ENGINEERING

DIRECTOR OF ENG. / CITY ENGINEER P. W. BRUGGEMAN

PLATE 1 PLAN PROFILE - F.L.S.
CLEARPRINT PAPER CO., S. F. CAL.
NO. 1000-1