SURVEY C. MILES NOVEMBER CHM 91
PLAN D. SELLERS
CHECKED
DATE APRIL 1955

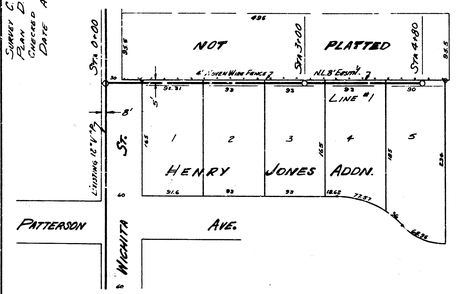

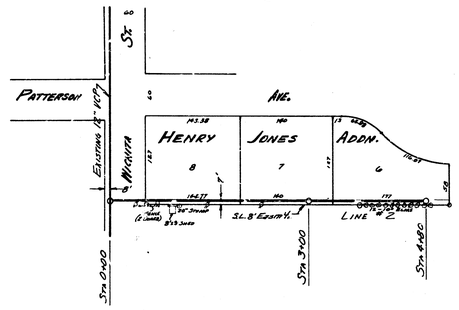

B. M. 95.84 NE Cor. Pat. # 3353 3 Waco
B. M. 97.01 Double Spike N5 Tel. Pole, W5 Wichita, 30' N of SL Henry Jones Addn.

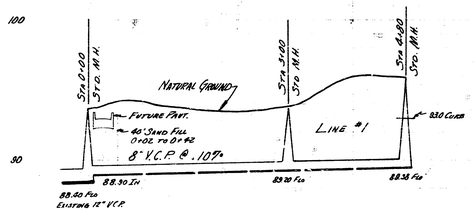

PLAN SCALE 1" = 80'
PROFILE SCALE 1" = 80' HORIZONTAL 1" = 4' VERTICAL

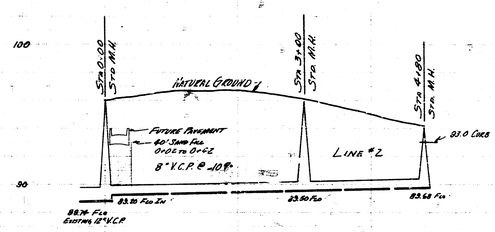

480 Lin. Ft. 8" V.C.P. @ .100% Grade

0 1 2 3 4 5

480 Lin. Ft. 8" V.C.P. @ .10% Grade

0 1 2 3 4 5

LATERAL 10 SANITARY SEWER 22
CITY OF WICHITA, KANSAS
B. E. SMITH CITY ENGINEER
APRIL, 1955 PROJ. NO. C25-11