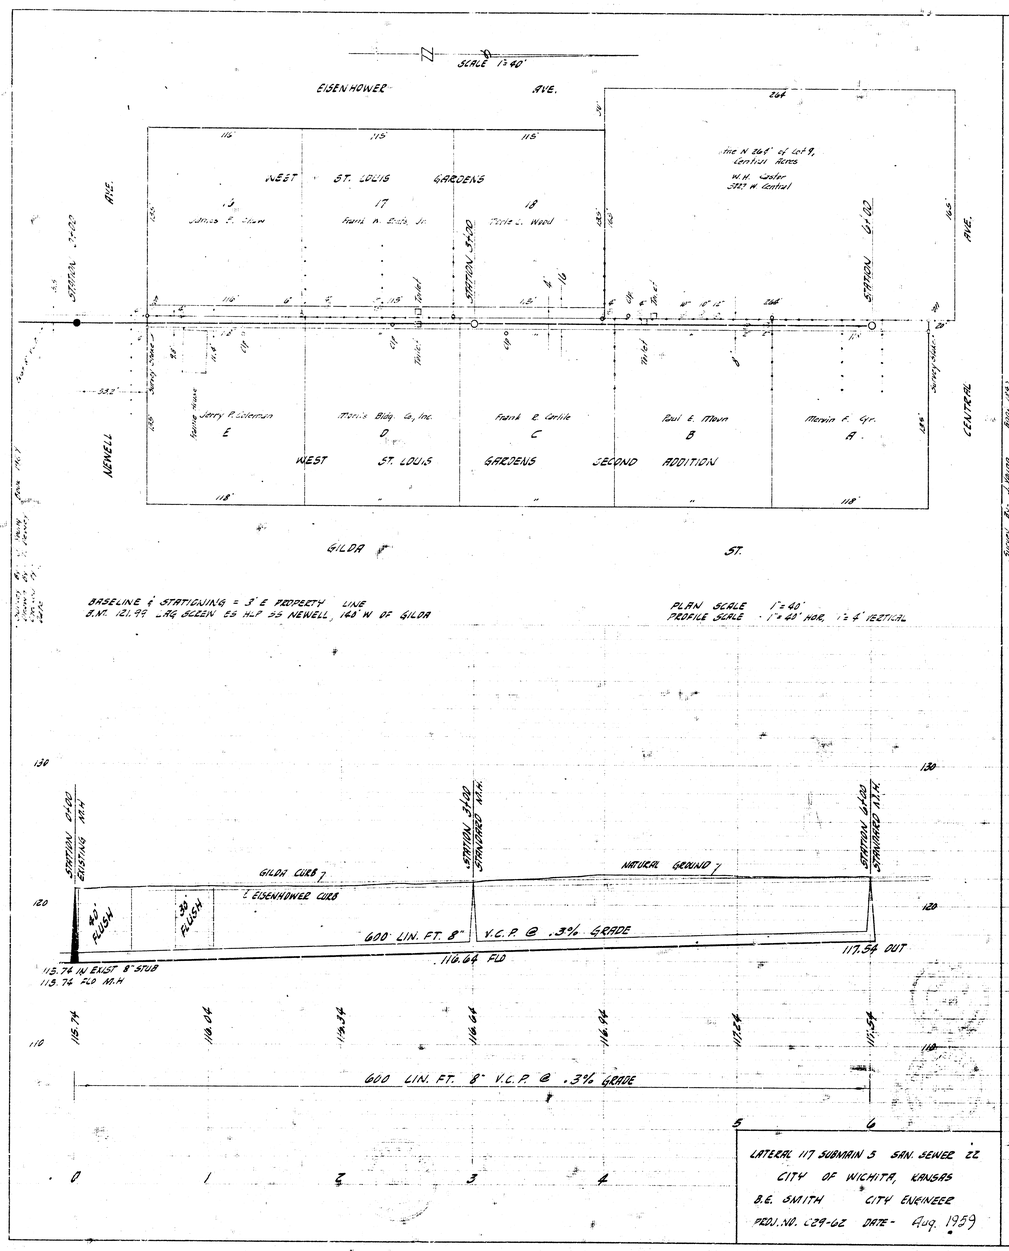
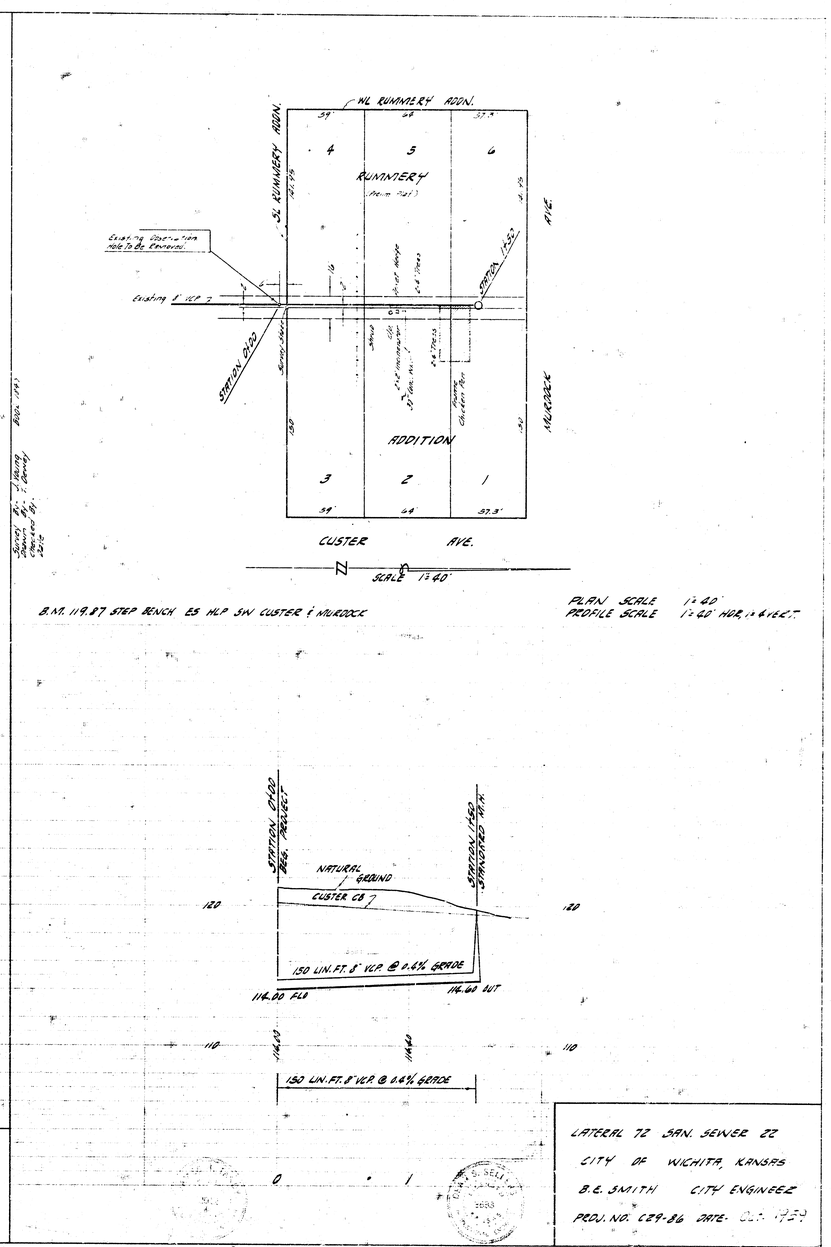

SCALE 1"=40'
EISENHOWER AVE.
WEST ST. LOUIS GARDENS
17
James E. Shaw
18
Willie L. Ward
The N. 264' of Lot 9, Central Acres
W.H. Sailer
3113 W. Central
NEWELL AVE.
CENTRAL AVE.
Harry P. Coleman
E
Morris Bldg. Co., Inc.
D
Frank E. Carlile
C
Paul E. Mann
B
Marvin A. Gr.
A
WEST ST. LOUIS GARDENS SECOND ADDITION
GILDA ST.
BASELINE & STATIONING = 3' E PROPERTY LINE
B.M. 121.99 AG SCREW ES H.P 35 NEWELL, 168' N OF GILDA
PLAN SCALE 1"=40'
PROFILE SCALE 1"=40' HOR, 1"=4' VERTICAL
40' FLUSH
38' FLUSH
GILDA CURB
EISENHOWER CURB
NATURAL GROUND
600' LIN. FT. 8" V.C.P. @ .3% GRADE
116.64 FLD
117.54 OUT
113.74 IN EXIST 8" STUB
113.74 FLD M.H
115.74
116.94
117.54
600 LIN. FT. 8" V.C.P. @ .3% GRADE
LATERAL 117 SUBMAIN 3 SAN. SEWER 22
CITY OF WICHITA, KANSAS
B.E. SMITH CITY ENGINEER
PROJ. NO. 629-62 DATE- Aug. 1959


W. RUNNERY ADDN.
S. RUNNERY ADDN.
4
3
6
RUNNERY
(Plat on file)
ADDITION
3
2
1
CUSTER AVE.
MURDOCK AVE.
Existing 8" VCP
SCALE 1"=40'
B.M. 119.97 STEP BENCH ES HLP SW CUSTER & MURDOCK
PLAN SCALE 1"=40'
PROFILE SCALE 1"=40' HOR, 1"=4' VERT.
NATURAL GROUND
CUSTER CB
150 LIN. FT. 8" V.C.P. @ 0.6% GRADE
114.00 FLD
116.00 OUT
114.90
114.40
150 LIN. FT. 8" V.C.P. @ 0.6% GRADE
LATERAL 72 SAN. SEWER 22
CITY OF WICHITA, KANSAS
B.E. SMITH CITY ENGINEER
PROJ. NO. 629-86 DATE- Oct. 1959