

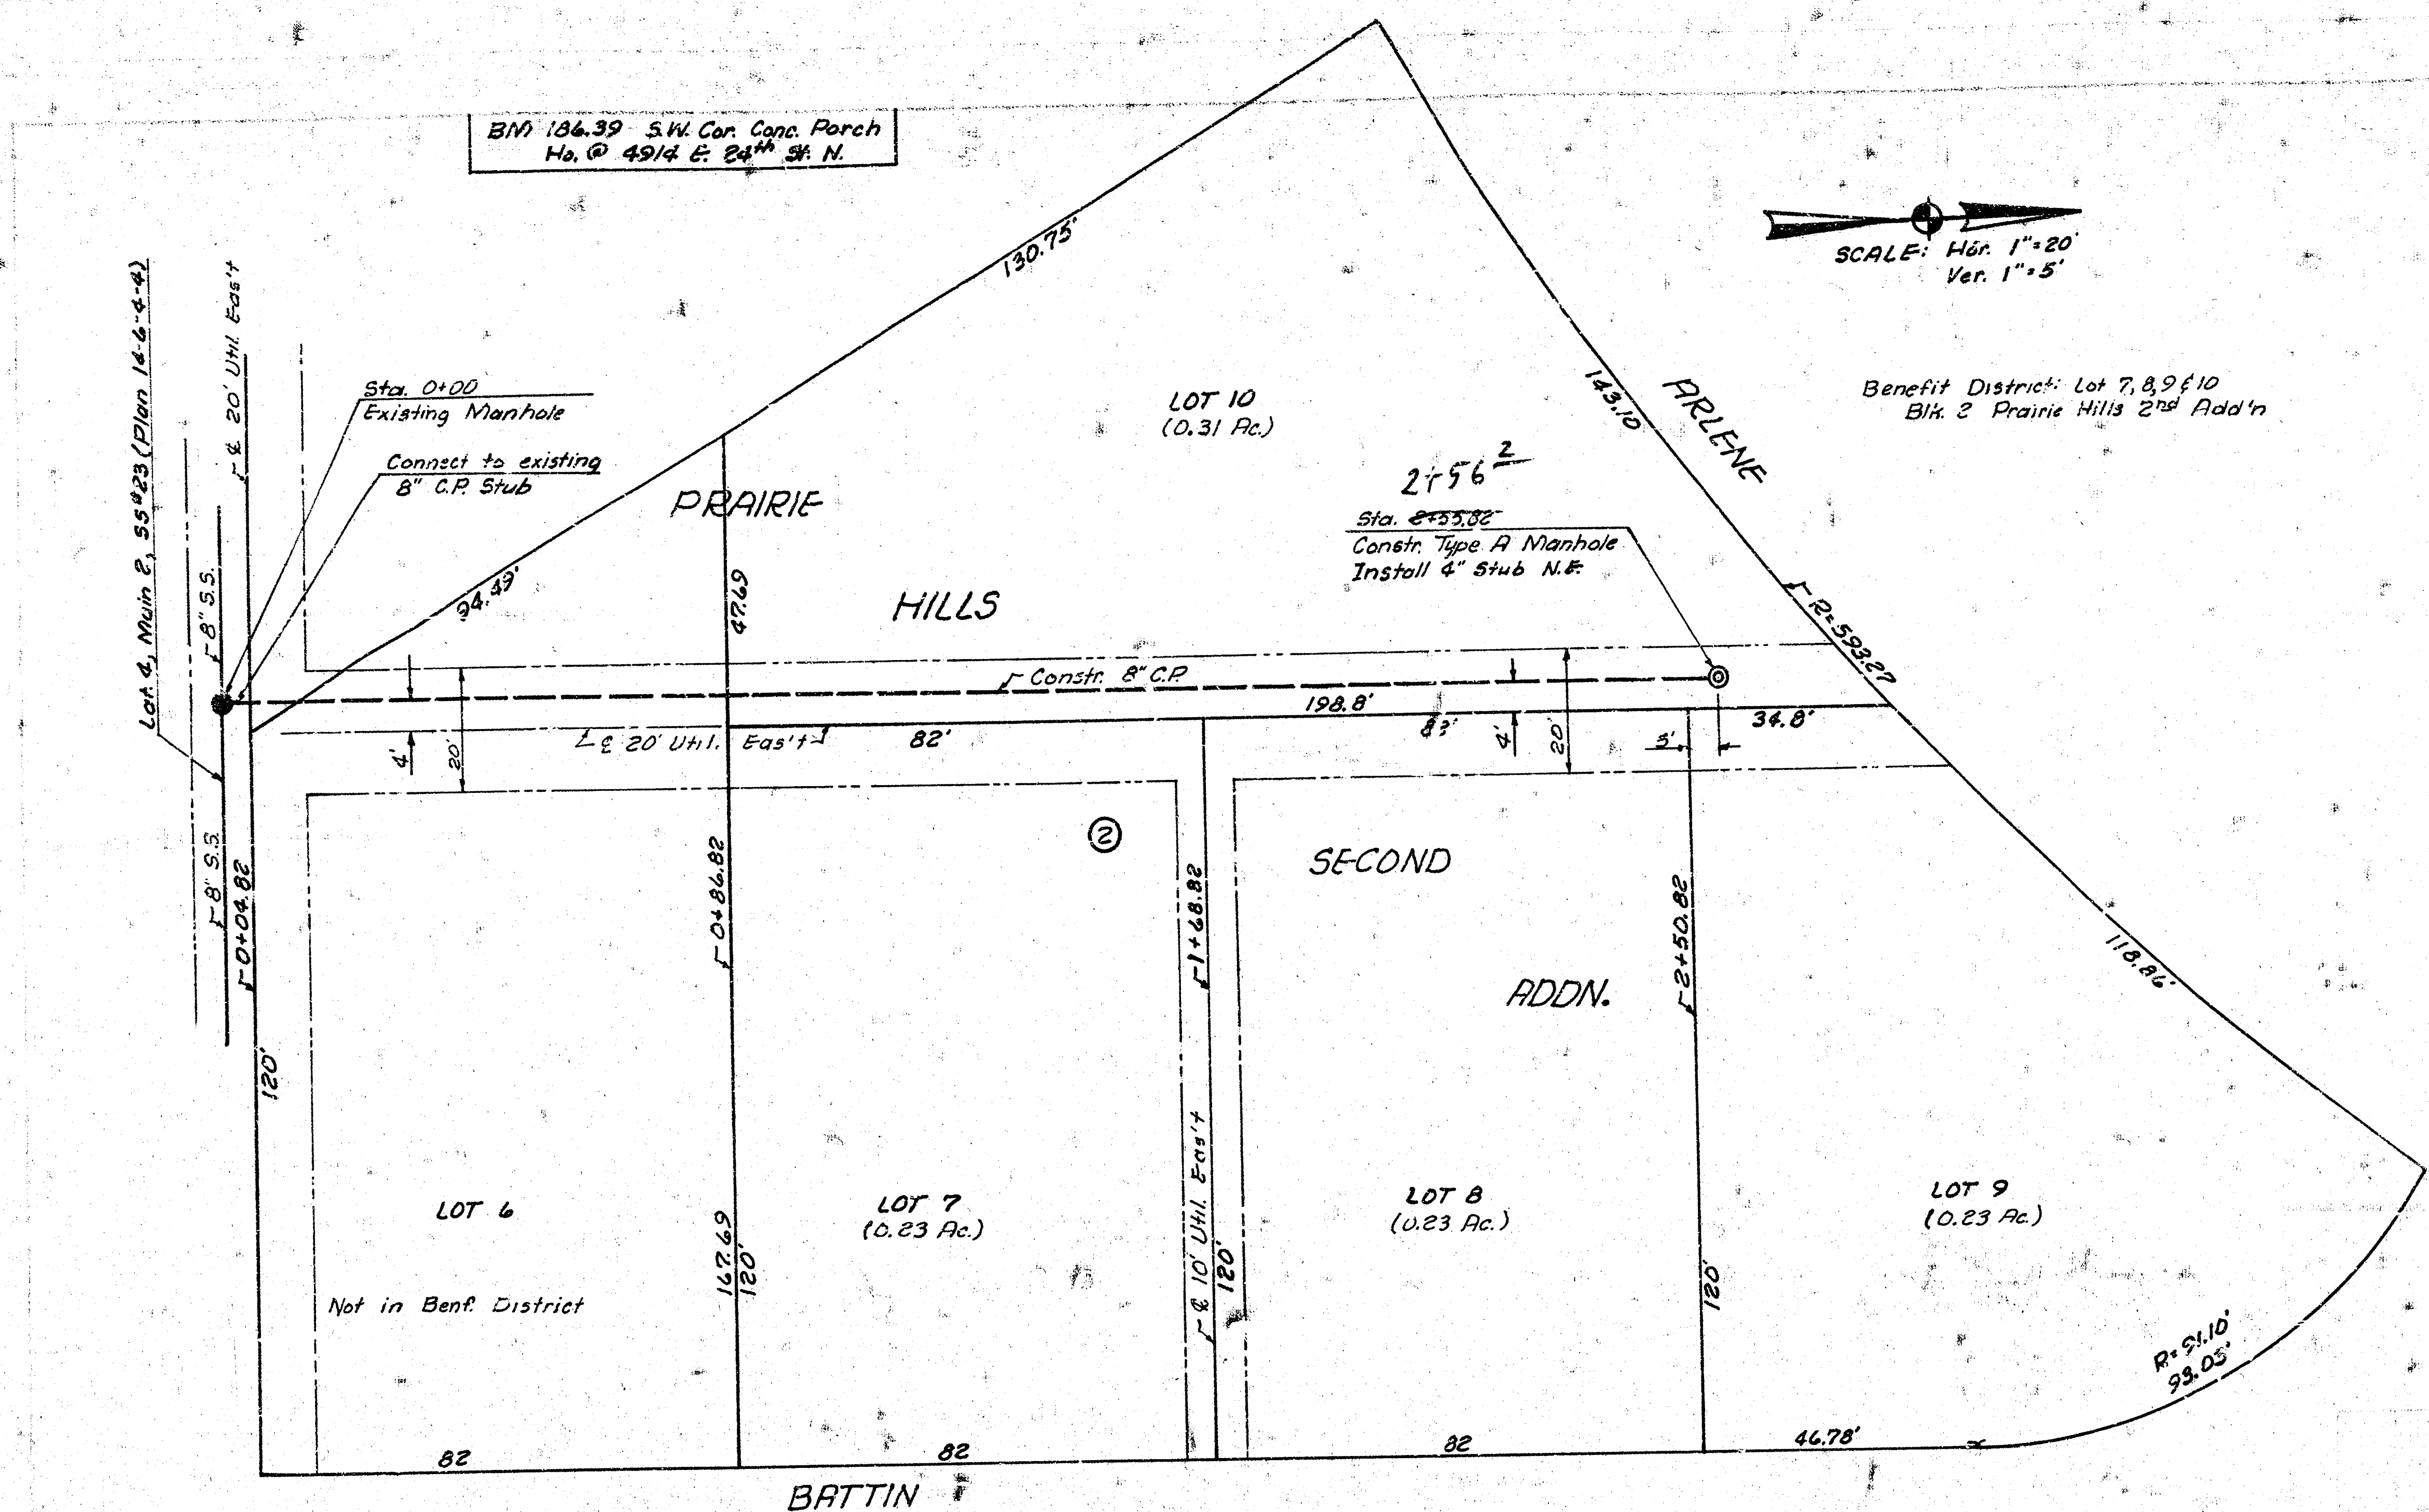


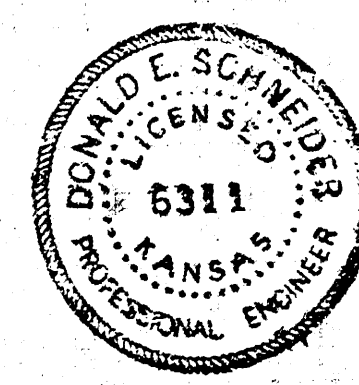

SCALE: Hor. 1"=20'
Ver. 1"=5'

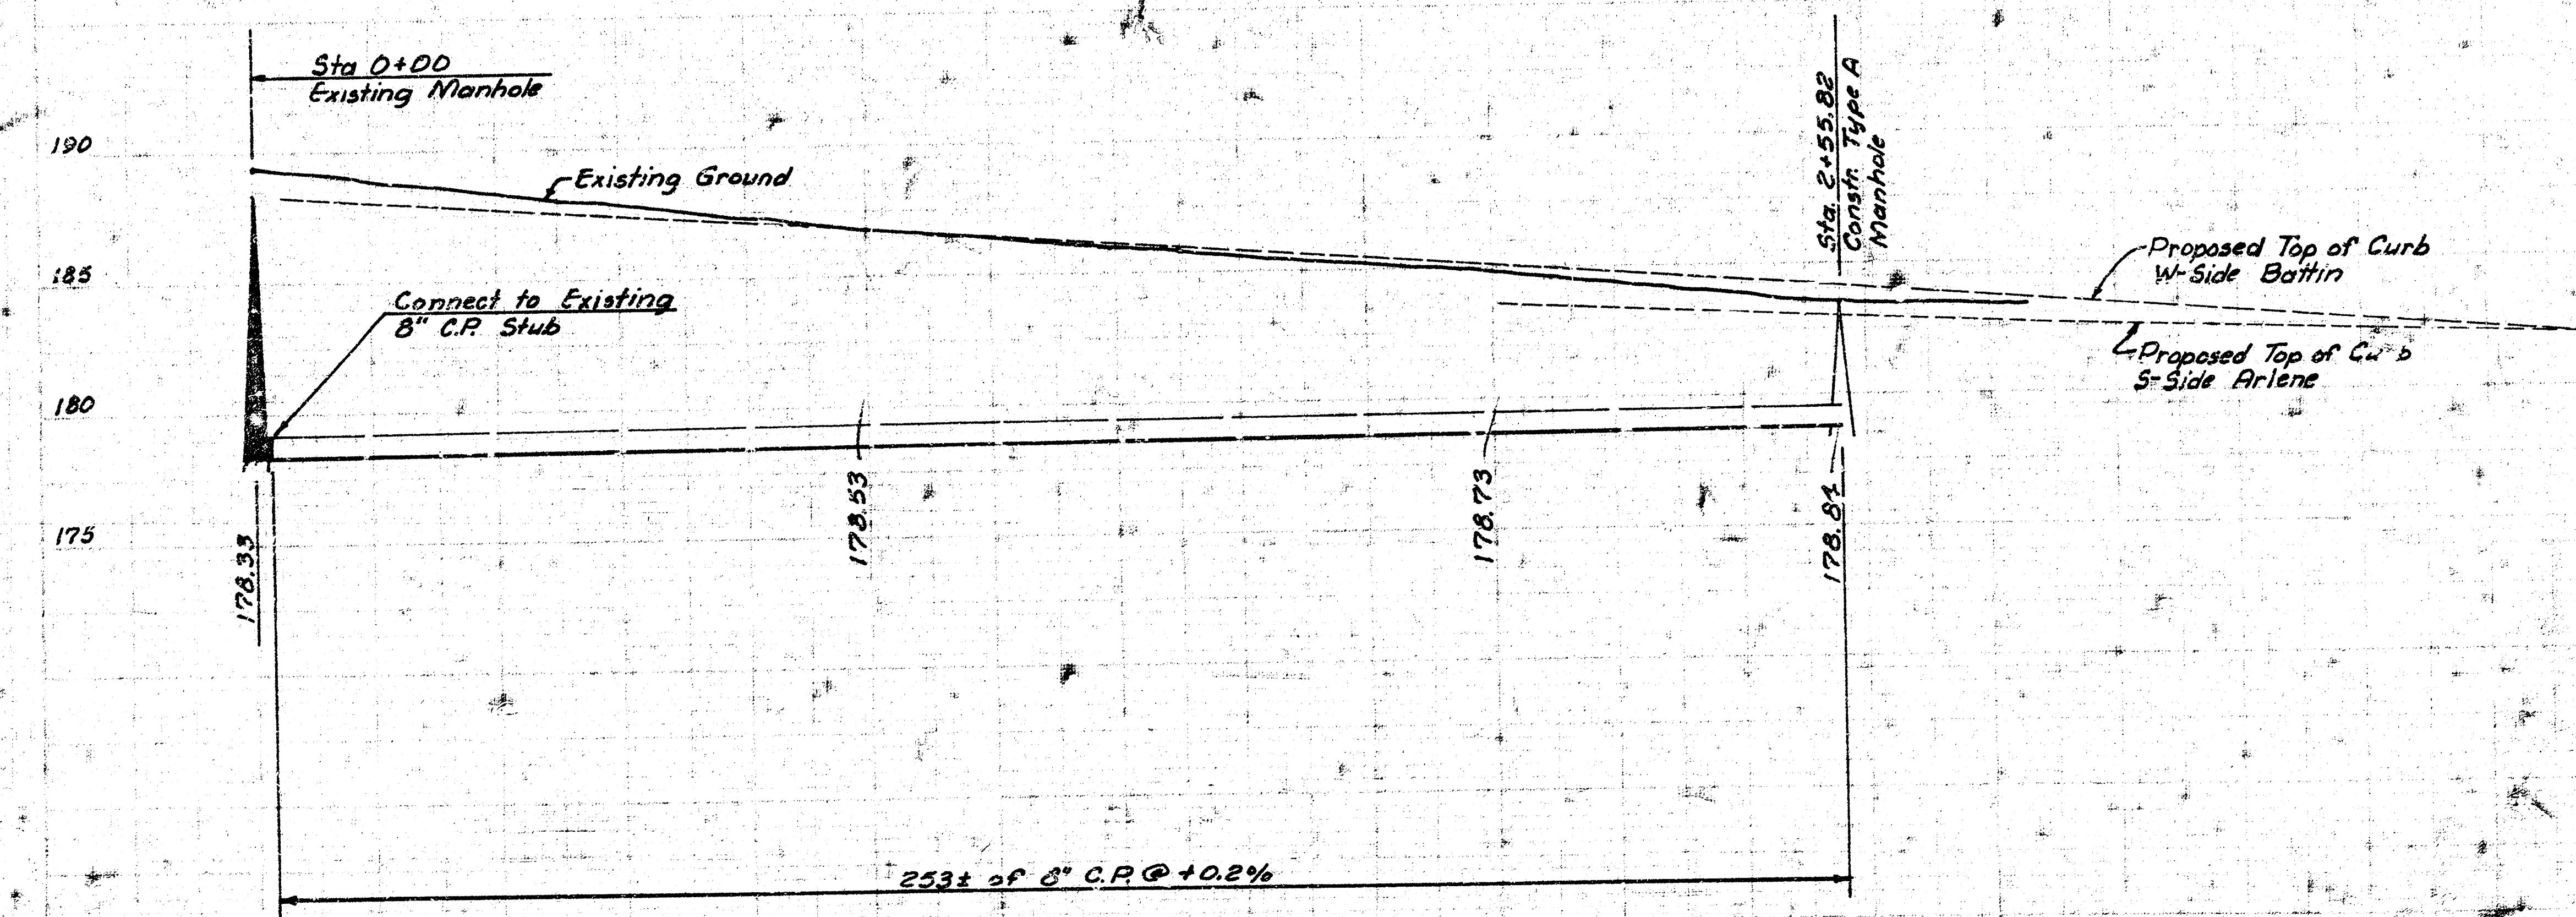

LAT. 16, MAIN 2, SANITARY SEWER 23
CITY OF WICHITA, KANSAS
R.W. LINN, CITY ENGINEER
DATE _____
Project No. DBKL 574060 Sheet 1 of 1