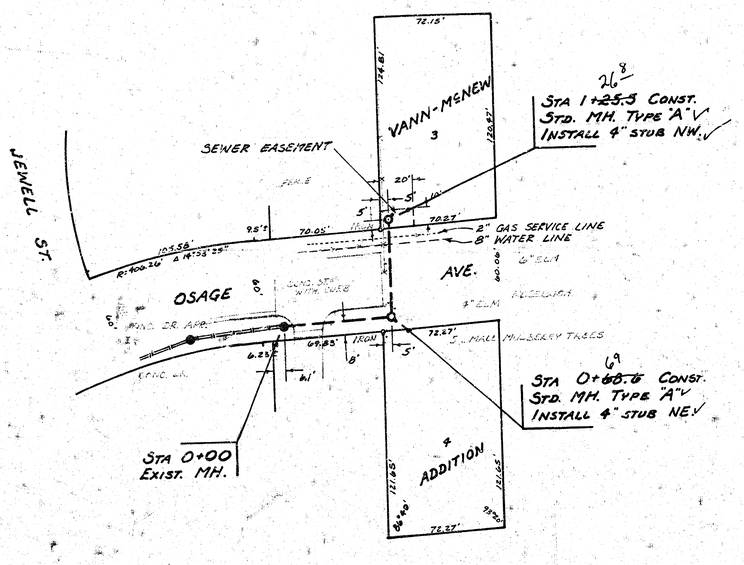

SCALE PLAN 1" = 40'
PROFILE 1" = 40' HORZ.
1" = 5' VERT.

THE CONTRACTOR SHALL BE RESPONSIBLE FOR PRESERVING PROPERTY IRONS. THE CONTRACTOR SHALL BE REQUIRED TO RE-ESTABLISH ANY PROPERTY IRONS WHICH ARE DAMAGED OR DESTROYED BY HIS CONSTRUCTION OPERATIONS. SUCH IRONS SHALL BE RE-ESTABLISHED BY A LICENSED LAND SURVEYOR OR A LICENSED PROFESSIONAL ENGINEER IN ACCORDANCE WITH STATE LAWS.

B.M. 101.63 SW. COR. CONC. PORCH, HO. # 2112 S. OSAGE.
B.M. 101.19 SW. COR. CONC. PORCH, HO. # 2132 S. OSAGE.
B.M. 99.66 "D" TOP CURB - NORTH RET. NW. COR. JEWELL AND OSAGE.

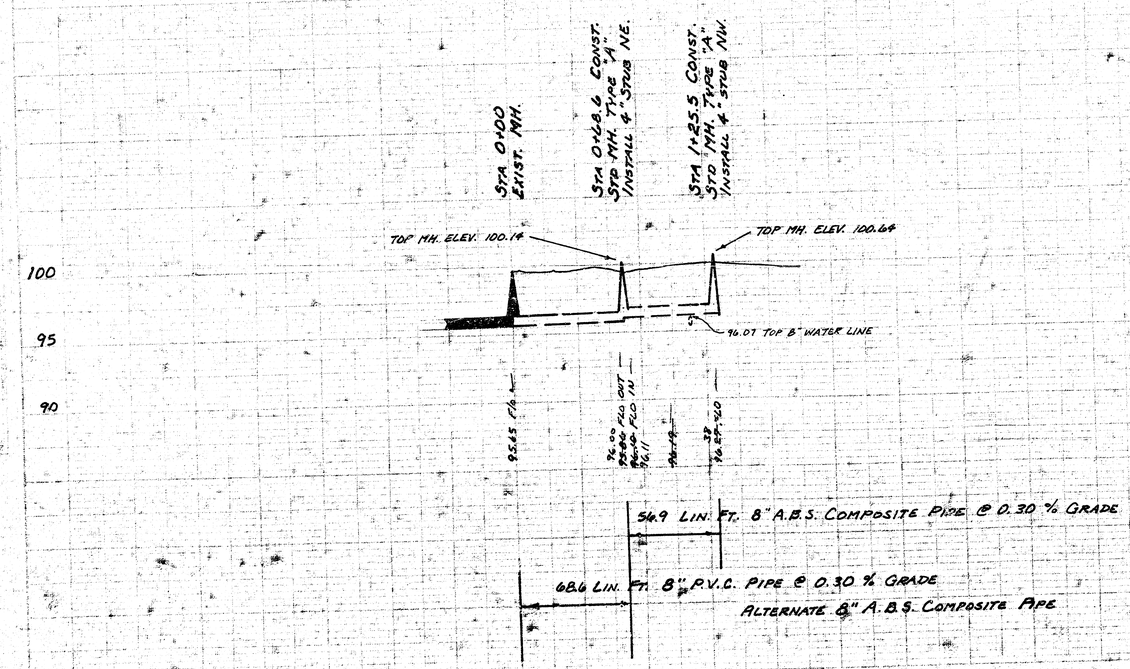

As Built
J.L.L.
4-23-82

DONALD E. SCHNEIDER
LICENSED
6311
KANSAS
PROFESSIONAL ENGINEER

LAT 47, MAIN 2, SAN. SEW. NO. 22
CITY OF WICHITA, KANSAS
R.W. BRUGGEMAN
DIRECTOR OF ENGINEERING - CITY ENGINEER
PROJ. NO. 468-76-245-80792-000-000-001

PLAN
DC 2/16