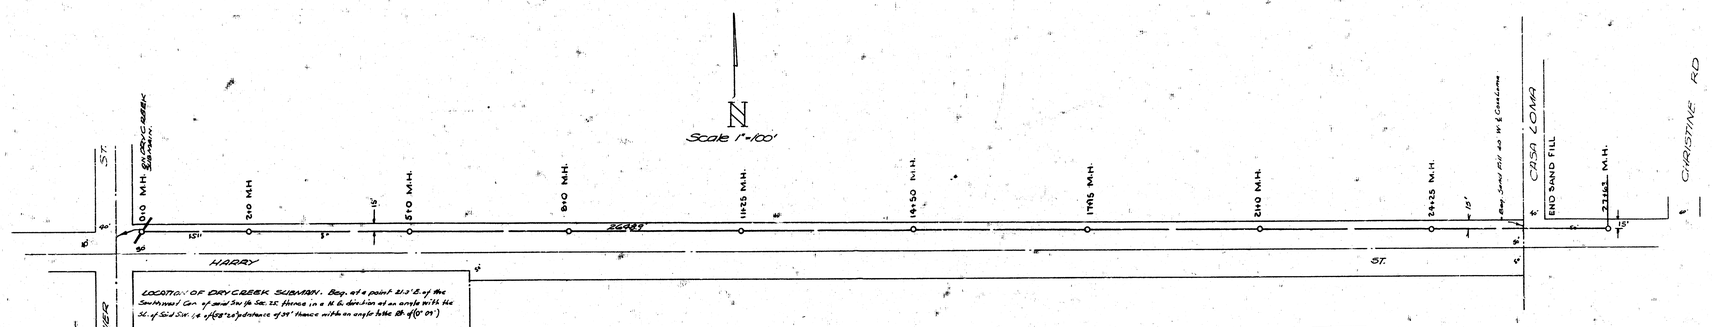

CONTRACT LINES FOR PURCELL'S 6TH
LINE 1 - STA. 0+10 - STA. 46+38
" 2 - STA. 0+10 - STA. 20+10
" 2A - STA. 0+10 - STA. 01+80
" 3 - STA. 0+10 - STA. 81+08
" 4 - STA. 0+10 - STA. 64+50
" 5 - STA. 0+10 - STA. 49+64
" 5-0 - STA. 0+10 - STA. 45+03

CONTRACT LINES FOR PURCELL'S 5TH.
LINE 1 - STA. 96+65 - STA. 52+87
LINE 2 - STA. 20+10 - STA. 29+69
LINE 2B - STA. 0+10 - STA. 01+80

DETAIL FOR TRENCH BACKFILL OVER 21" LINER

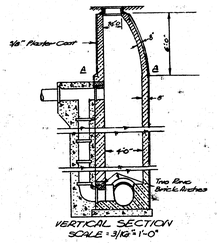

VERTICAL SECTION
SCALE: 3/16"=1'-0"

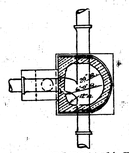
HORIZONTAL SECTION
A-A

DETAIL OF SPECIAL MANHOLE

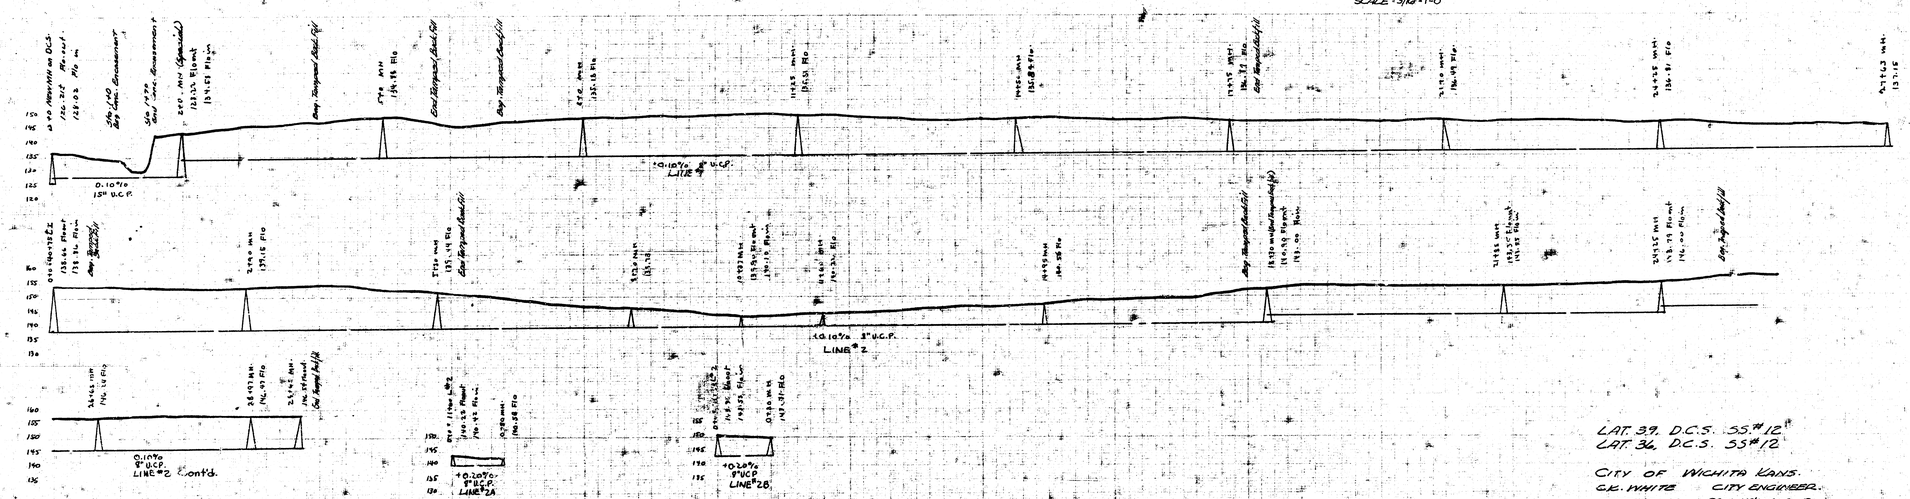


CITY OF WICHITA KANS.
C.R. WHITE CITY ENGINEER.
DATE 7-13-49 PROJ NOS C29-19 C29-31




SCALE 1"=100'

N