


STA. 0+00.00 LINE 1  
 BL STA. -0+94.82 97.32' LT.  
 INSTALL 24" END SECTION  
 FL=1327.08  
 PLACE 16 S.Y. EROSION MAT  
 (ARMOR FLEX) SEE SHEET C19

STA. 0+42.34 LINE 1  
 BL STA. -0+59.24 120.28' LT.  
 INSTALL 24" END SECTION  
 FL=1327.98  
 PLACE 20 S.Y. EROSION MAT  
 (ARMOR FLEX) SEE SHEET C19


STA. 0+00.00 LINE 2  
 BL STA. 0+20.13 172.58' RT.  
 INSTALL 24" END SECTION  
 FL=1332.32  
 PLACE 20 S.Y. EROSION MAT  
 (ARMOR FLEX) SEE SHEET C19

STA. 0+50.26 LINE 2  
 BL STA. 0+62.37 199.84' RT.  
 INSTALL 24" END SECTION  
 FL=1333.32  
 PLACE 20 S.Y. EROSION MAT  
 (ARMOR FLEX) SEE SHEET C19

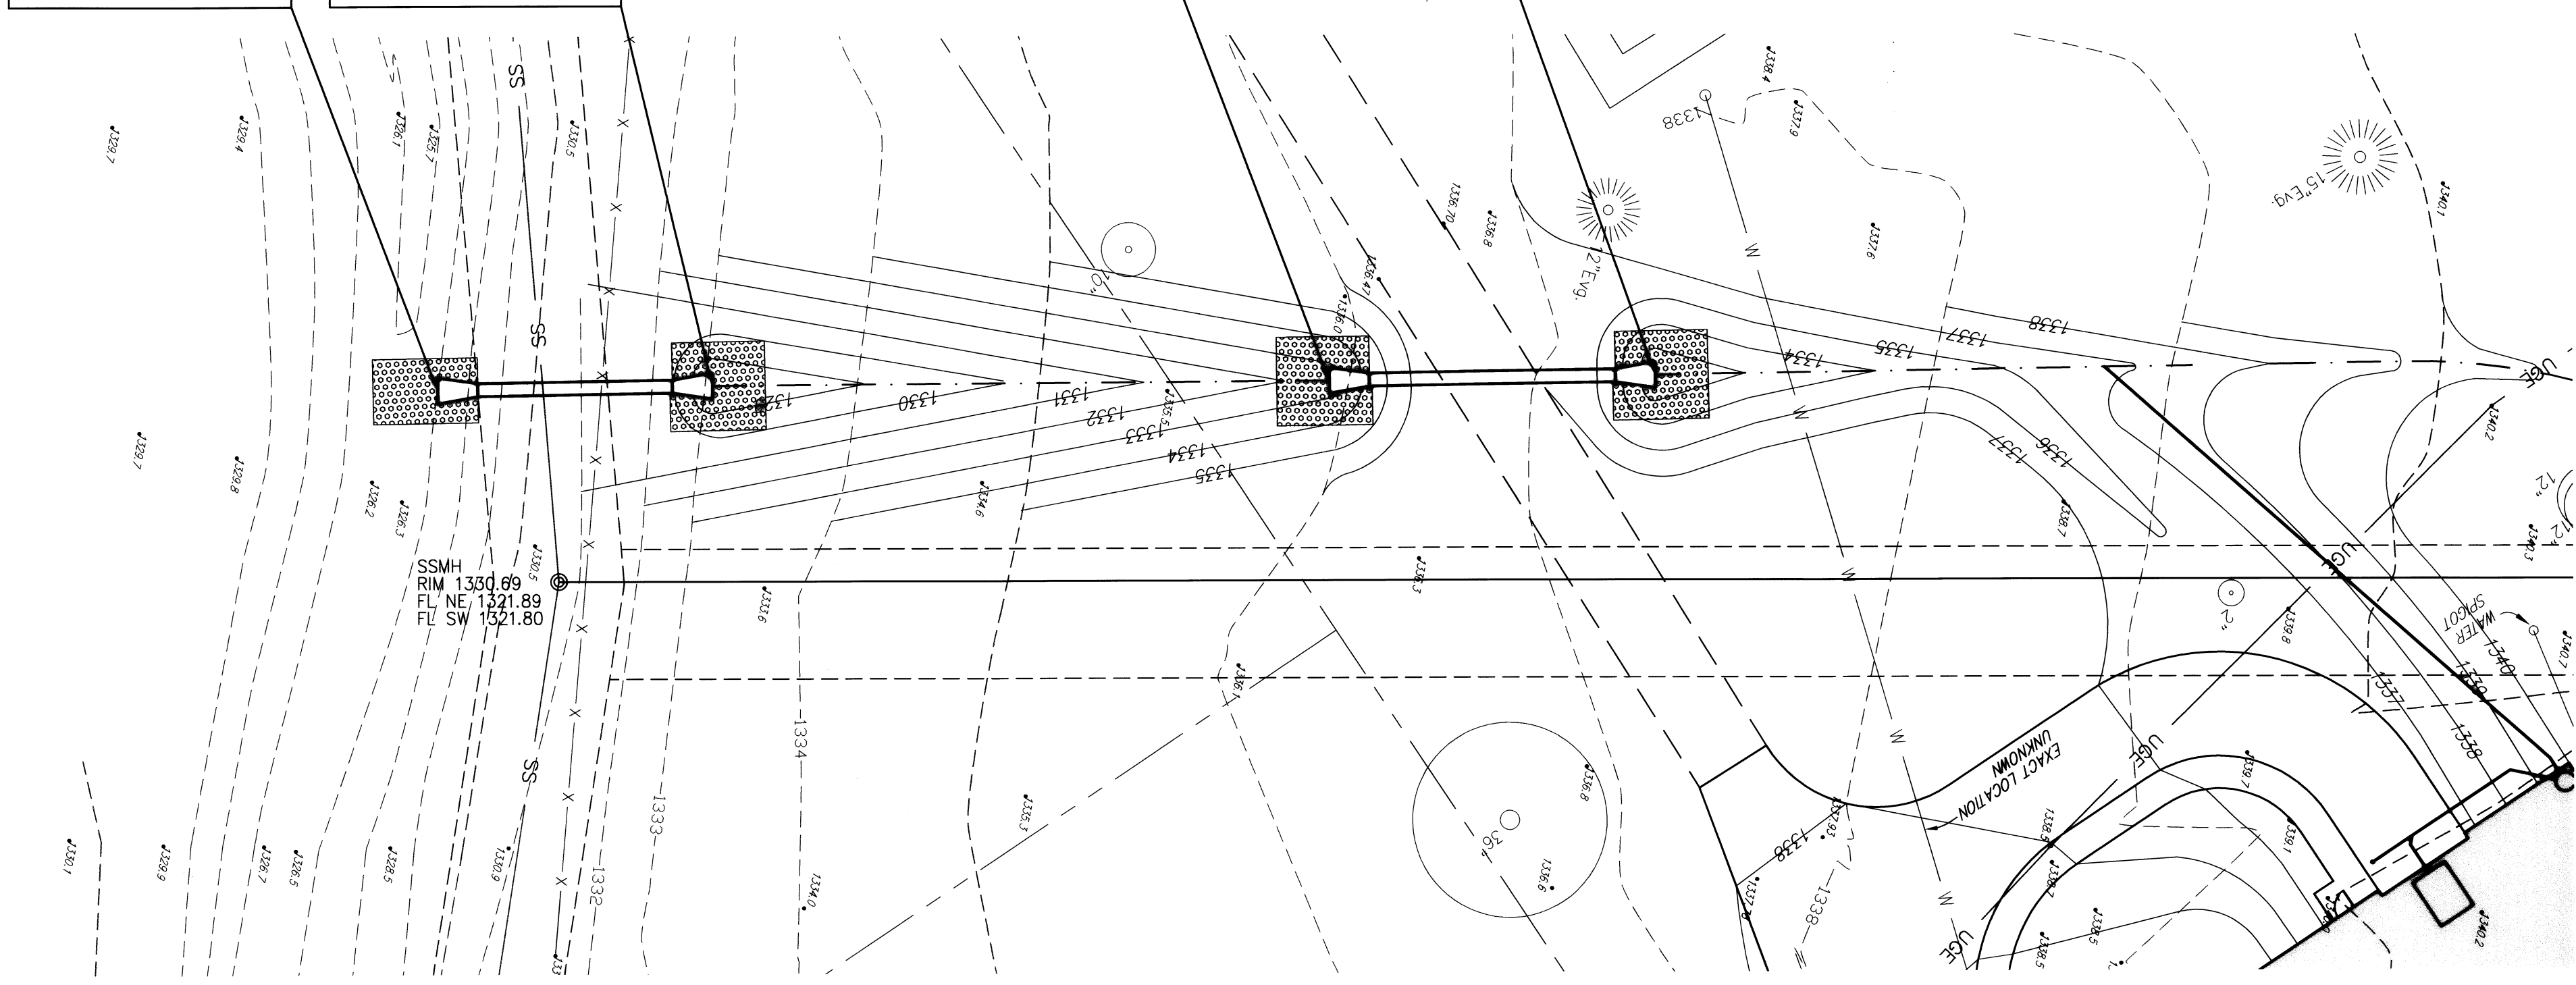

LINE 1

LINE 2

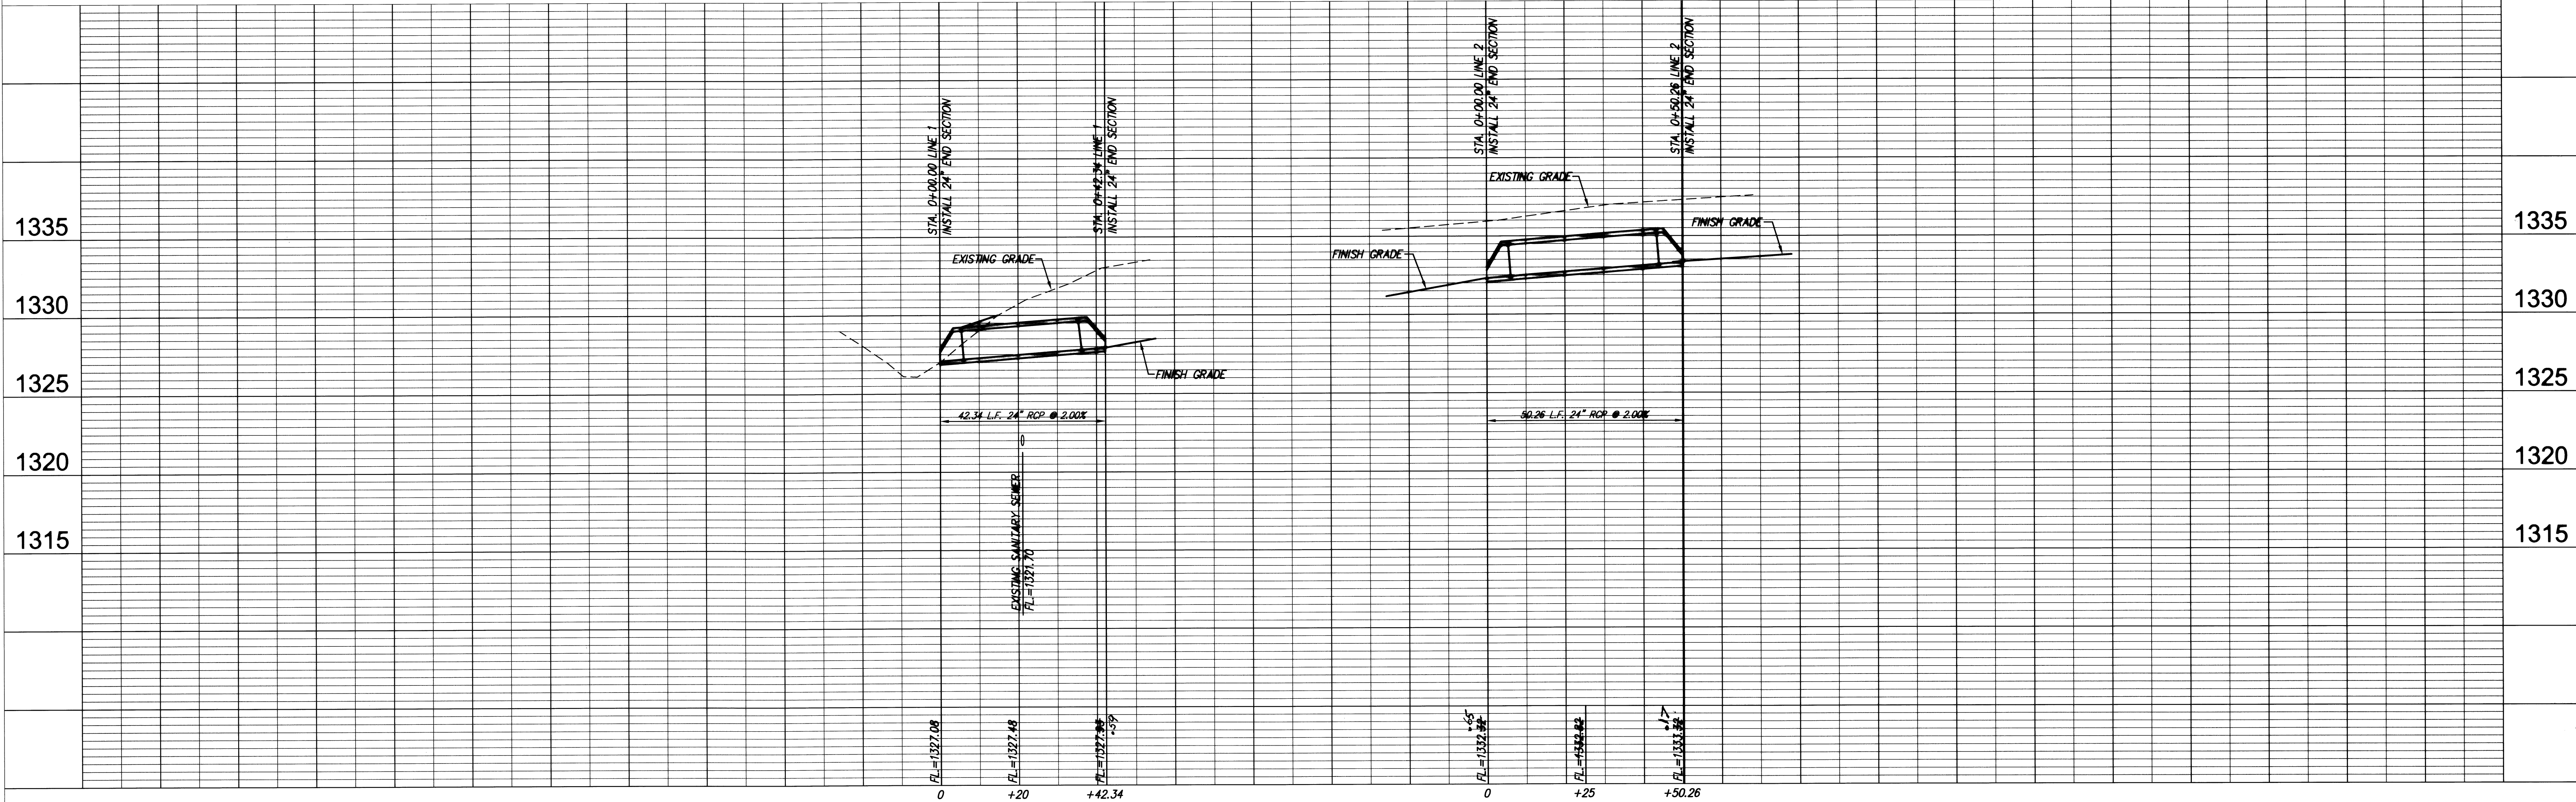

PROJECT NUMBER <b>1796</b> DRAWING FILE <b>ENGINEERING BASE (Water)</b>	DESIGN <b>TCR</b> UTILITY	DRAWN <b>EGB</b> DATE <b>July 30, 2007</b>	REVISED REVIEW
	LOT 1, BLK 1, SISTERS OF ST. JOSEPHS 2ND STORM SEWER PLAN & PROFILE WICHITA, KANSAS		
RB JOB <b>30555</b> SHEET <b>4</b> OF <b>7</b>			
